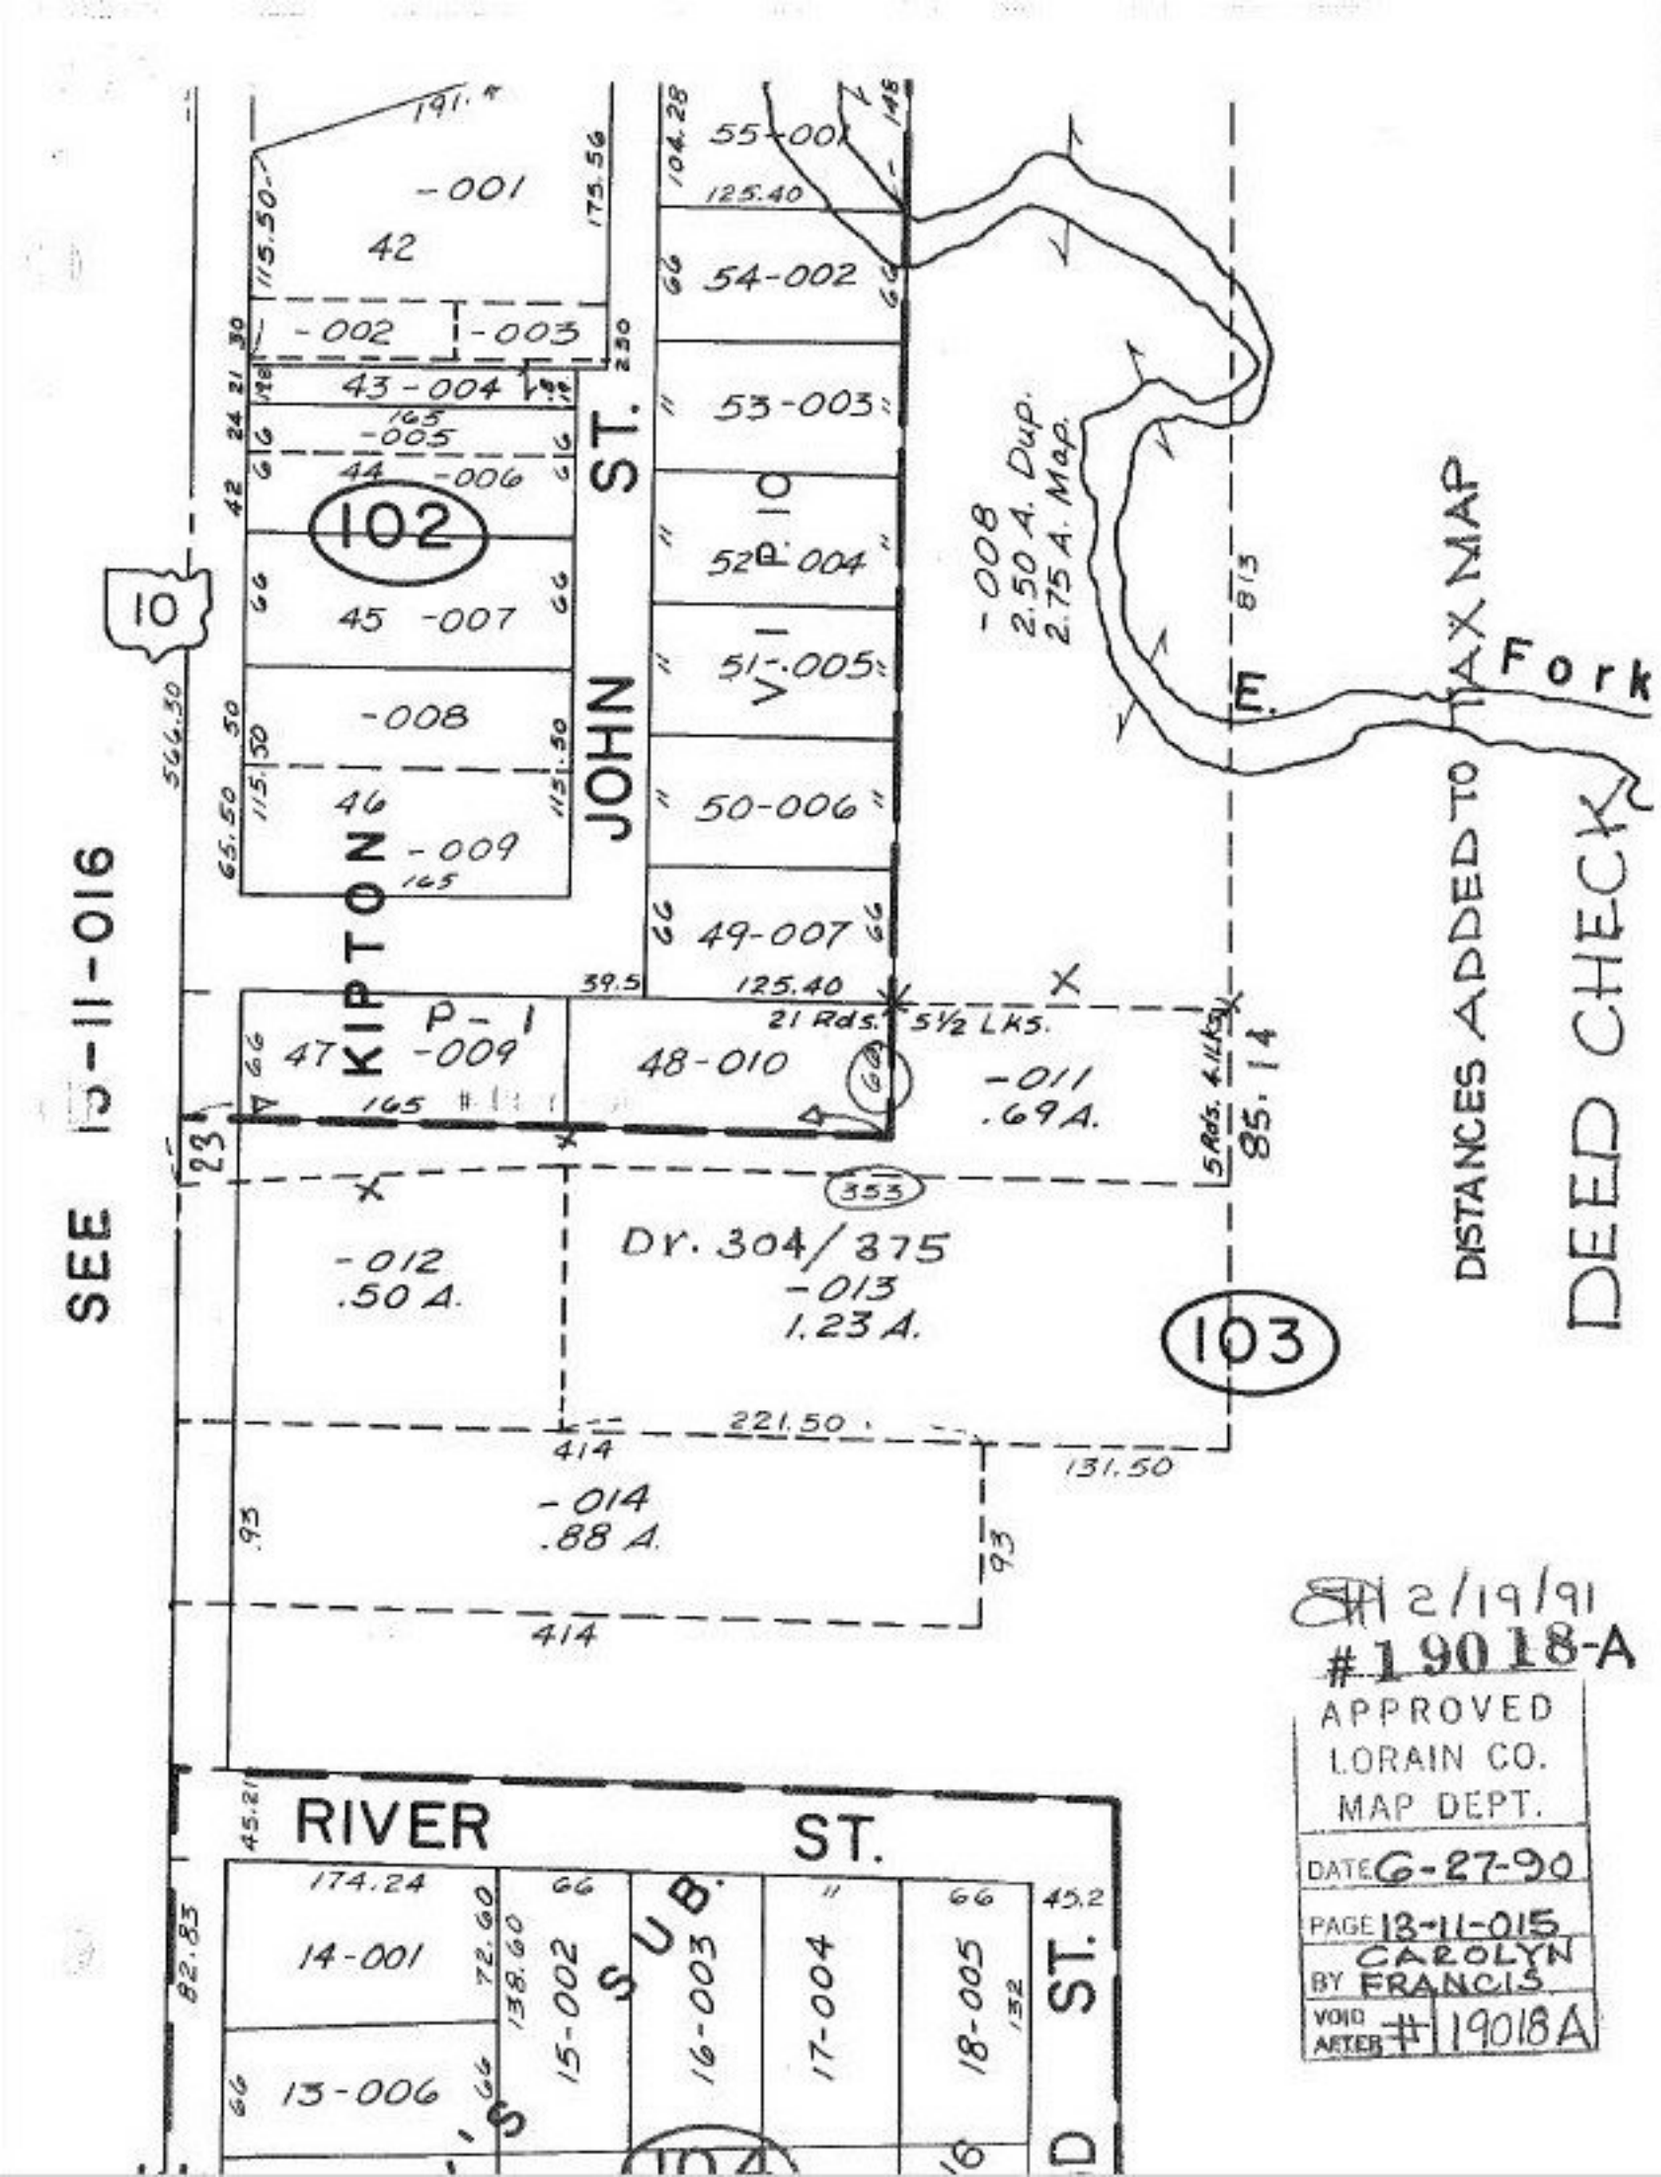

2/19/91
#19018-A

APPROVED
LORAIN CO.
MAP DEPT.

DATE 6-27-90

PAGE 13-11-015

BY CAROLYN FRANCIS

VOID AFTER # 19018A