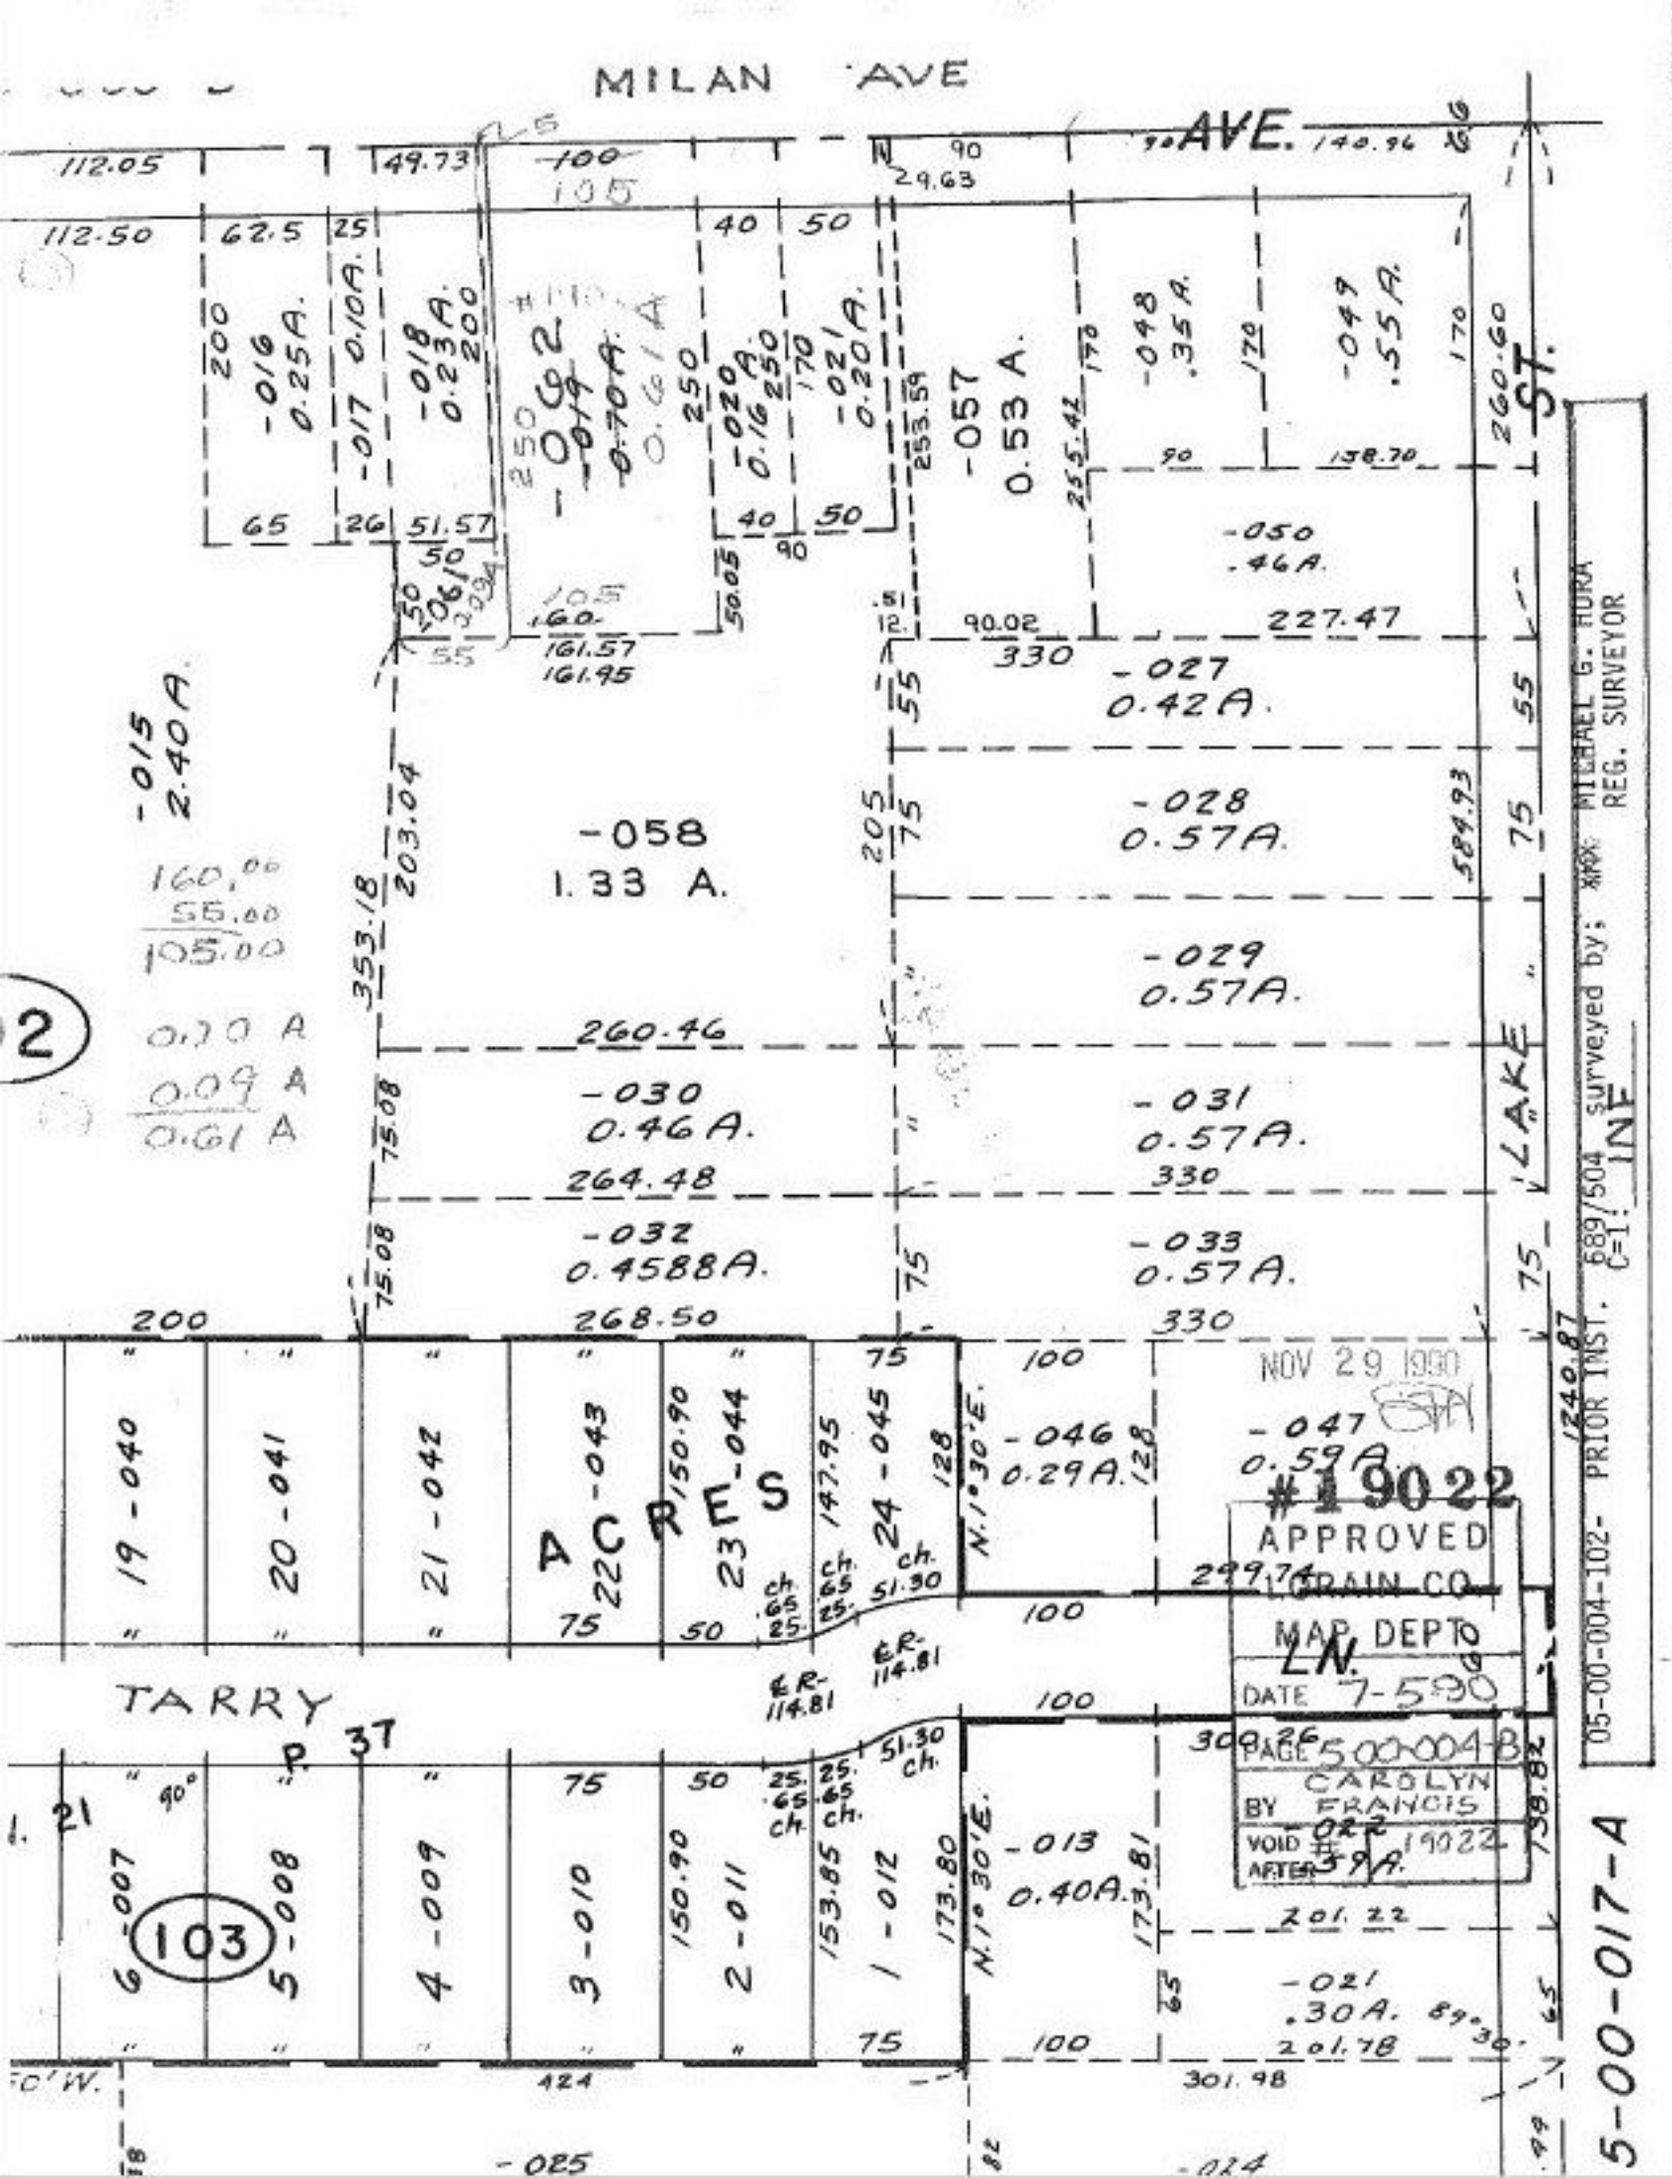
MILAN AVE
AVE.
ST.
LAKE
LINE
TARRY
-015 2.40A.
-058 1.33 A.
-057 0.53 A.
-027 0.42A.
-028 0.57A.
-029 0.57A.
-030 0.46A.
-031 0.57A.
-032 0.4588A.
-033 0.57A.
-046 0.29A.
-047 0.59A.
-013 0.40A.
-021 .30A.
-050 .46A.
-048 .35A.
-049 .55A.
-016 0.25A.
-017 0.10A.
-018 0.23A.
-020 0.16A.
-021 0.20A.
-062 0.70A.
-061 0.61A
19-040
20-041
21-042
22-043
23-044
24-045
1-012
2-011
3-010
4-009
5-008
6-007
103
#19022
APPROVED
MAP DEPT.
PAGE 500-004-B
BY CAROLYN FRANCIS
5-00-017-A
05-00-004-102- PRIOR INST. 689/504 surveyed by; MICHAEL G. HURA REG. SURVEYOR