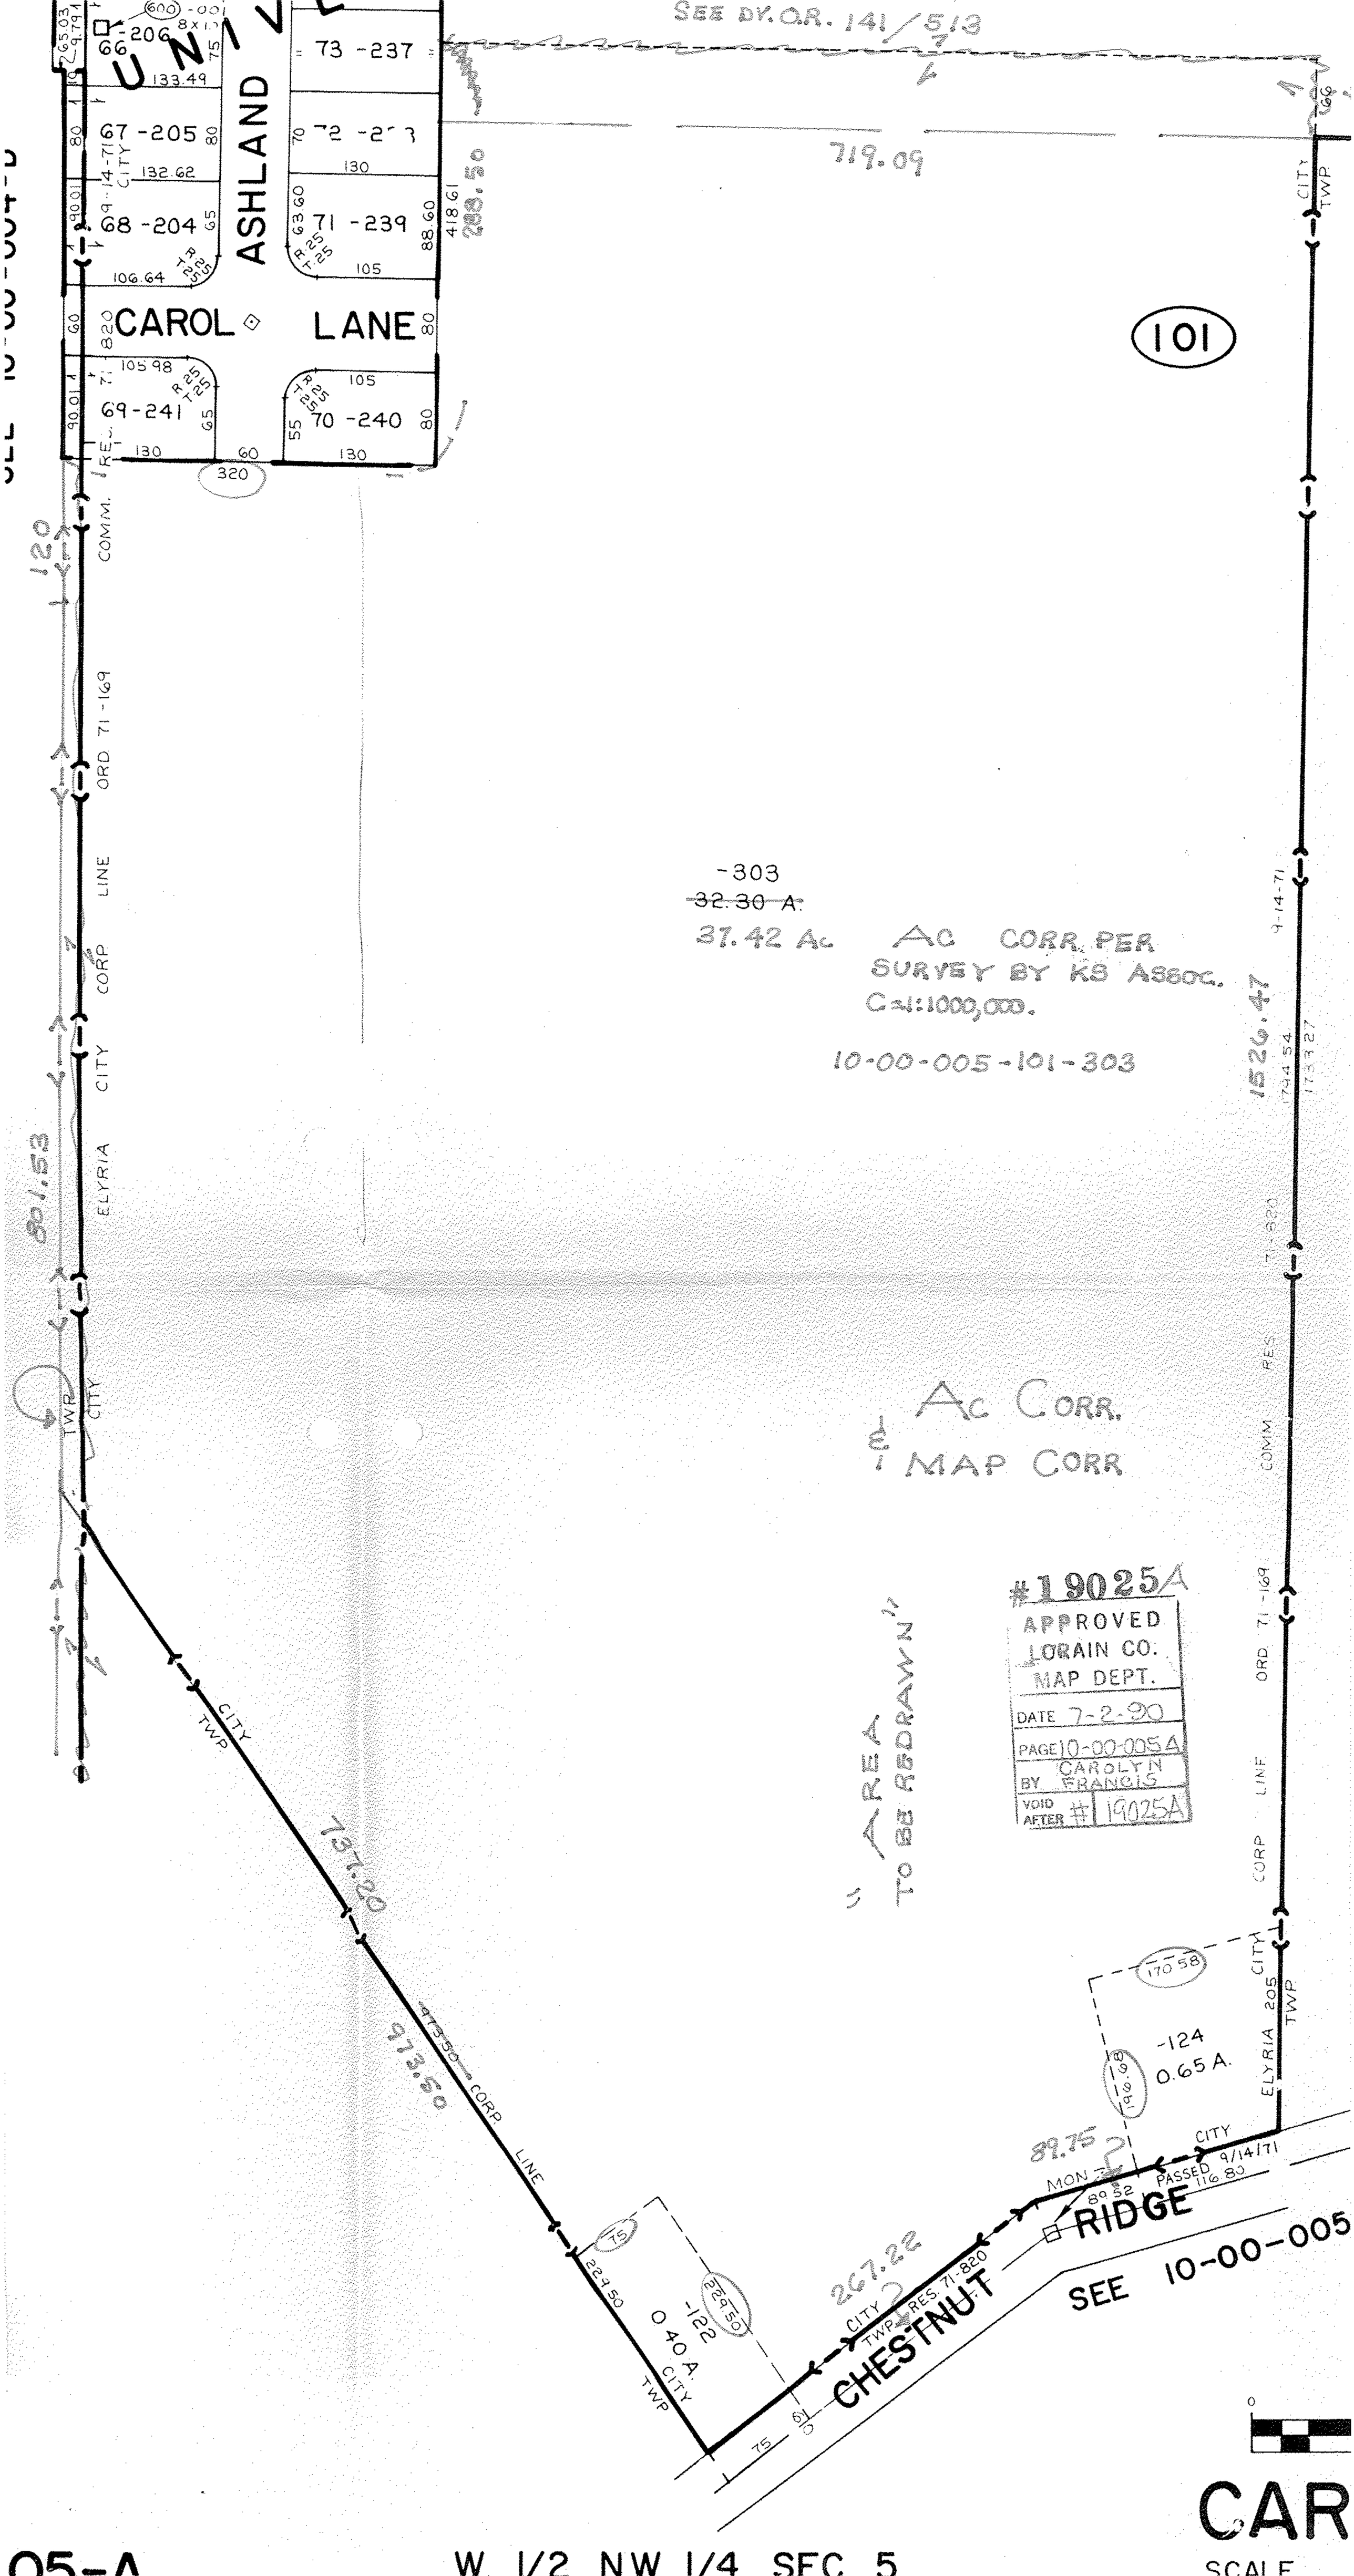

05-A W 1/2 NW 1/4 SEC. 5