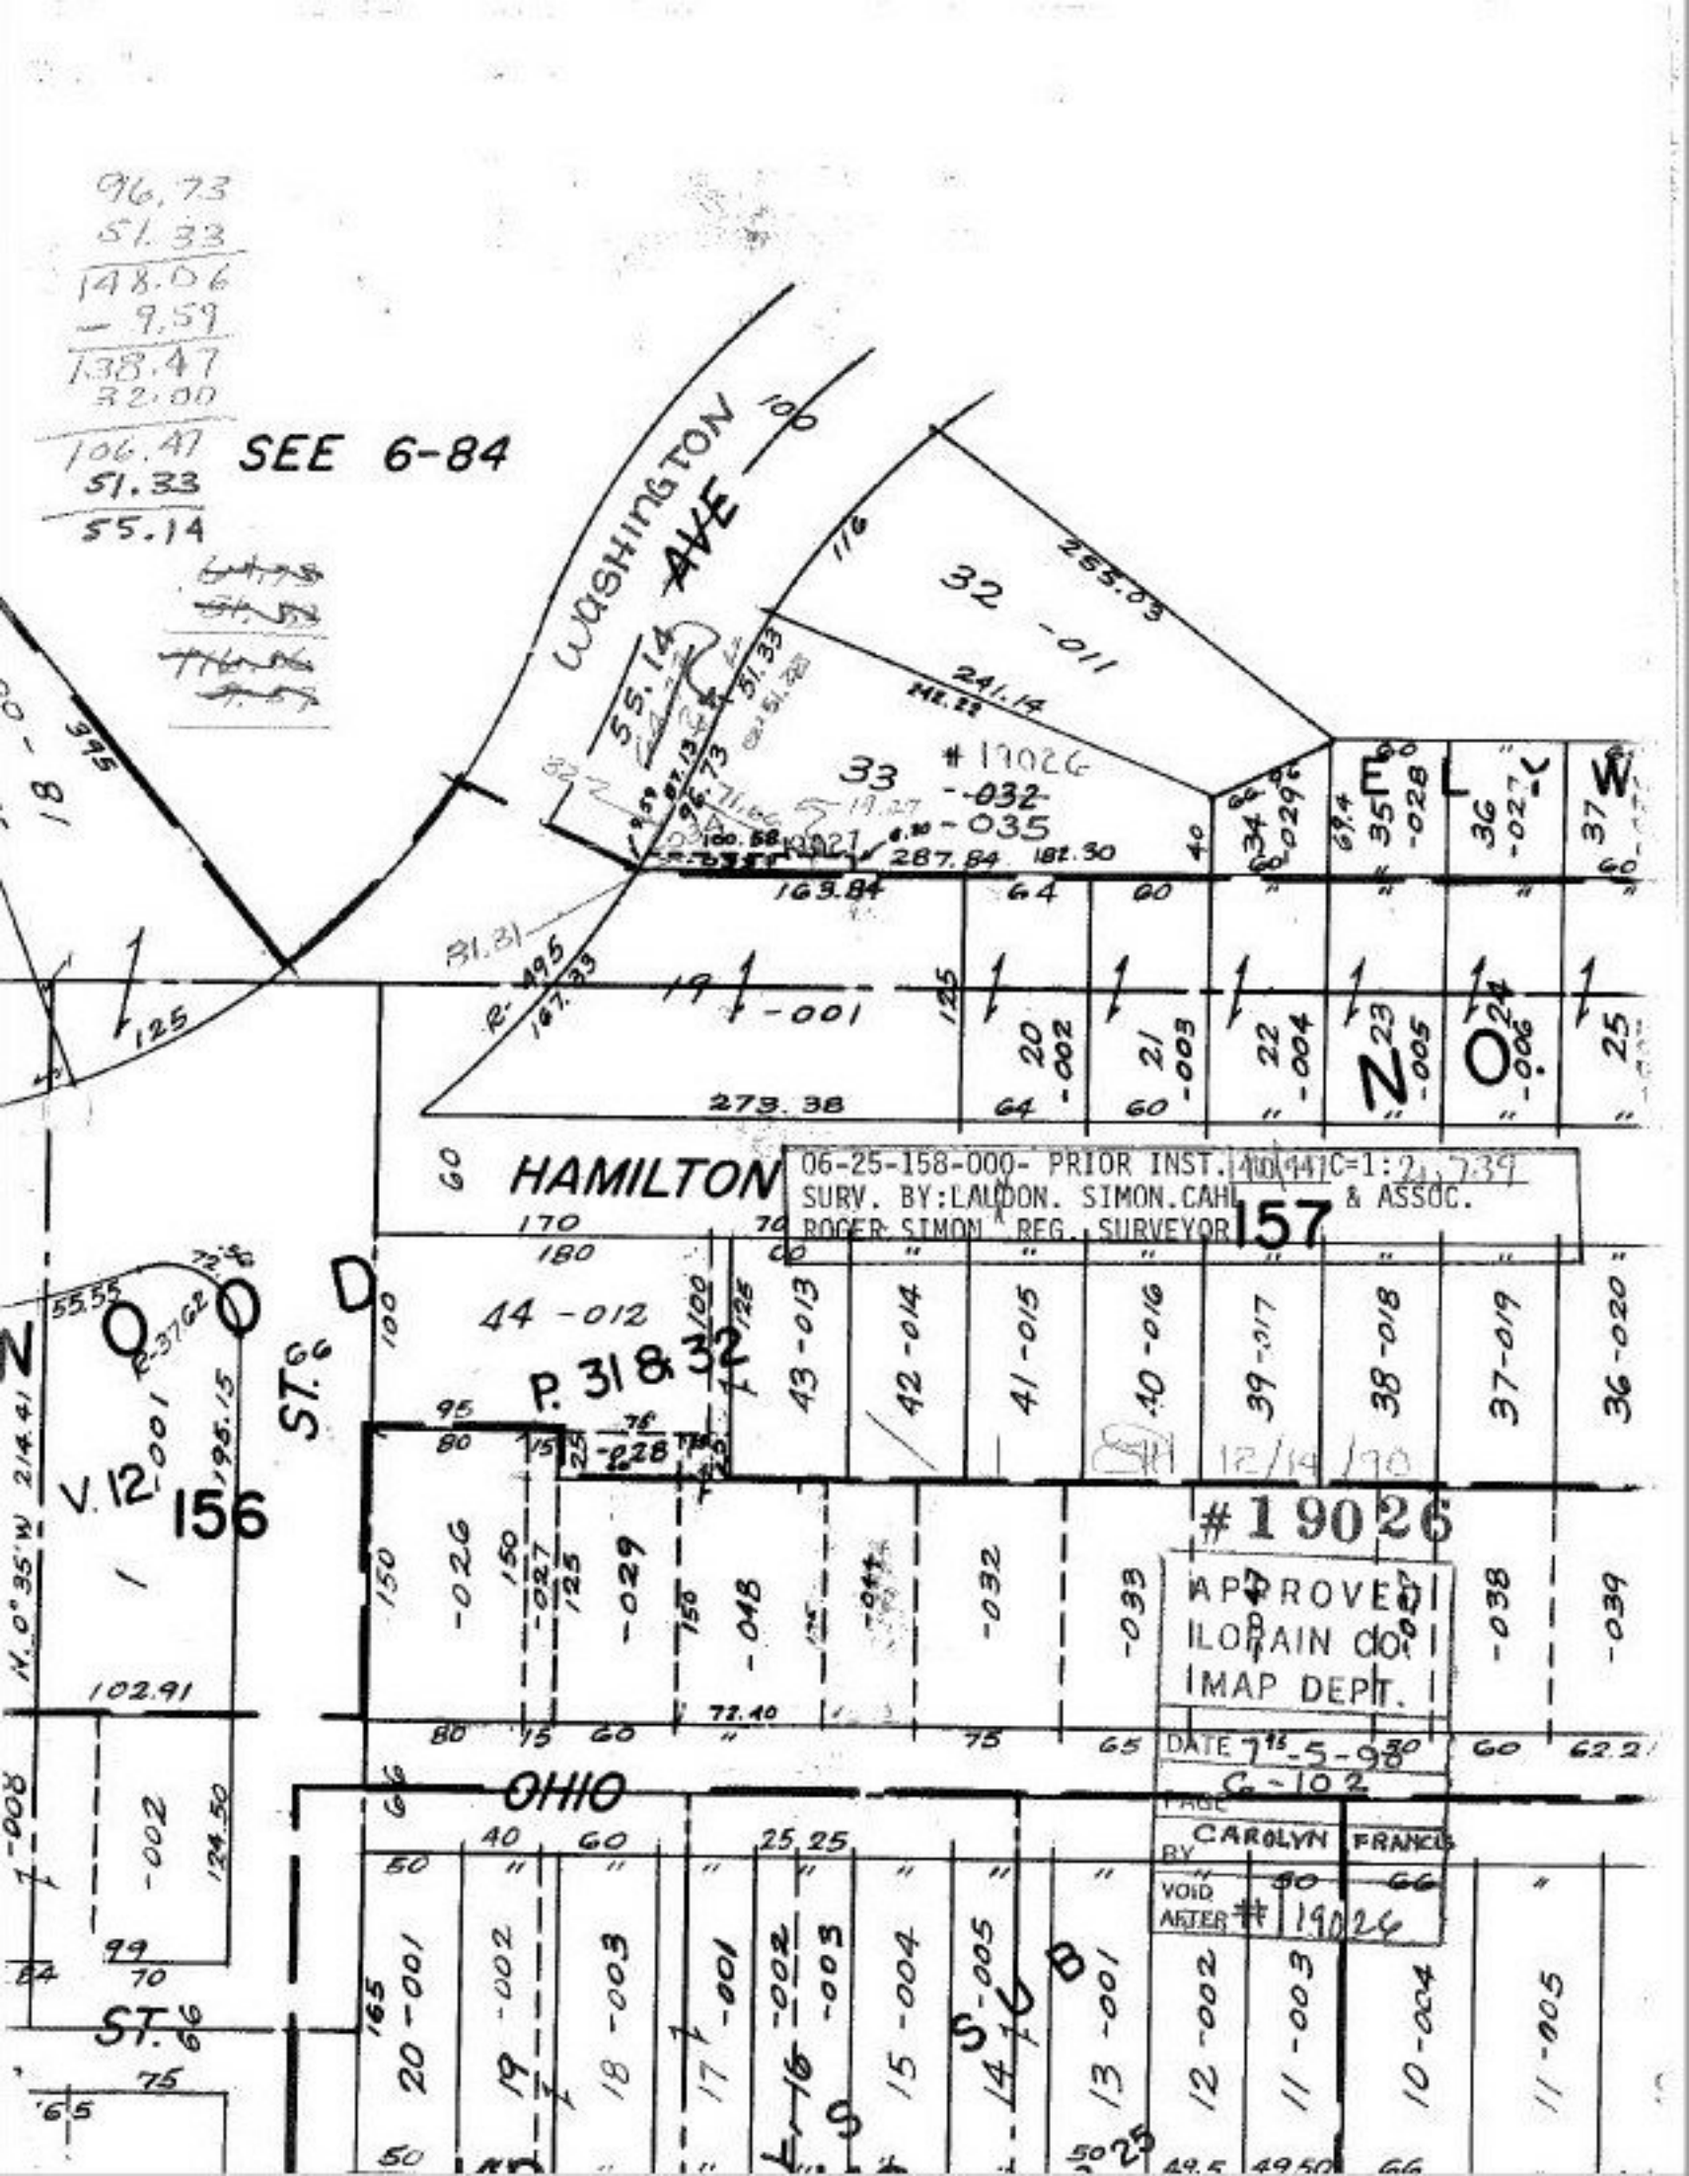
96.73
51.33
148.06
- 9.59
138.47
32.00
106.47
51.33
55.14
SEE 6-84
WASHINGTON AVE
32 -011
33
#19026
-032
-035
HAMILTON
06-25-158-000- PRIOR INST. C=1:
SURV. BY:LAUDON. SIMON.CAHL & ASSOC.
ROGER SIMON REG. SURVEYOR
157
44 -012
P. 31 & 32
ST. 66
V. 12
156
#19026
APPROVED
LORAIN CO.
MAP DEPT.
DATE 7-5-98
C-102
PAGE
BY CAROLYN FRANCIS
VOID AFTER #19026
OHIO
ST. 66
SUB