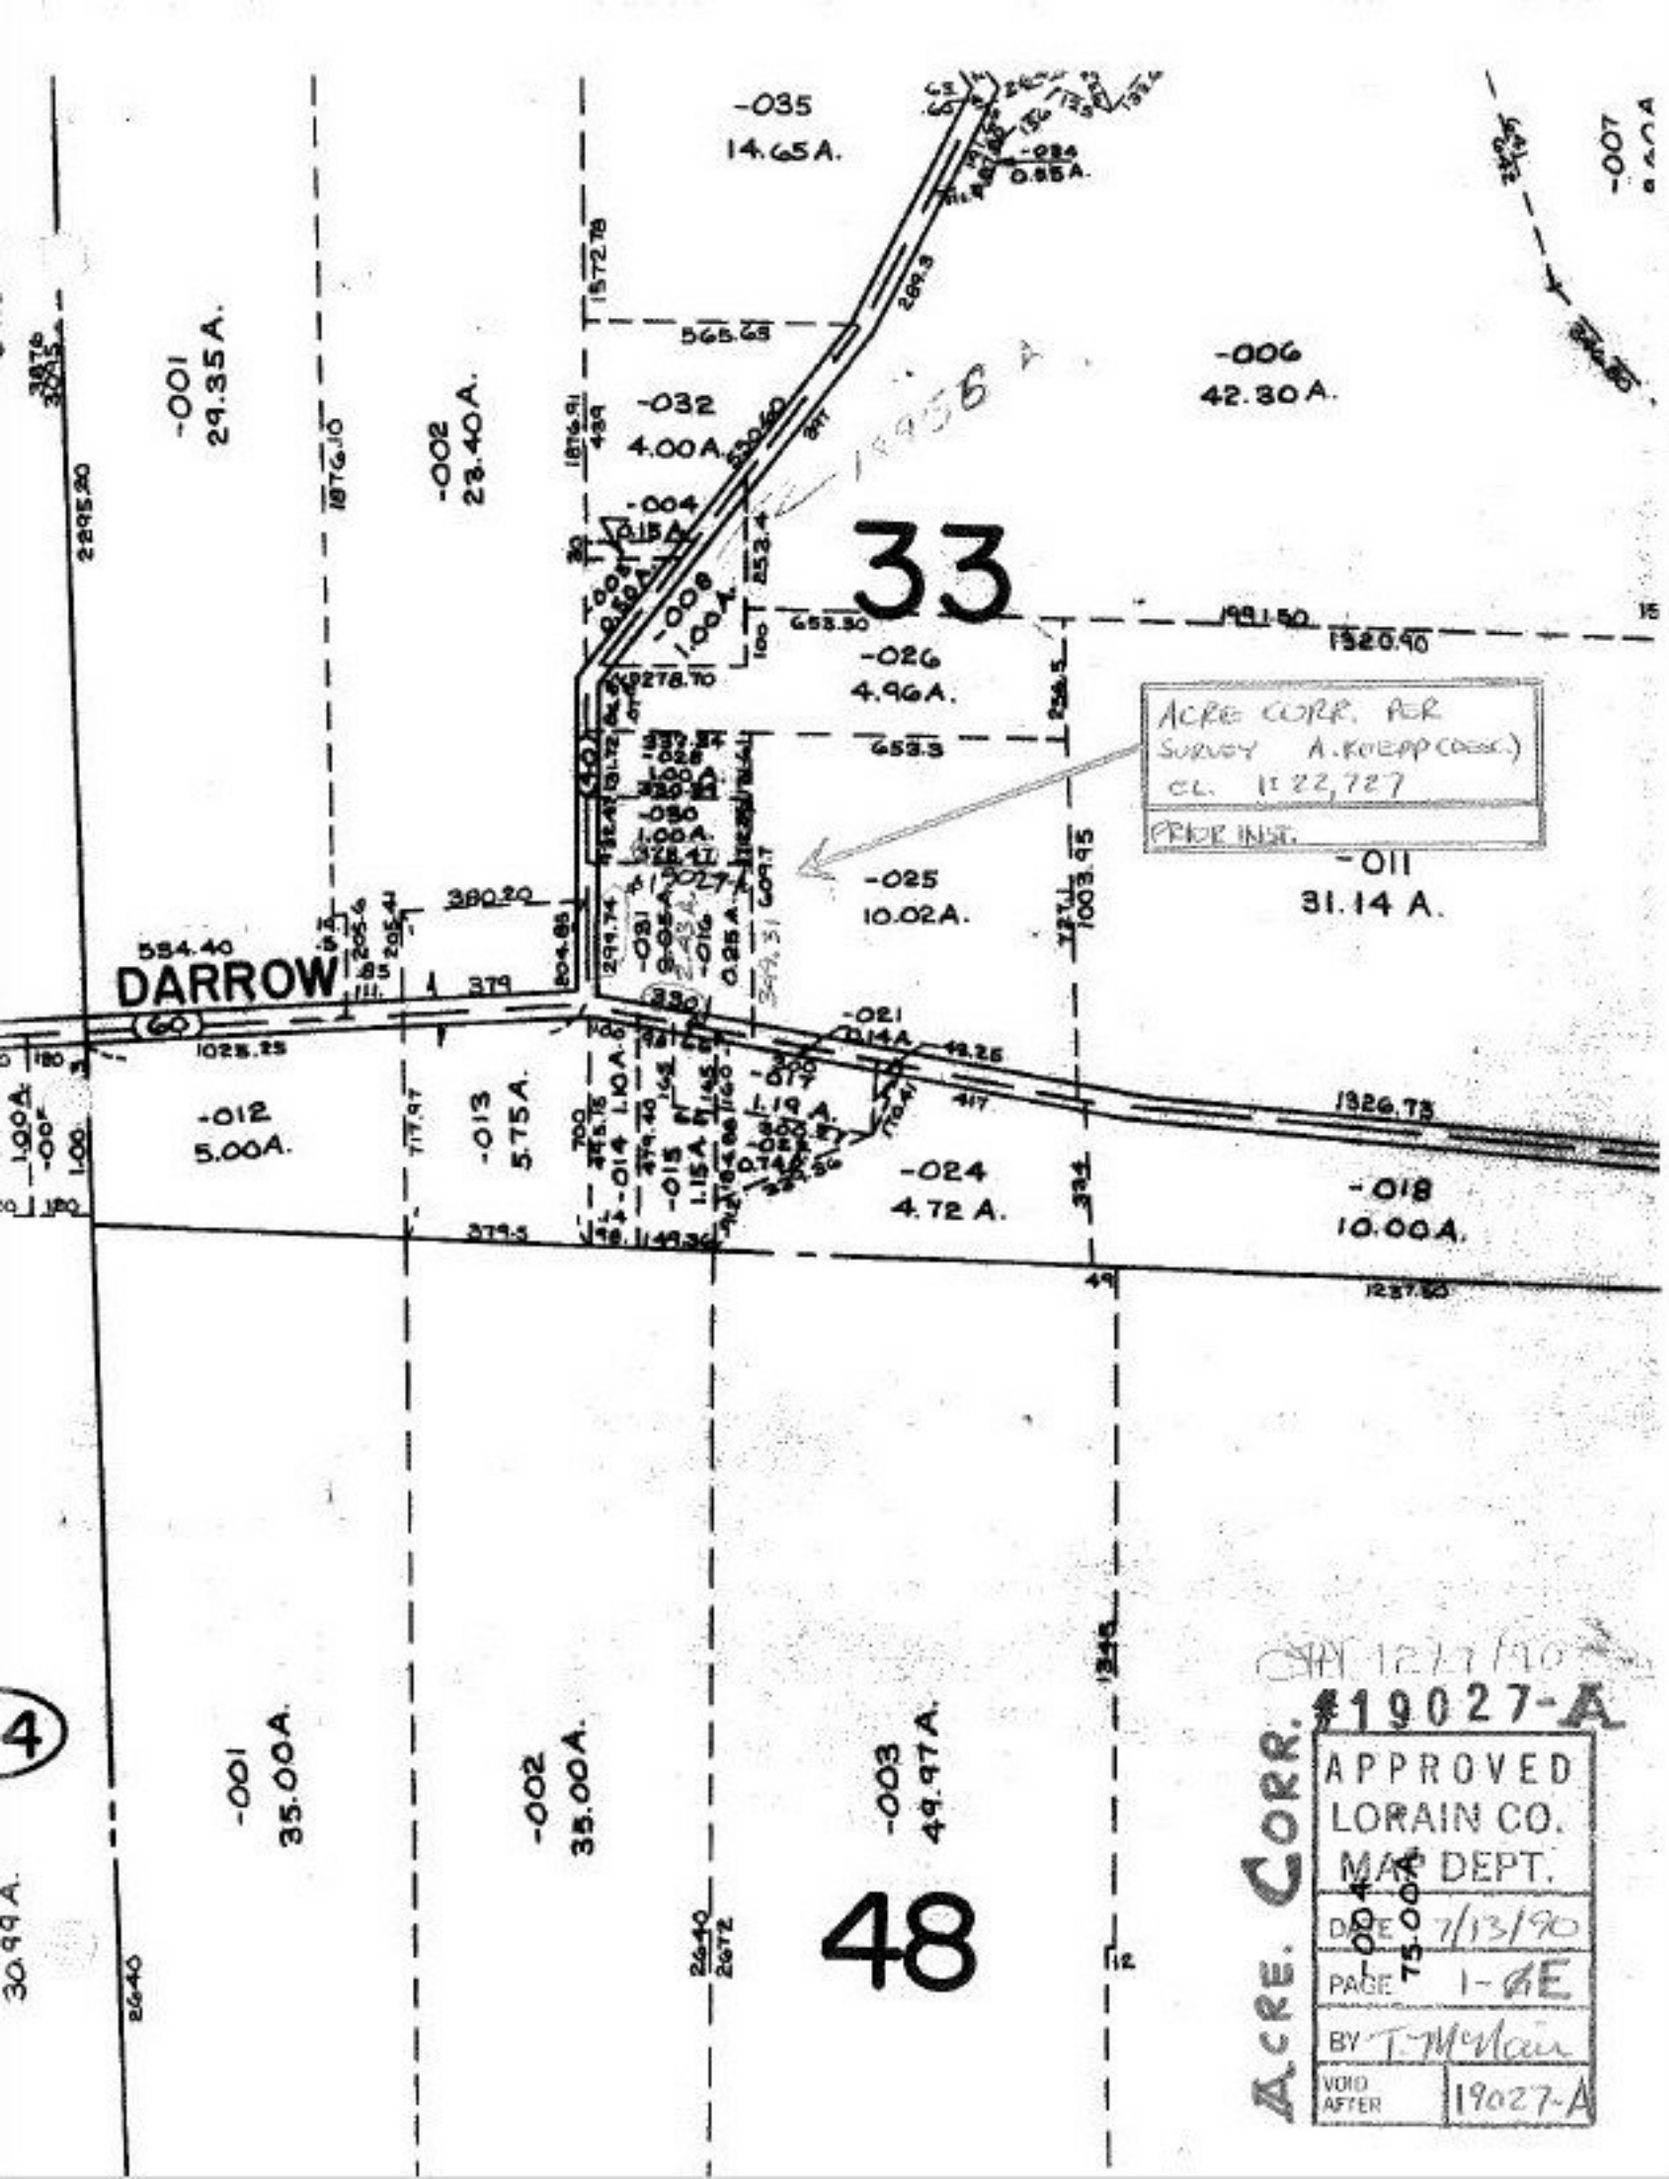

-035
14.65A.
-034
0.55A.
-007
-001
29.35A.
-002
23.40A.
-032
4.00A.
-004
0.15A.
-006
42.30A.
33
-008
1.00A.
-026
4.96A.
ACRE CORR. PER SURVEY A. KOEPP (DESC.) CL. 1:22,727
PRIOR INST.
-011
31.14 A.
-025
10.02A.
DARROW
-012
5.00A.
-013
5.75A.
-021
0.14A.
-017
1.19 A.
-024
4.72 A.
-018
10.00A.
-001
35.00A.
-002
35.00A.
-003
49.97A.
48
ACRE. CORR.
#19027-A
APPROVED
LORAIN CO.
MAP DEPT.
DATE 7/13/90
PAGE 1-6E
BY T. McNair
VOID AFTER 19027-A