REF OLD MAP
ELYRIA BK 10 PL. 6

D.V. 1182/846
1163/159
1092/745

SEE 6-104

70

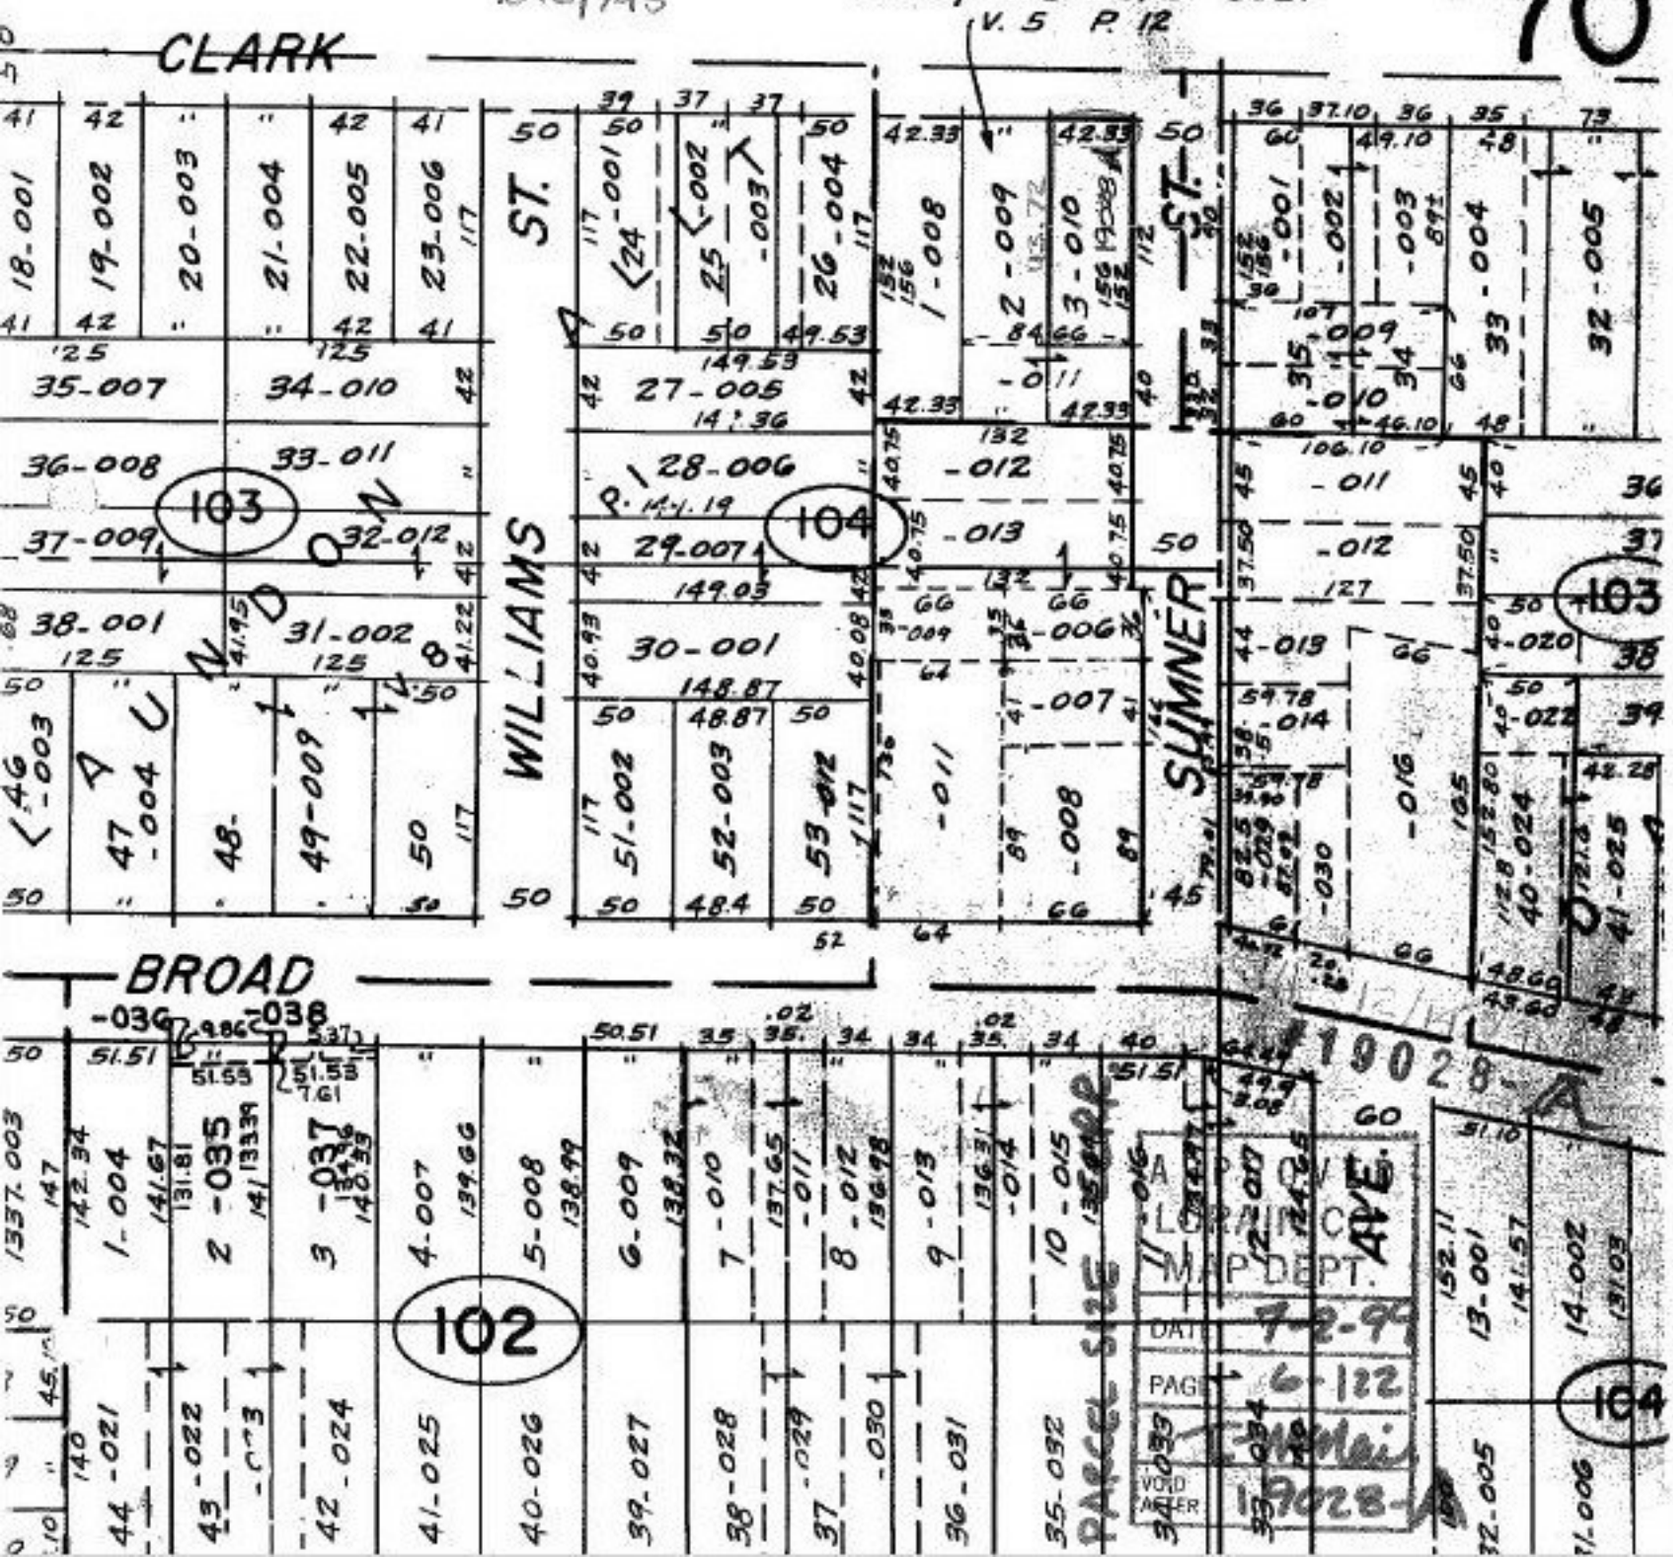

APPROVED
LORAIN CO.
MAP DEPT.
DATE 7-2-99
PAGE 6-122
VOID AFTER 19028-A
PARCEL SIZE