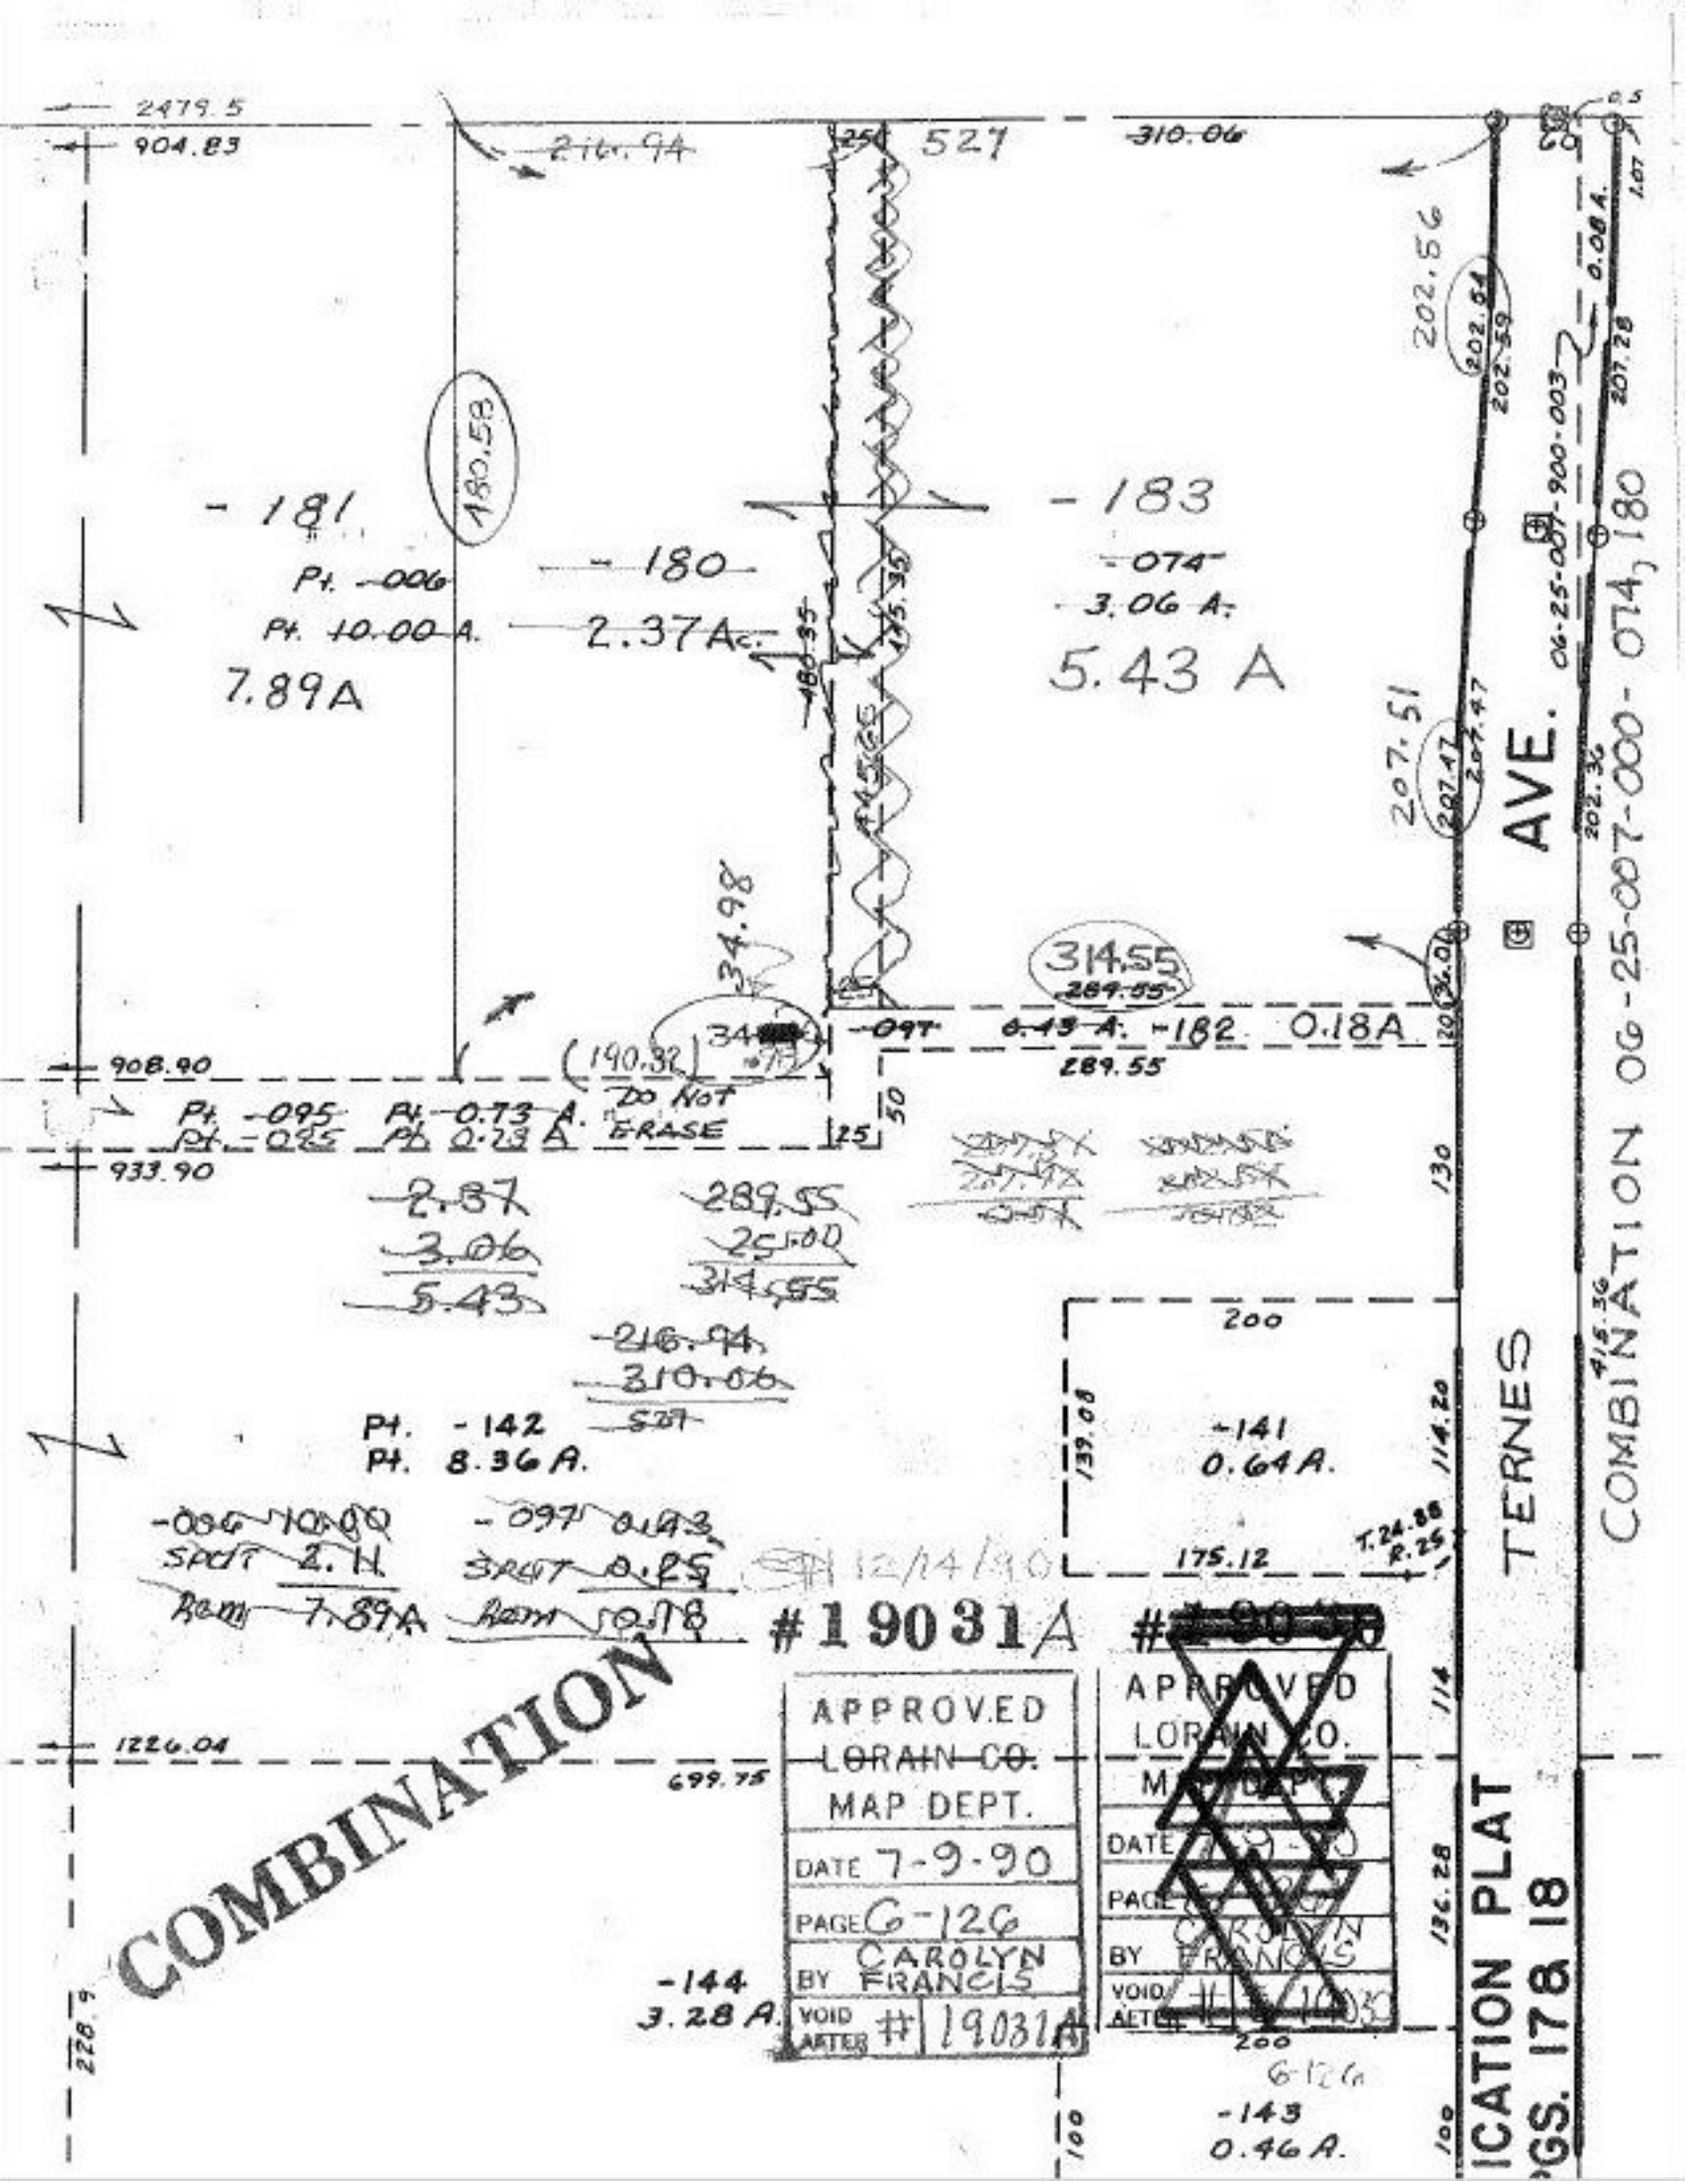

2479.5
904.83
216.94
527
310.06
202.56
202.54
202.59
0.08 A.
207.28
180.58
-181
-183
Pt. -006
-180
-074
Pt. 10.00 A.
2.37 Ac.
3.06 A.
7.89A
5.43 A
480.35
445.35
207.51
207.47
207.47
202.36
06-25-007-900-003
AVE.
34.98
314.55
289.55
-097
0.43 A.
-182
0.18A
908.90
(190.32)
289.55
Pt. -095
Pt. 0.73 A.
DO NOT ERASE
Pt. -095
Pt. 0.73 A.
933.90
2.37
3.06
5.43
289.55
25.00
314.55
216.94
310.06
527
200
Pt. -142
Pt. 8.36 A.
139.08
-141
0.64 A.
114.20
175.12
T.24.88
R.25
-006 10.00
SPLIT 2.11
Rem 7.89A
-097 0.43
SPLIT 0.25
Rem 0.18
12/14/90
#19031A
#
COMBINATION
1226.04
699.75
APPROVED
LORAIN CO.
MAP DEPT.
DATE 7-9-90
PAGE 6-126
BY CAROLYN FRANCIS
VOID AFTER # 19031A
APPROVED
LORAIN CO.
MAP DEPT.
DATE
PAGE
BY CAROLYN FRANCIS
VOID AFTER
-144
3.28 A.
228.9
200
6-126
-143
0.46 A.
100
100
130
114
136.28
TERNES
COMBINATION 06-25-007-000-074, 180
415.36
ICATION PLAT
GS. 178 18