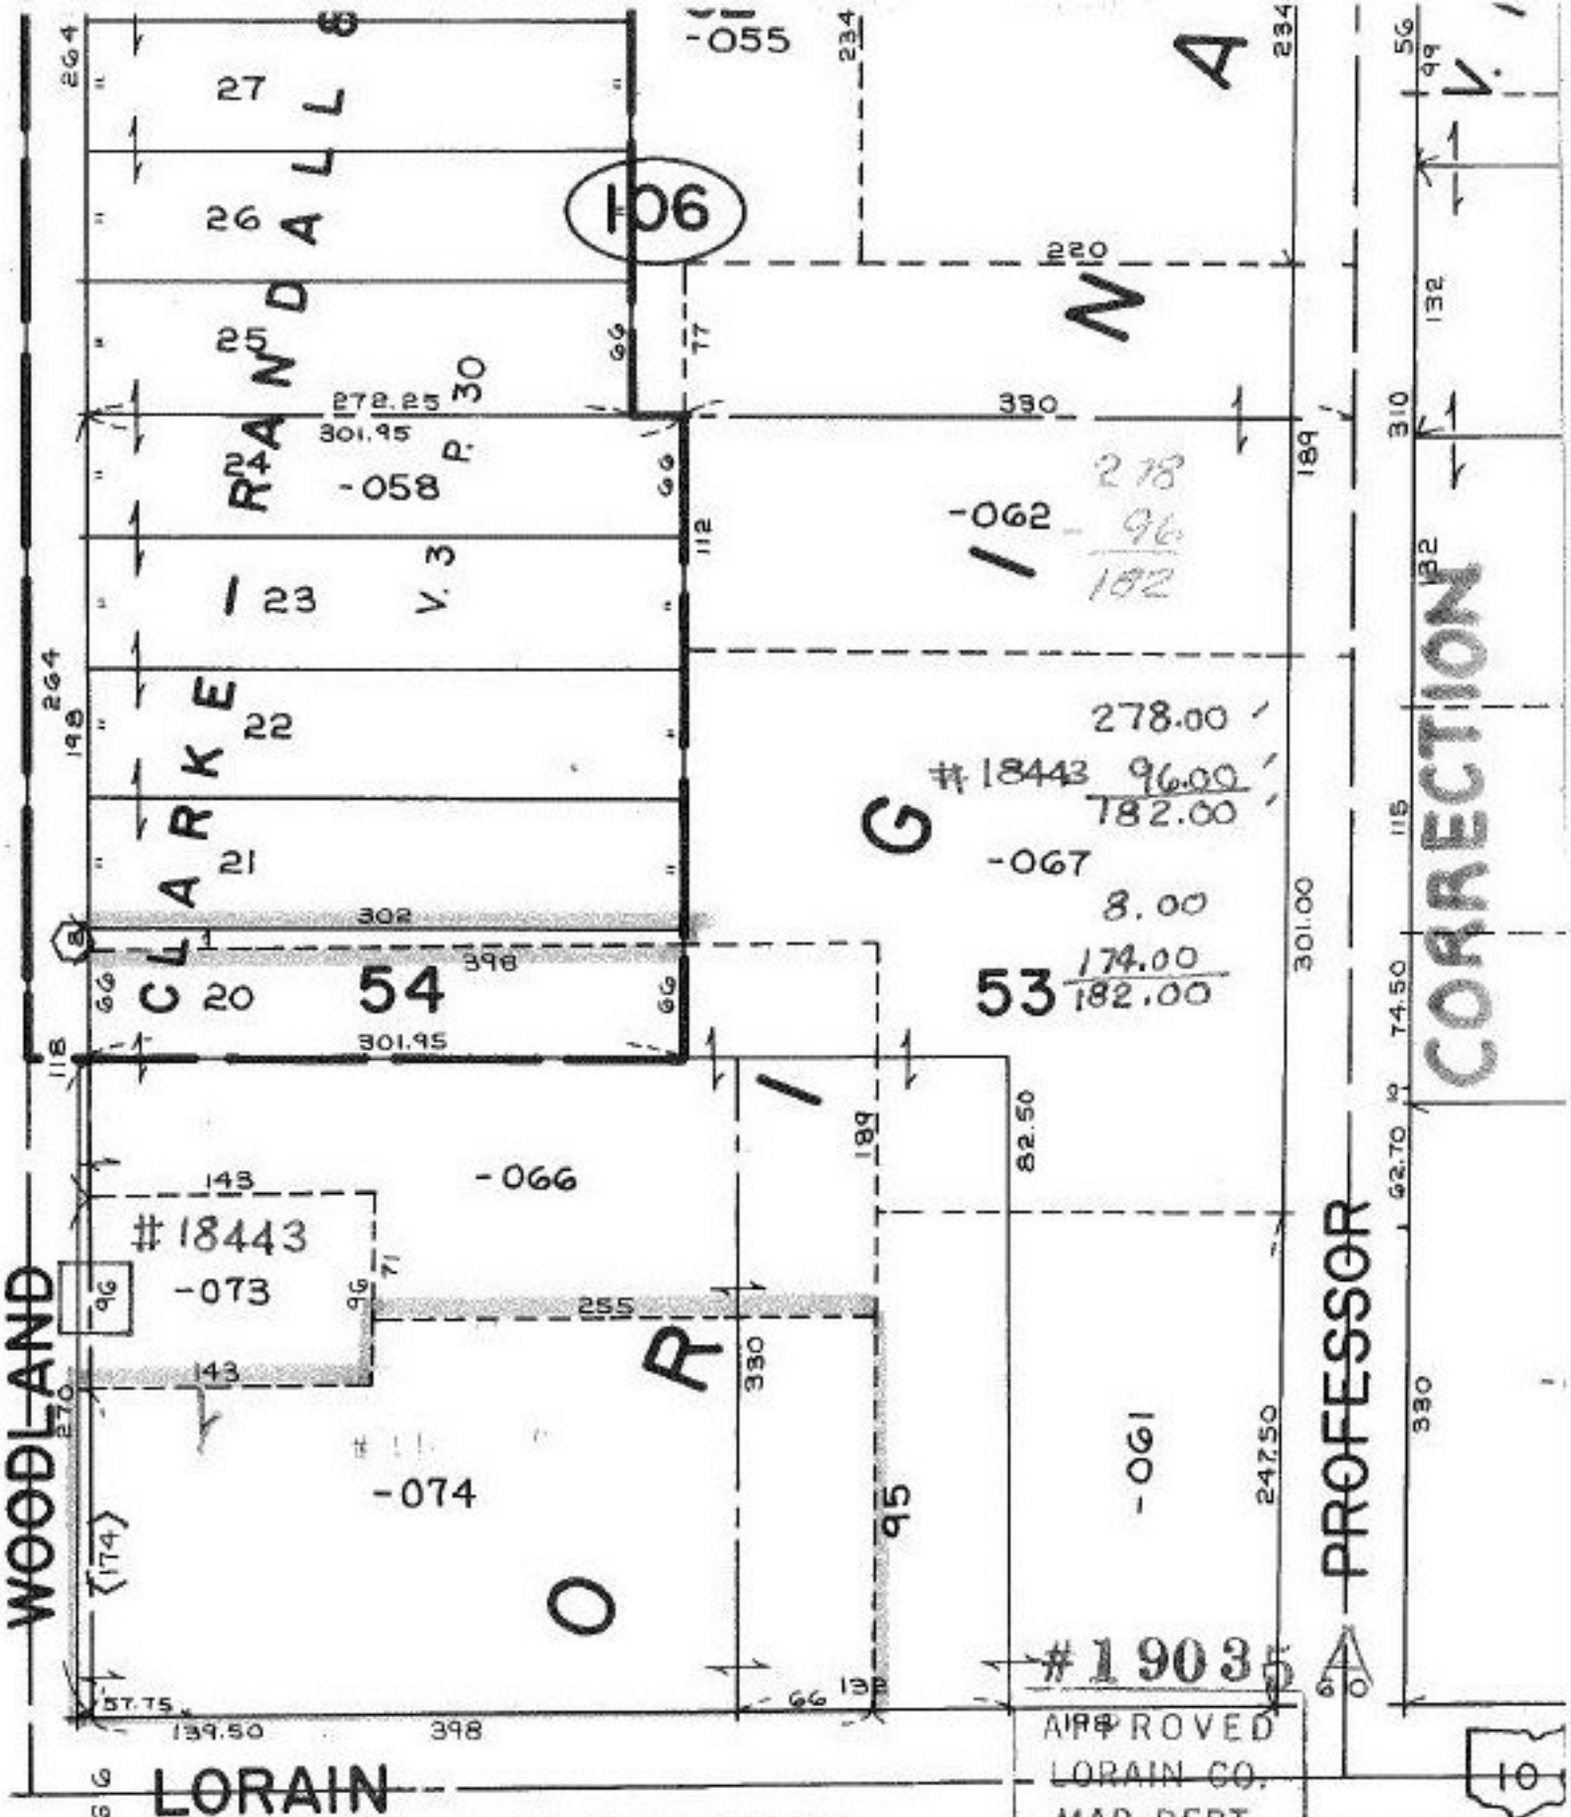

THIS IS TO CORRECT FRONTAGE OF P.P. NO 09-00-075-106-074 IN REG & TRANSFER OFFICE RECORDS FRONTAGE FOR SPLIT NO. 18443. WAS NOT SUBTRACTED OUT AT THAT TIME.

APPROVED
LORAIN CO.
MAP DEPT.
SEE 9-00-085-B
DATE 7-20-90
PAGE 9-00-075-B
BY CAROLYN FRANCIS
VOID AFTER # 19035A

9-13-90