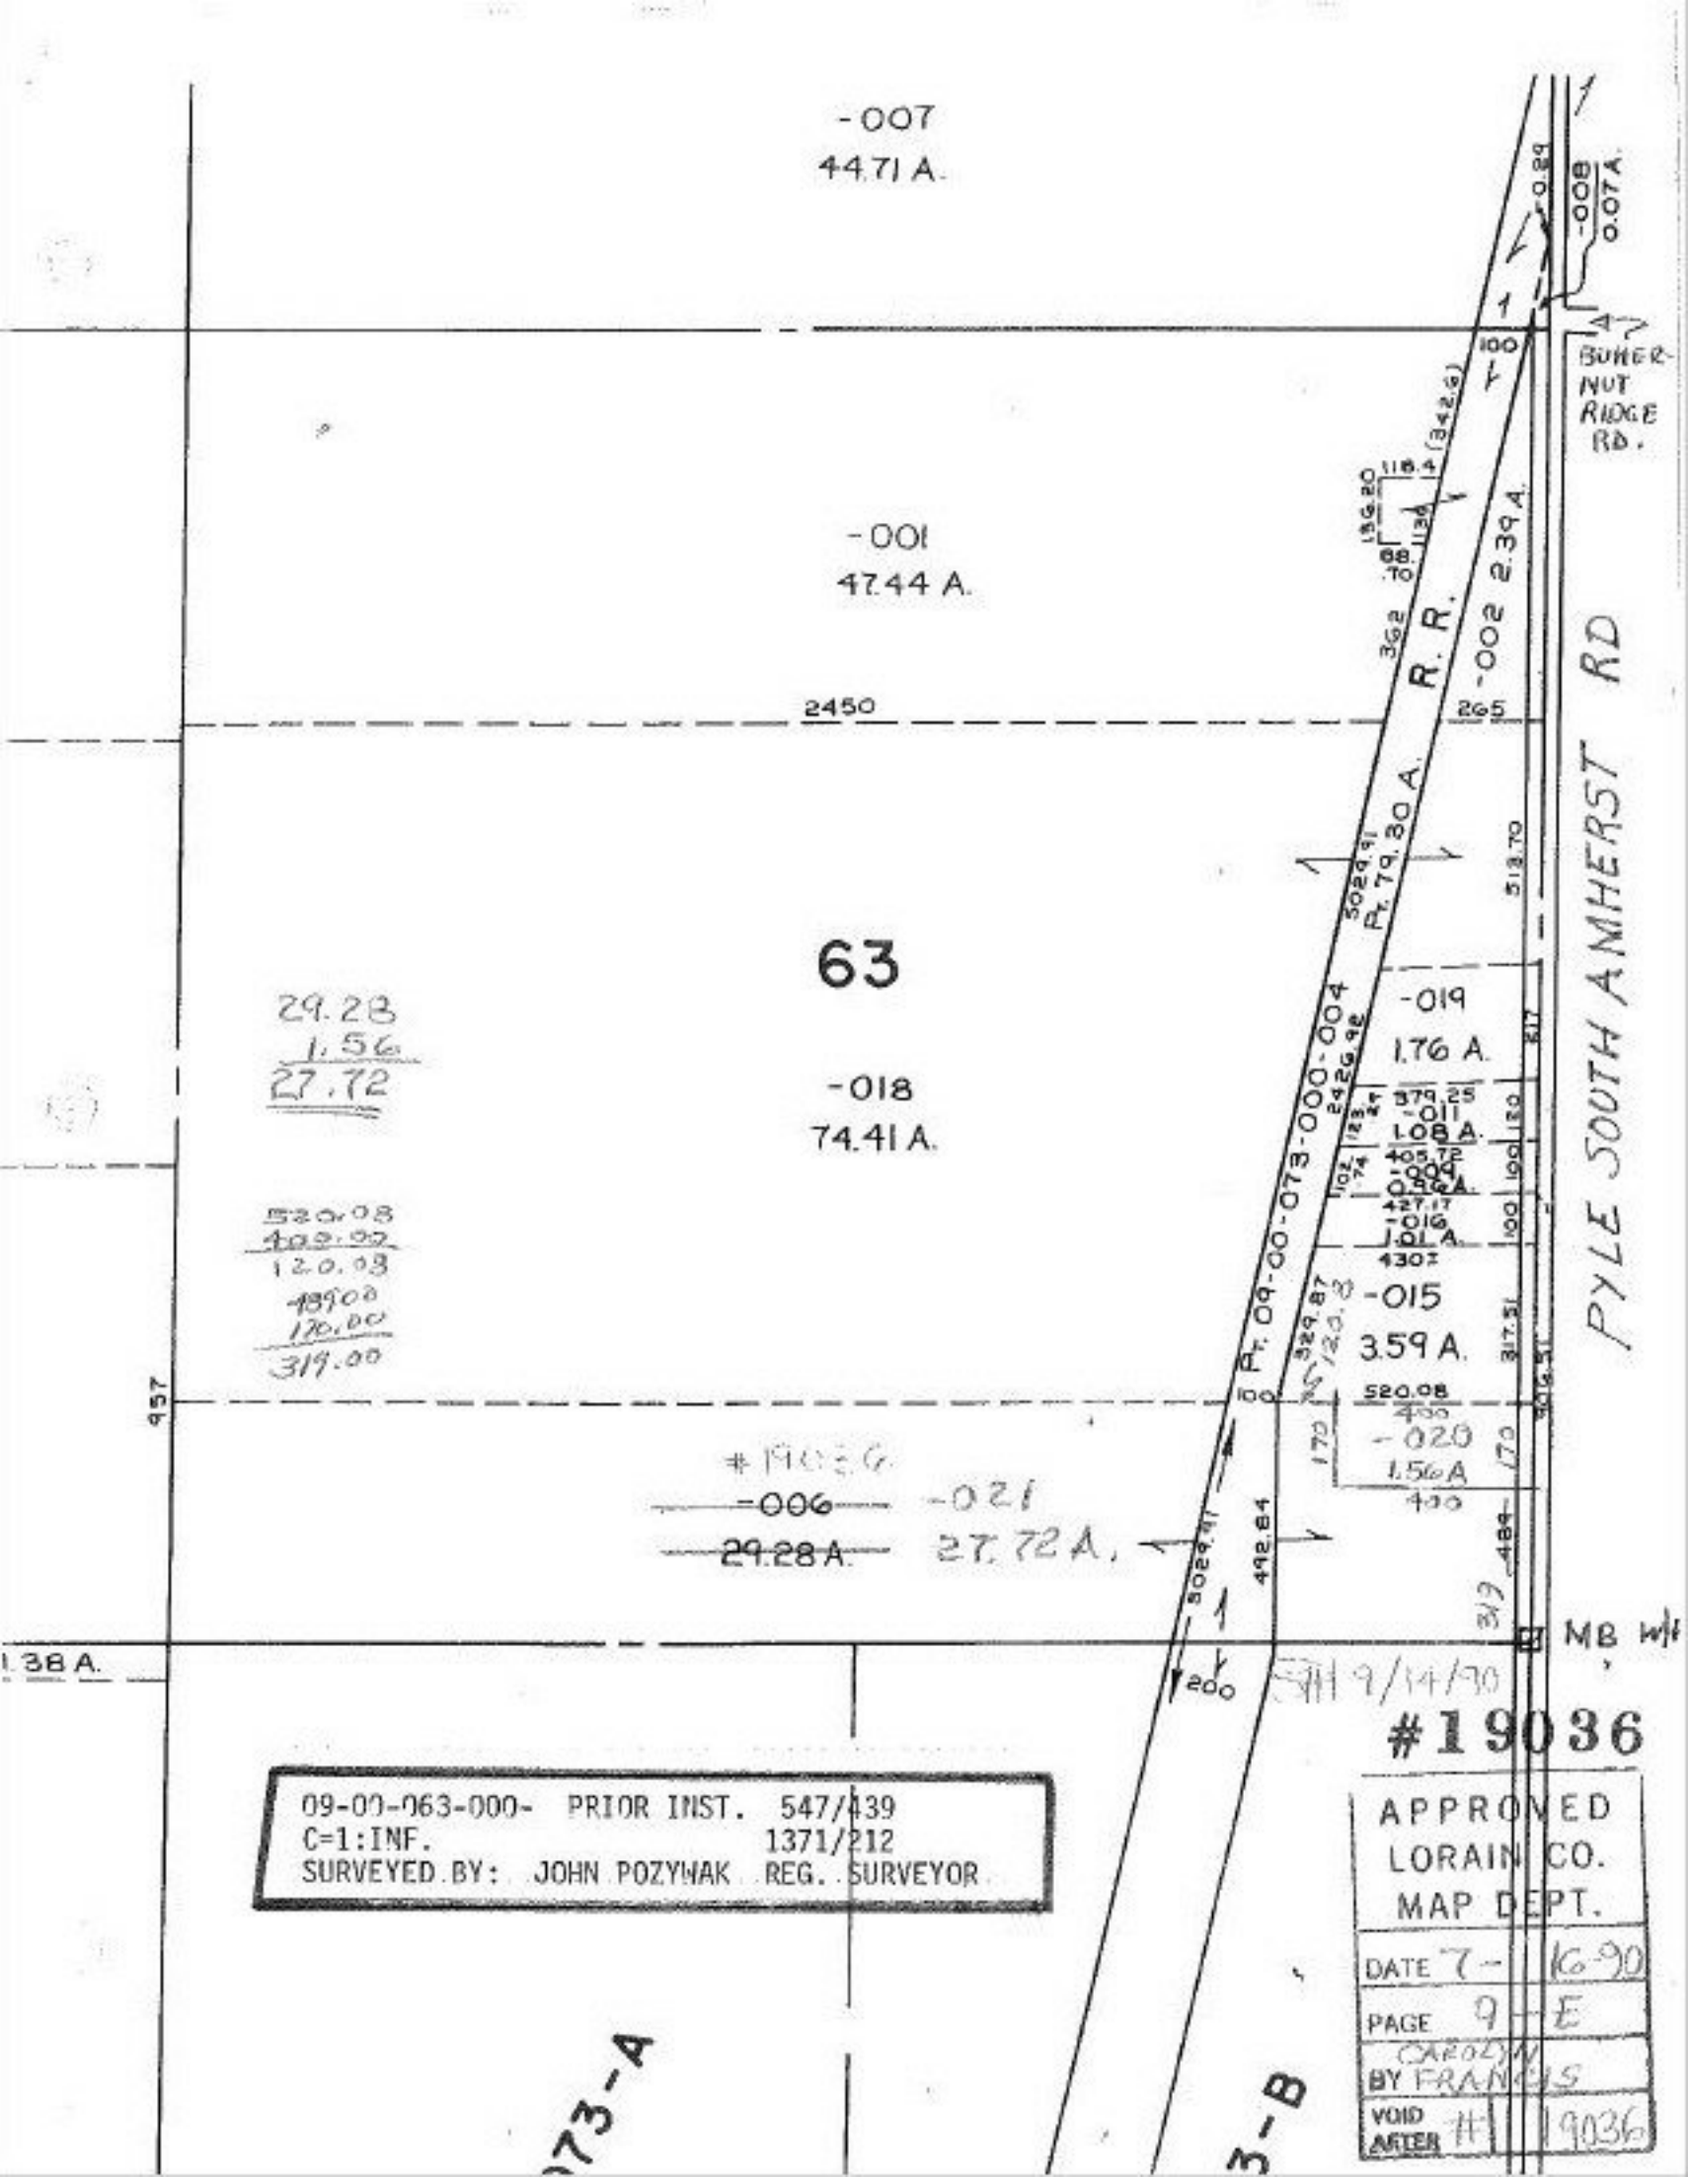
-007
44.71 A.
-001
47.44 A.
2450
63
-018
74.41 A.
29.28
1.56
27.72
520.08
400.00
120.08
489.00
170.00
319.00
957
#19036
-006
29.28 A.
-021
27.72 A.
1.38 A.
-008
0.07 A.
BUHER-NUT RIDGE RD.
-002 2.39 A.
R. R.
Pt. 79.30 A.
Pt. 09-00-073-000-004
-019
1.76 A.
-011
1.08 A.
-009
0.96 A.
-016
1.01 A.
-015
3.59 A.
-020
1.56 A
PYLE SOUTH AMHERST RD
MB W/H
9/14/90
#19036
09-00-063-000- PRIOR INST. 547/439
C=1:INF. 1371/212
SURVEYED BY: JOHN POZYWAK REG. SURVEYOR
APPROVED
LORAIN CO.
MAP DEPT.
DATE 7-16-90
PAGE 9-E
BY CAROLYN FRANCIS
VOID AFTER #19036
073-A
3-B