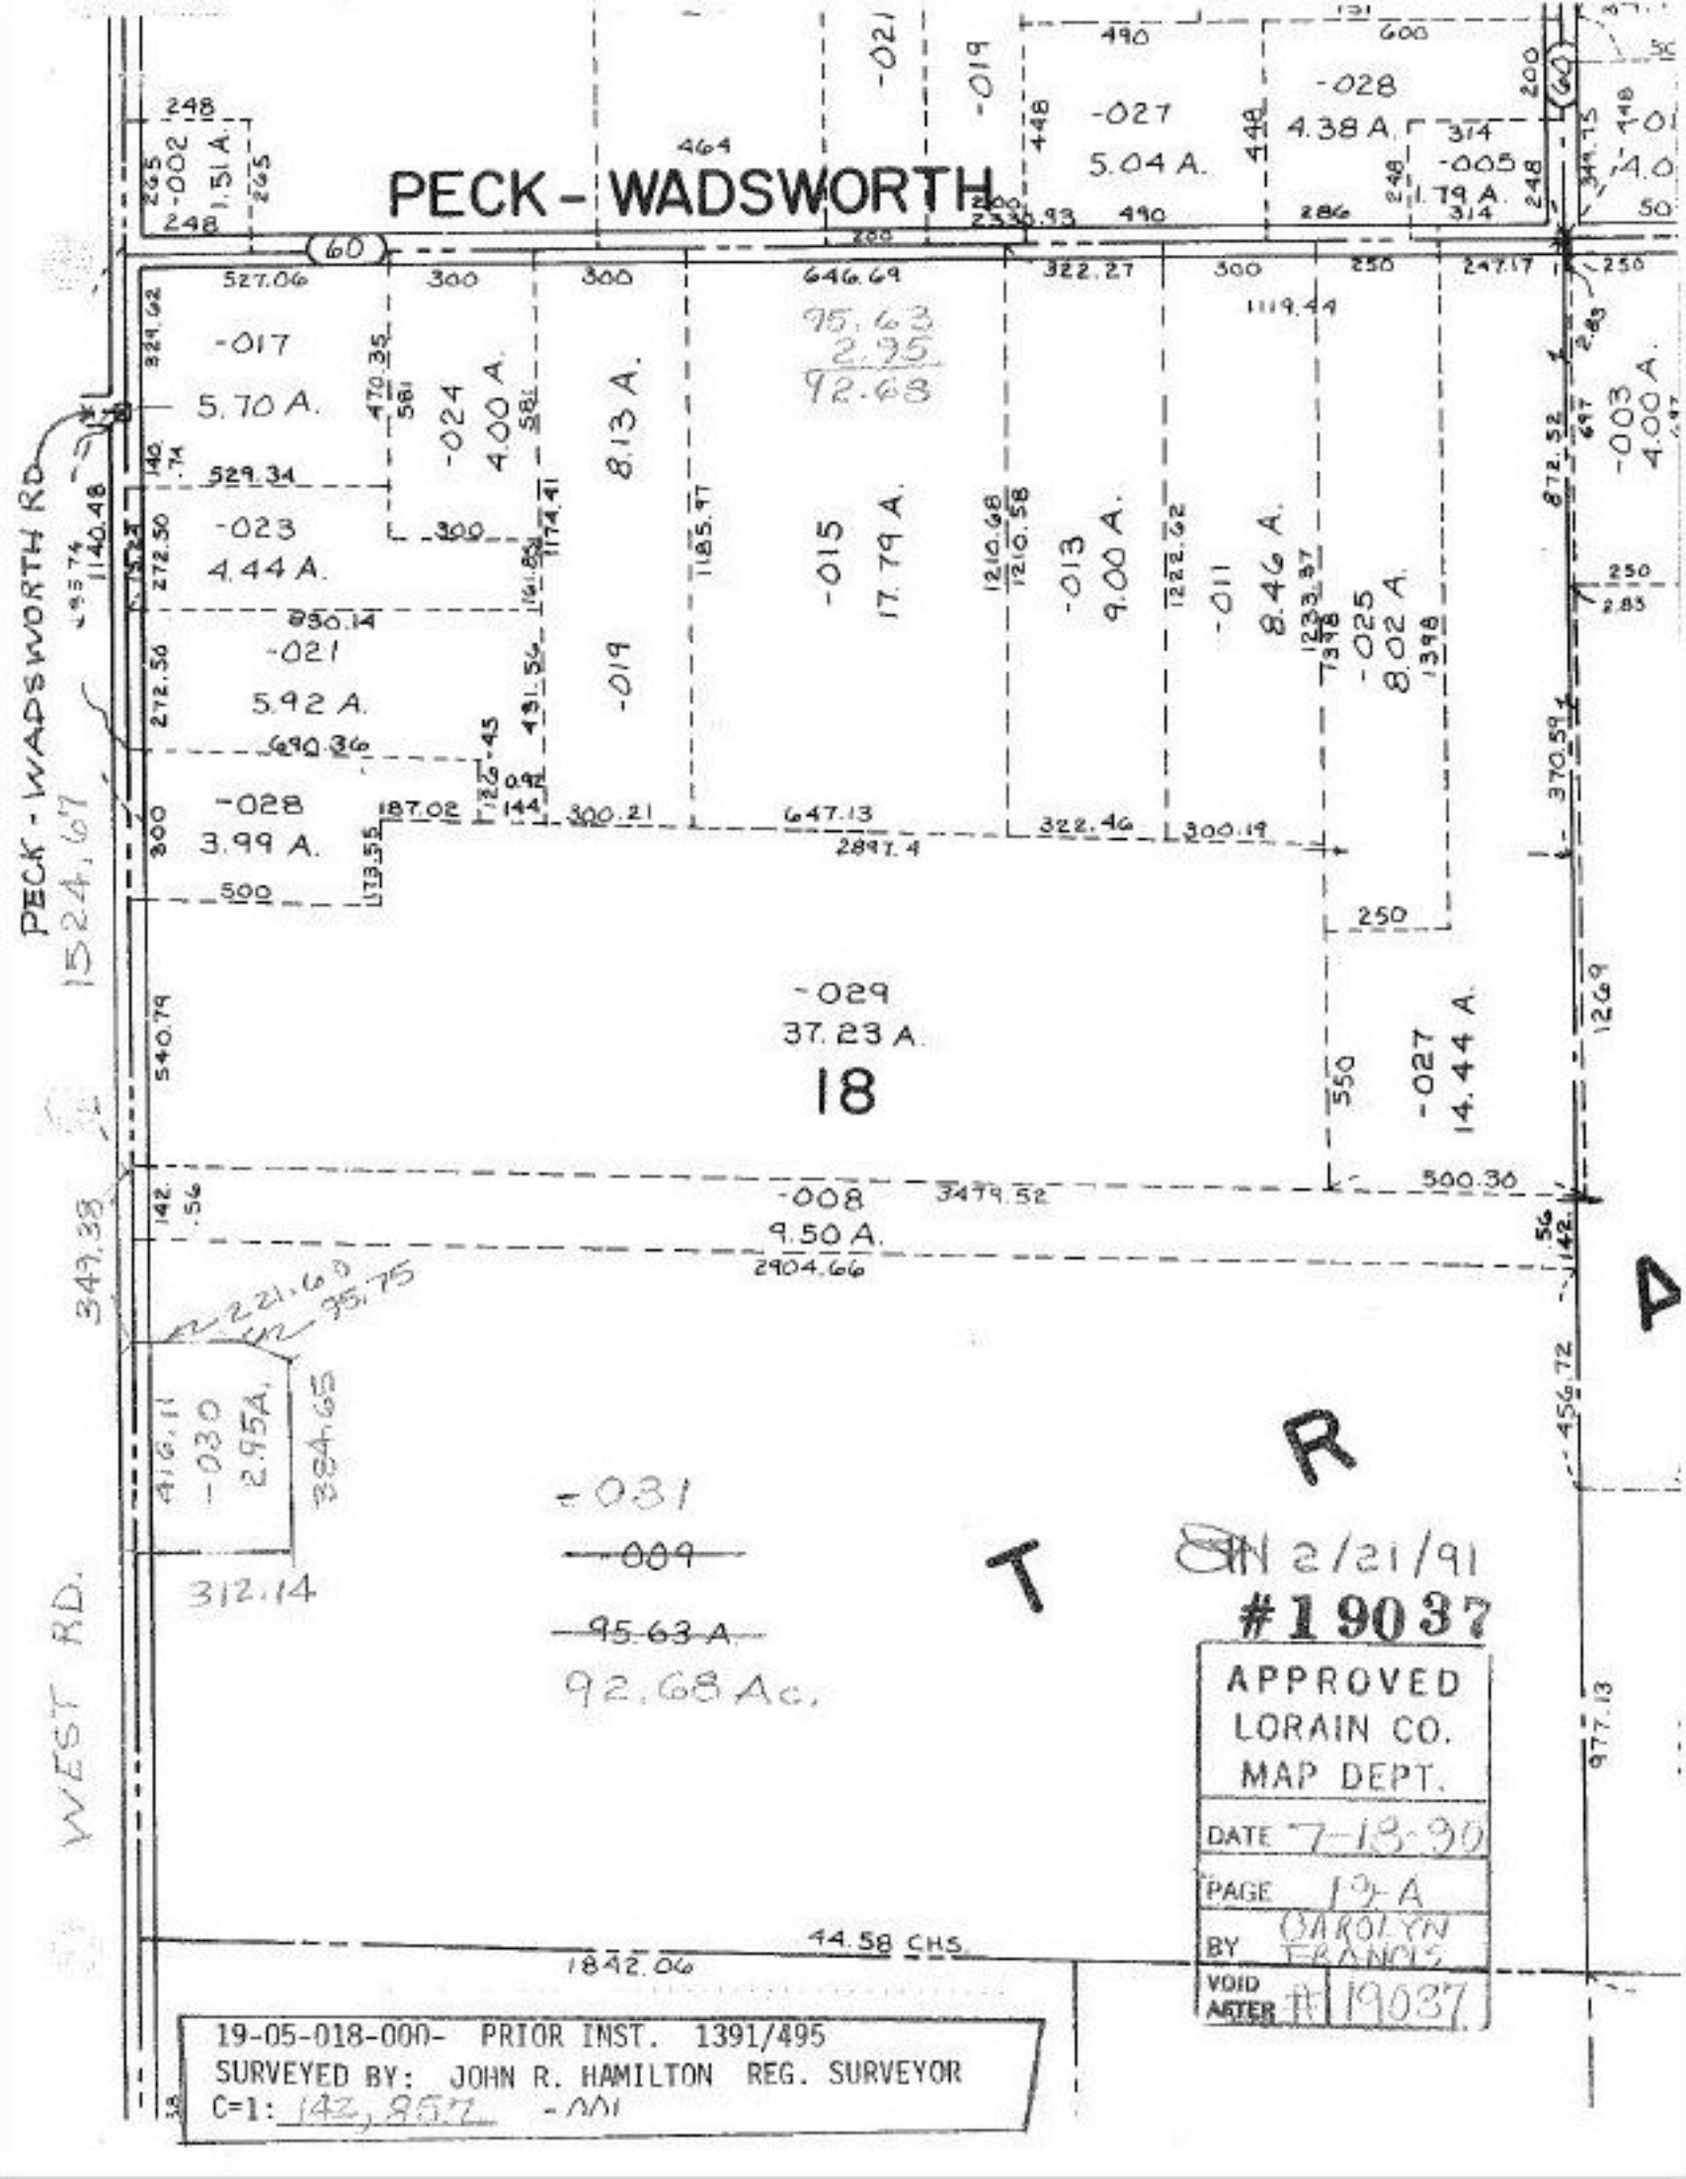
PECK - WADSWORTH
PECK - WADSWORTH RD
WEST RD.
-017
5.70 A.
-023
4.44 A.
-021
5.92 A.
-028
3.99 A.
-024
4.00 A.
8.13 A.
-019
-015
17.79 A.
-013
9.00 A.
-011
8.46 A.
-025
8.02 A.
-027
5.04 A.
-028
4.38 A.
-005
1.79 A.
-003
4.00 A.
-029
37.23 A.
18
-027
14.44 A.
-008
9.50 A.
-030
2.95A.
95.63
2.95
92.68
-031
~~-009~~
~~95.63 A.~~
92.68 Ac.
44.58 CHS.
1842.06
1524.67
349.38
312.14
221.60
95.75
384.65
T R A
#19037
APPROVED
LORAIN CO.
MAP DEPT.
DATE 7-18-90
PAGE 19-A
BY CAROLYN FRANCIS
VOID AFTER # 19037
19-05-018-000- PRIOR INST. 1391/495
SURVEYED BY: JOHN R. HAMILTON REG. SURVEYOR
C=1: 142,857 -001