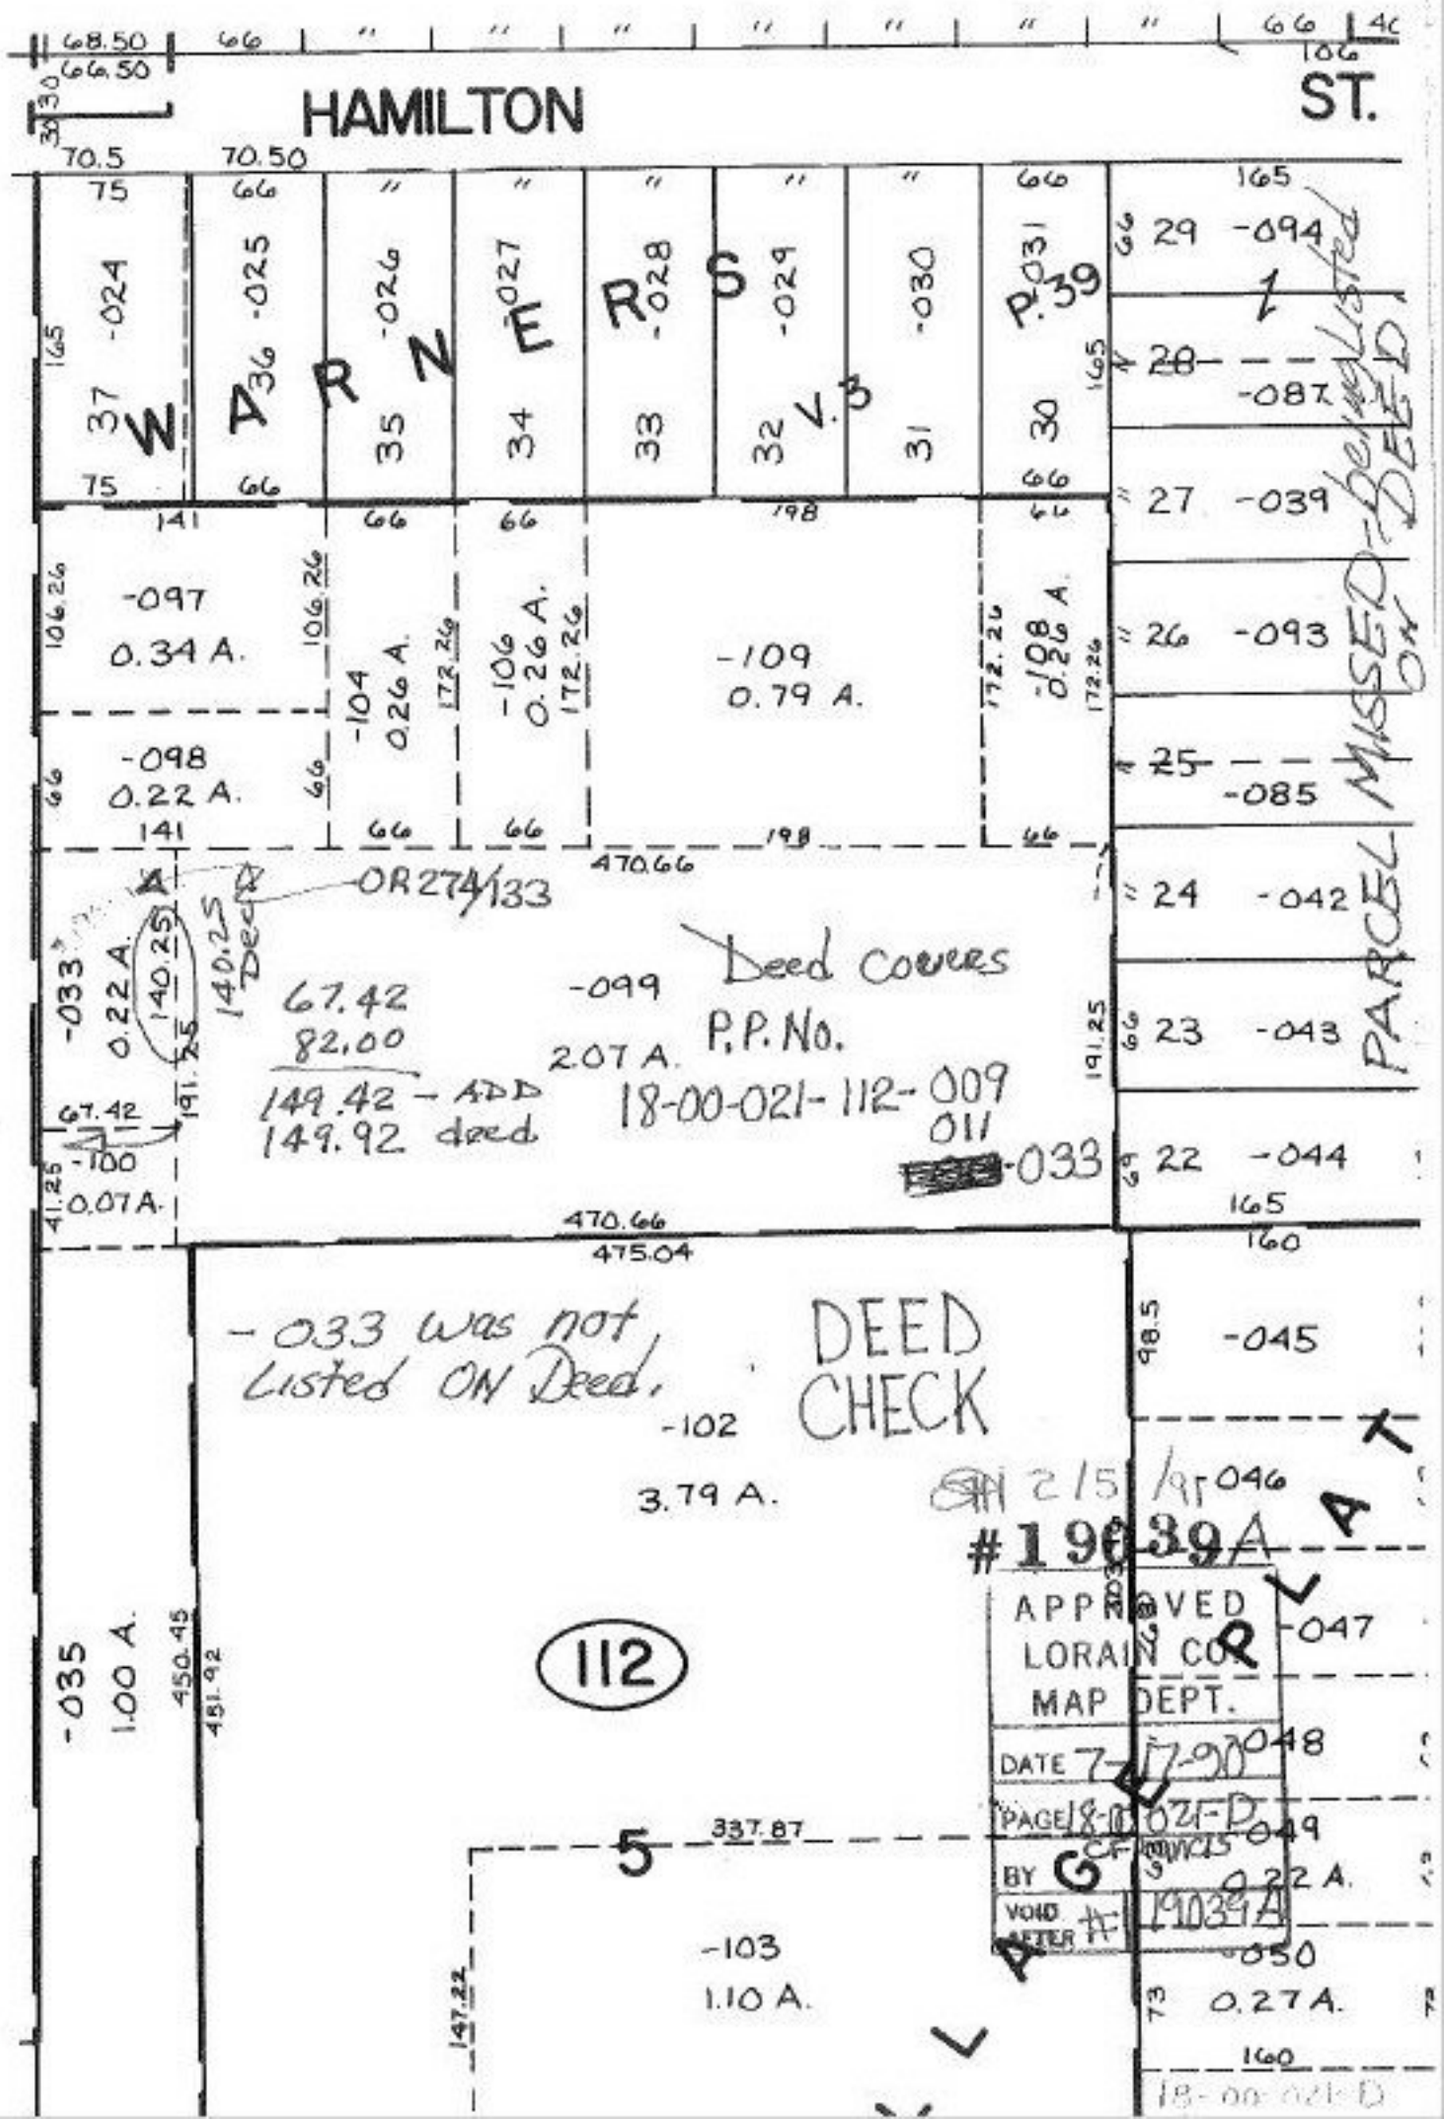
HAMILTON ST.
T3S R2W S35
W A N E
37 36 35 34 33 32 31 30
P.39
-024 -025 -026 -027 -028 -029 -030 -031
-097 0.34 A.
-104 0.26 A.
-106 0.26 A.
-109 0.79 A.
-108 0.26 A.
-098 0.22 A.
-033 0.22 A.
-100 0.07 A.
-099 2.07 A.
-102 3.79 A.
-035 1.00 A.
-103 1.10 A.
-045
-047
-048
-049
-050
0.22 A.
0.27 A.
-094
-087
-039
-093
-085
-042
-043
-044
OR 274/133
140.25 Deed
67.42
82.00
149.42 - ADD
149.92 deed
Deed covers P.P. No. 18-00-021-112-009 011
-033 was not Listed ON Deed.
DEED CHECK
#19039A
APPROVED LORAIN CO. MAP DEPT.
DATE 7-17-90
PAGE 18-00-021-D
BY
VOID AFTER #
PARCEL MISSED-Delinquent Listed On DEED
112
SEE 18-00-021-C
18-00-021-D