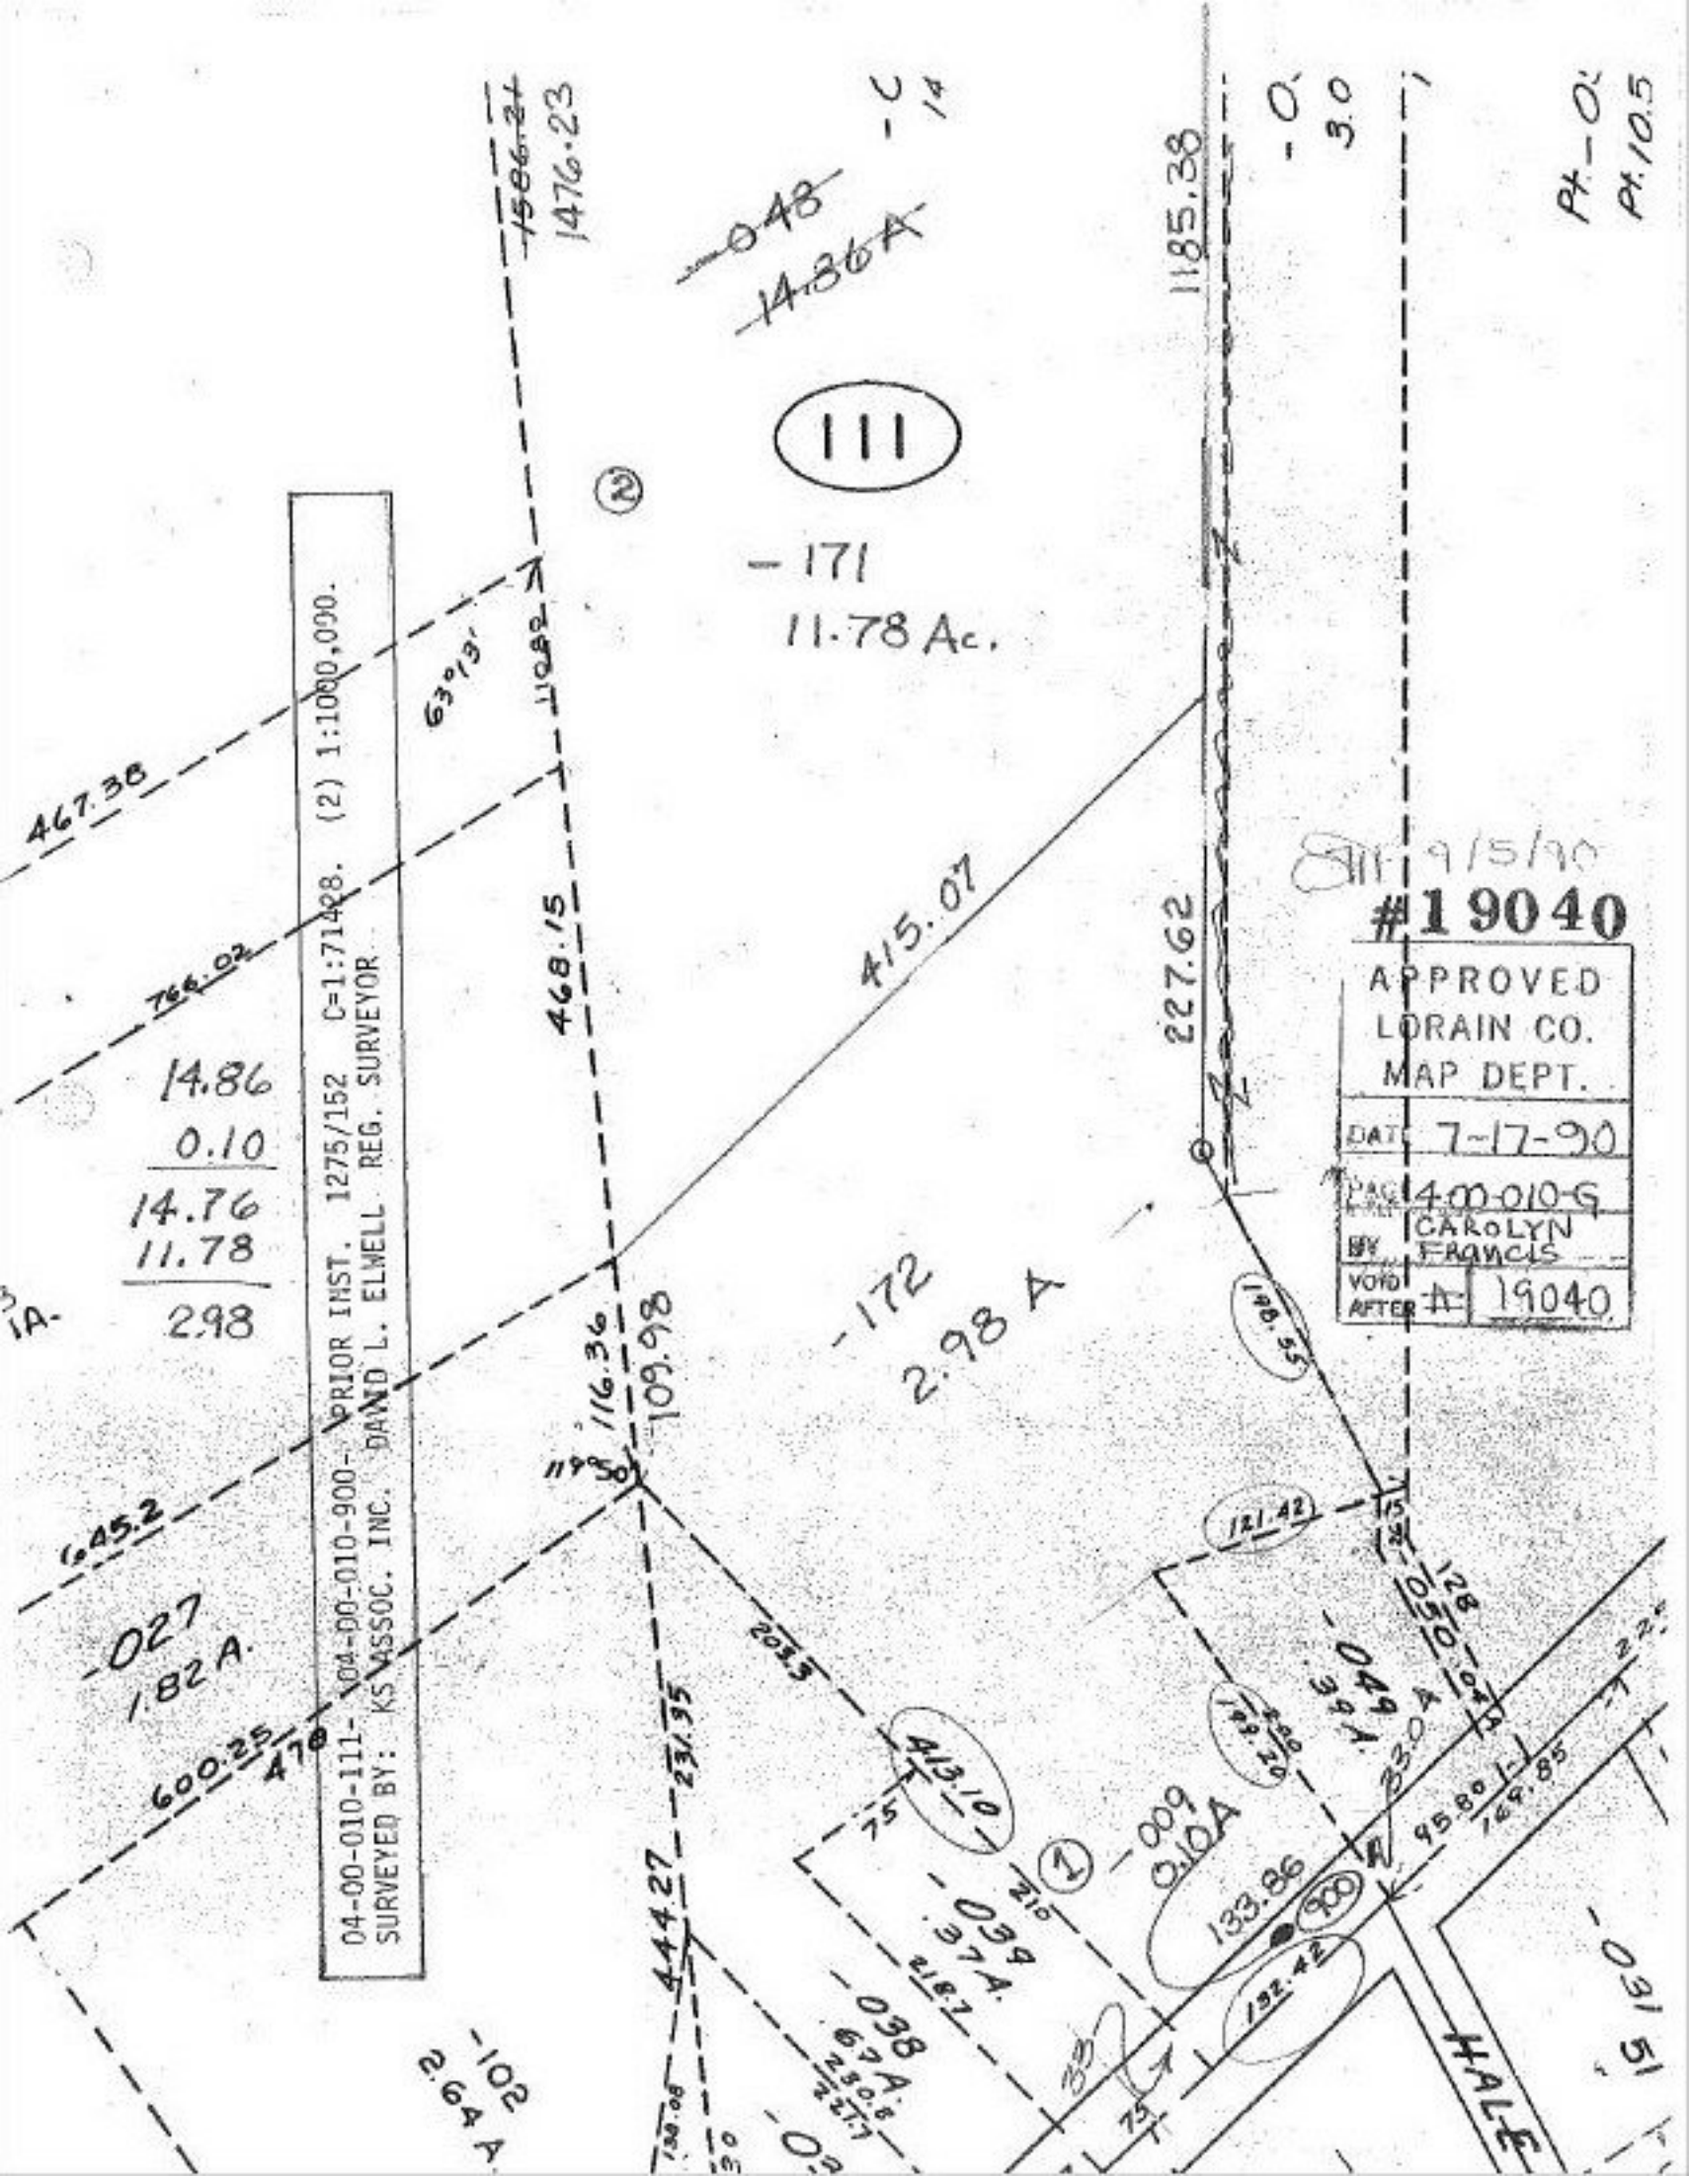

04-00-010-111- 04-00-010-900- PRIOR INST. 1275/152 C=1:71428. (2) 1:1000,000.
SURVEYED BY: KS ASSOC. INC. DAVID L. ELWELL REG. SURVEYOR
111
-171
11.78 Ac.
-172
2.98 A
-027
1.82 A.
-009
0.10A
-049
.39 A.
-039
.37 A.
-038
.67 A.
-102
2.64 A
-031
51
HALE
14.86
0.10
14.76
11.78
2.98
467.38
766.02
645.2
600.25
470
63°13'
468.15
415.07
227.62
1185.38
1476.23
116.36
109.98
119°50'
121.42
413.10
133.86
132.42
95.80
169.85
33.0 A
Pt.10.5
9/5/90
#19040
APPROVED
LORAIN CO.
MAP DEPT.
DATE 7-17-90
PAGE 4-00-010-G
BY CAROLYN FRANCIS
VOID AFTER # 19040