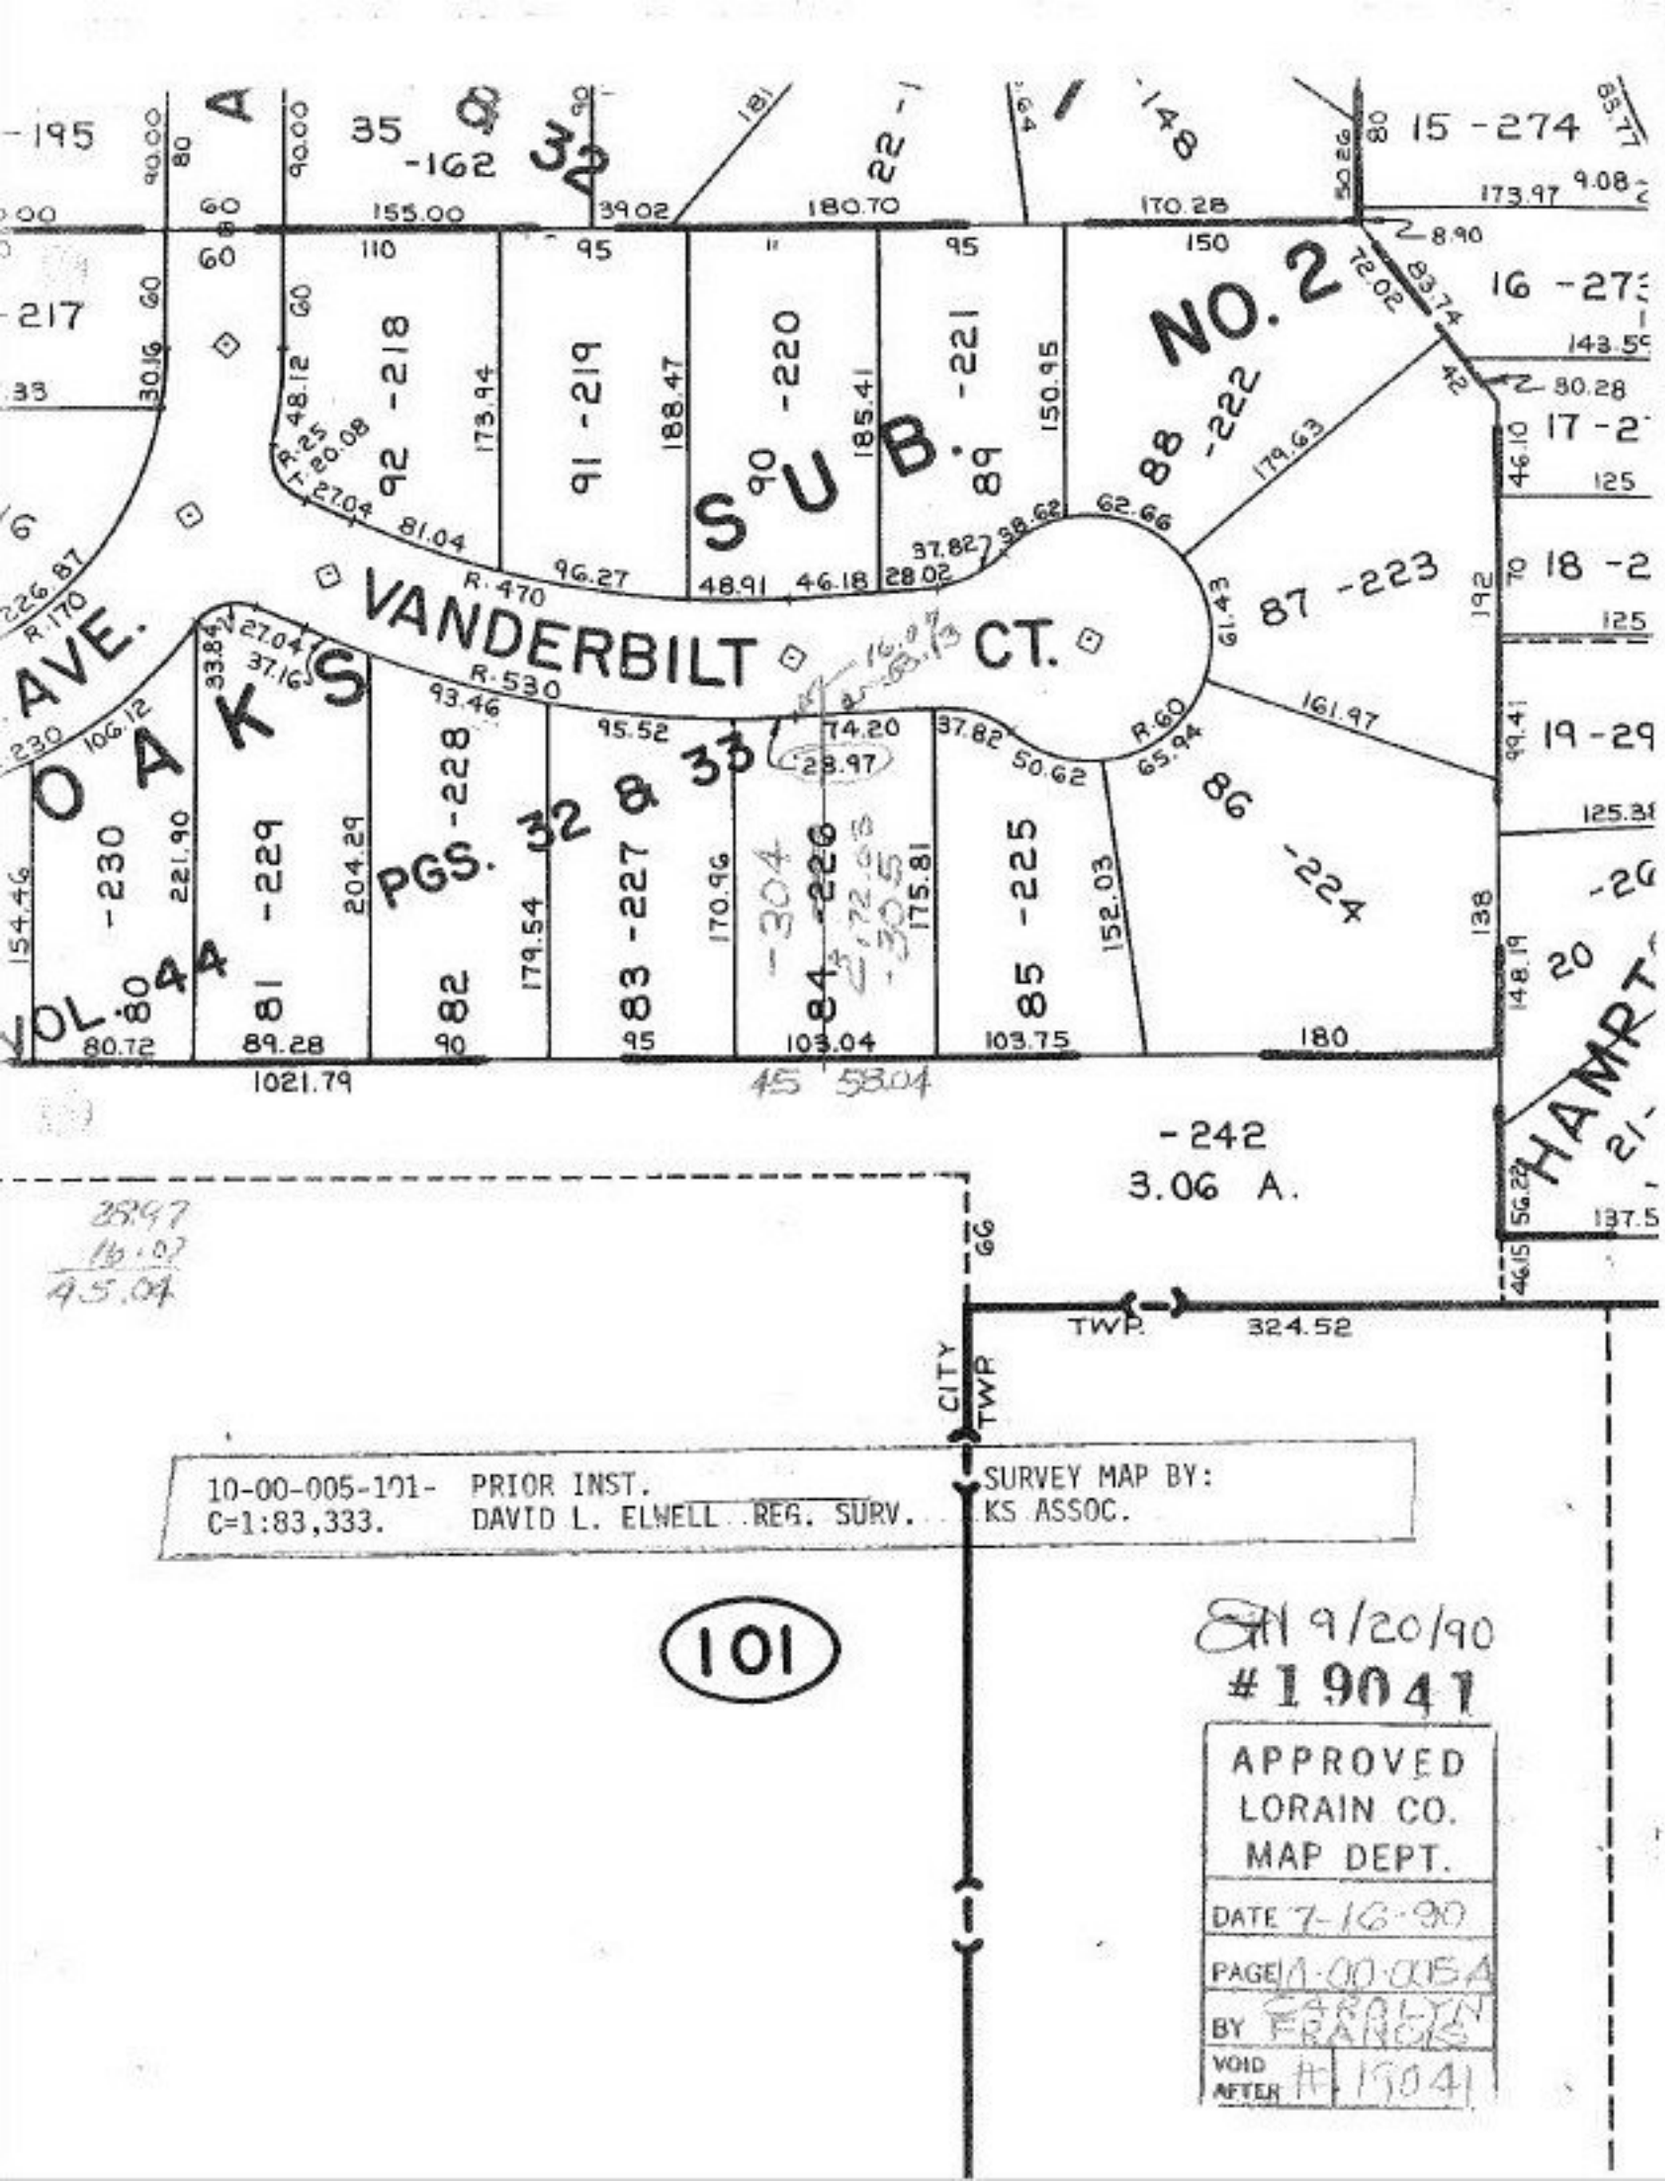
VANDERBILT CT.
OAKS AVE.
SUB. NO. 2
PGS. 228
-195
-162
-217
-218
-219
-220
-221
-222
-223
-224
-225
-226
-227
-228
-229
-230
-242
3.06 A.
-304
-305
15 -274
16 -27
17 -2
18 -2
19 -29
-20
HAMPT
TWP.
CITY TWP
324.52
1021.79
10-00-005-101- PRIOR INST.
C=1:83,333. DAVID L. ELWELL REG. SURV.
SURVEY MAP BY:
KS ASSOC.
101
9/20/90
#19041
APPROVED
LORAIN CO.
MAP DEPT.
DATE 7-16-90
PAGE A-00-005A
BY FRANCIS
VOID AFTER # 19041