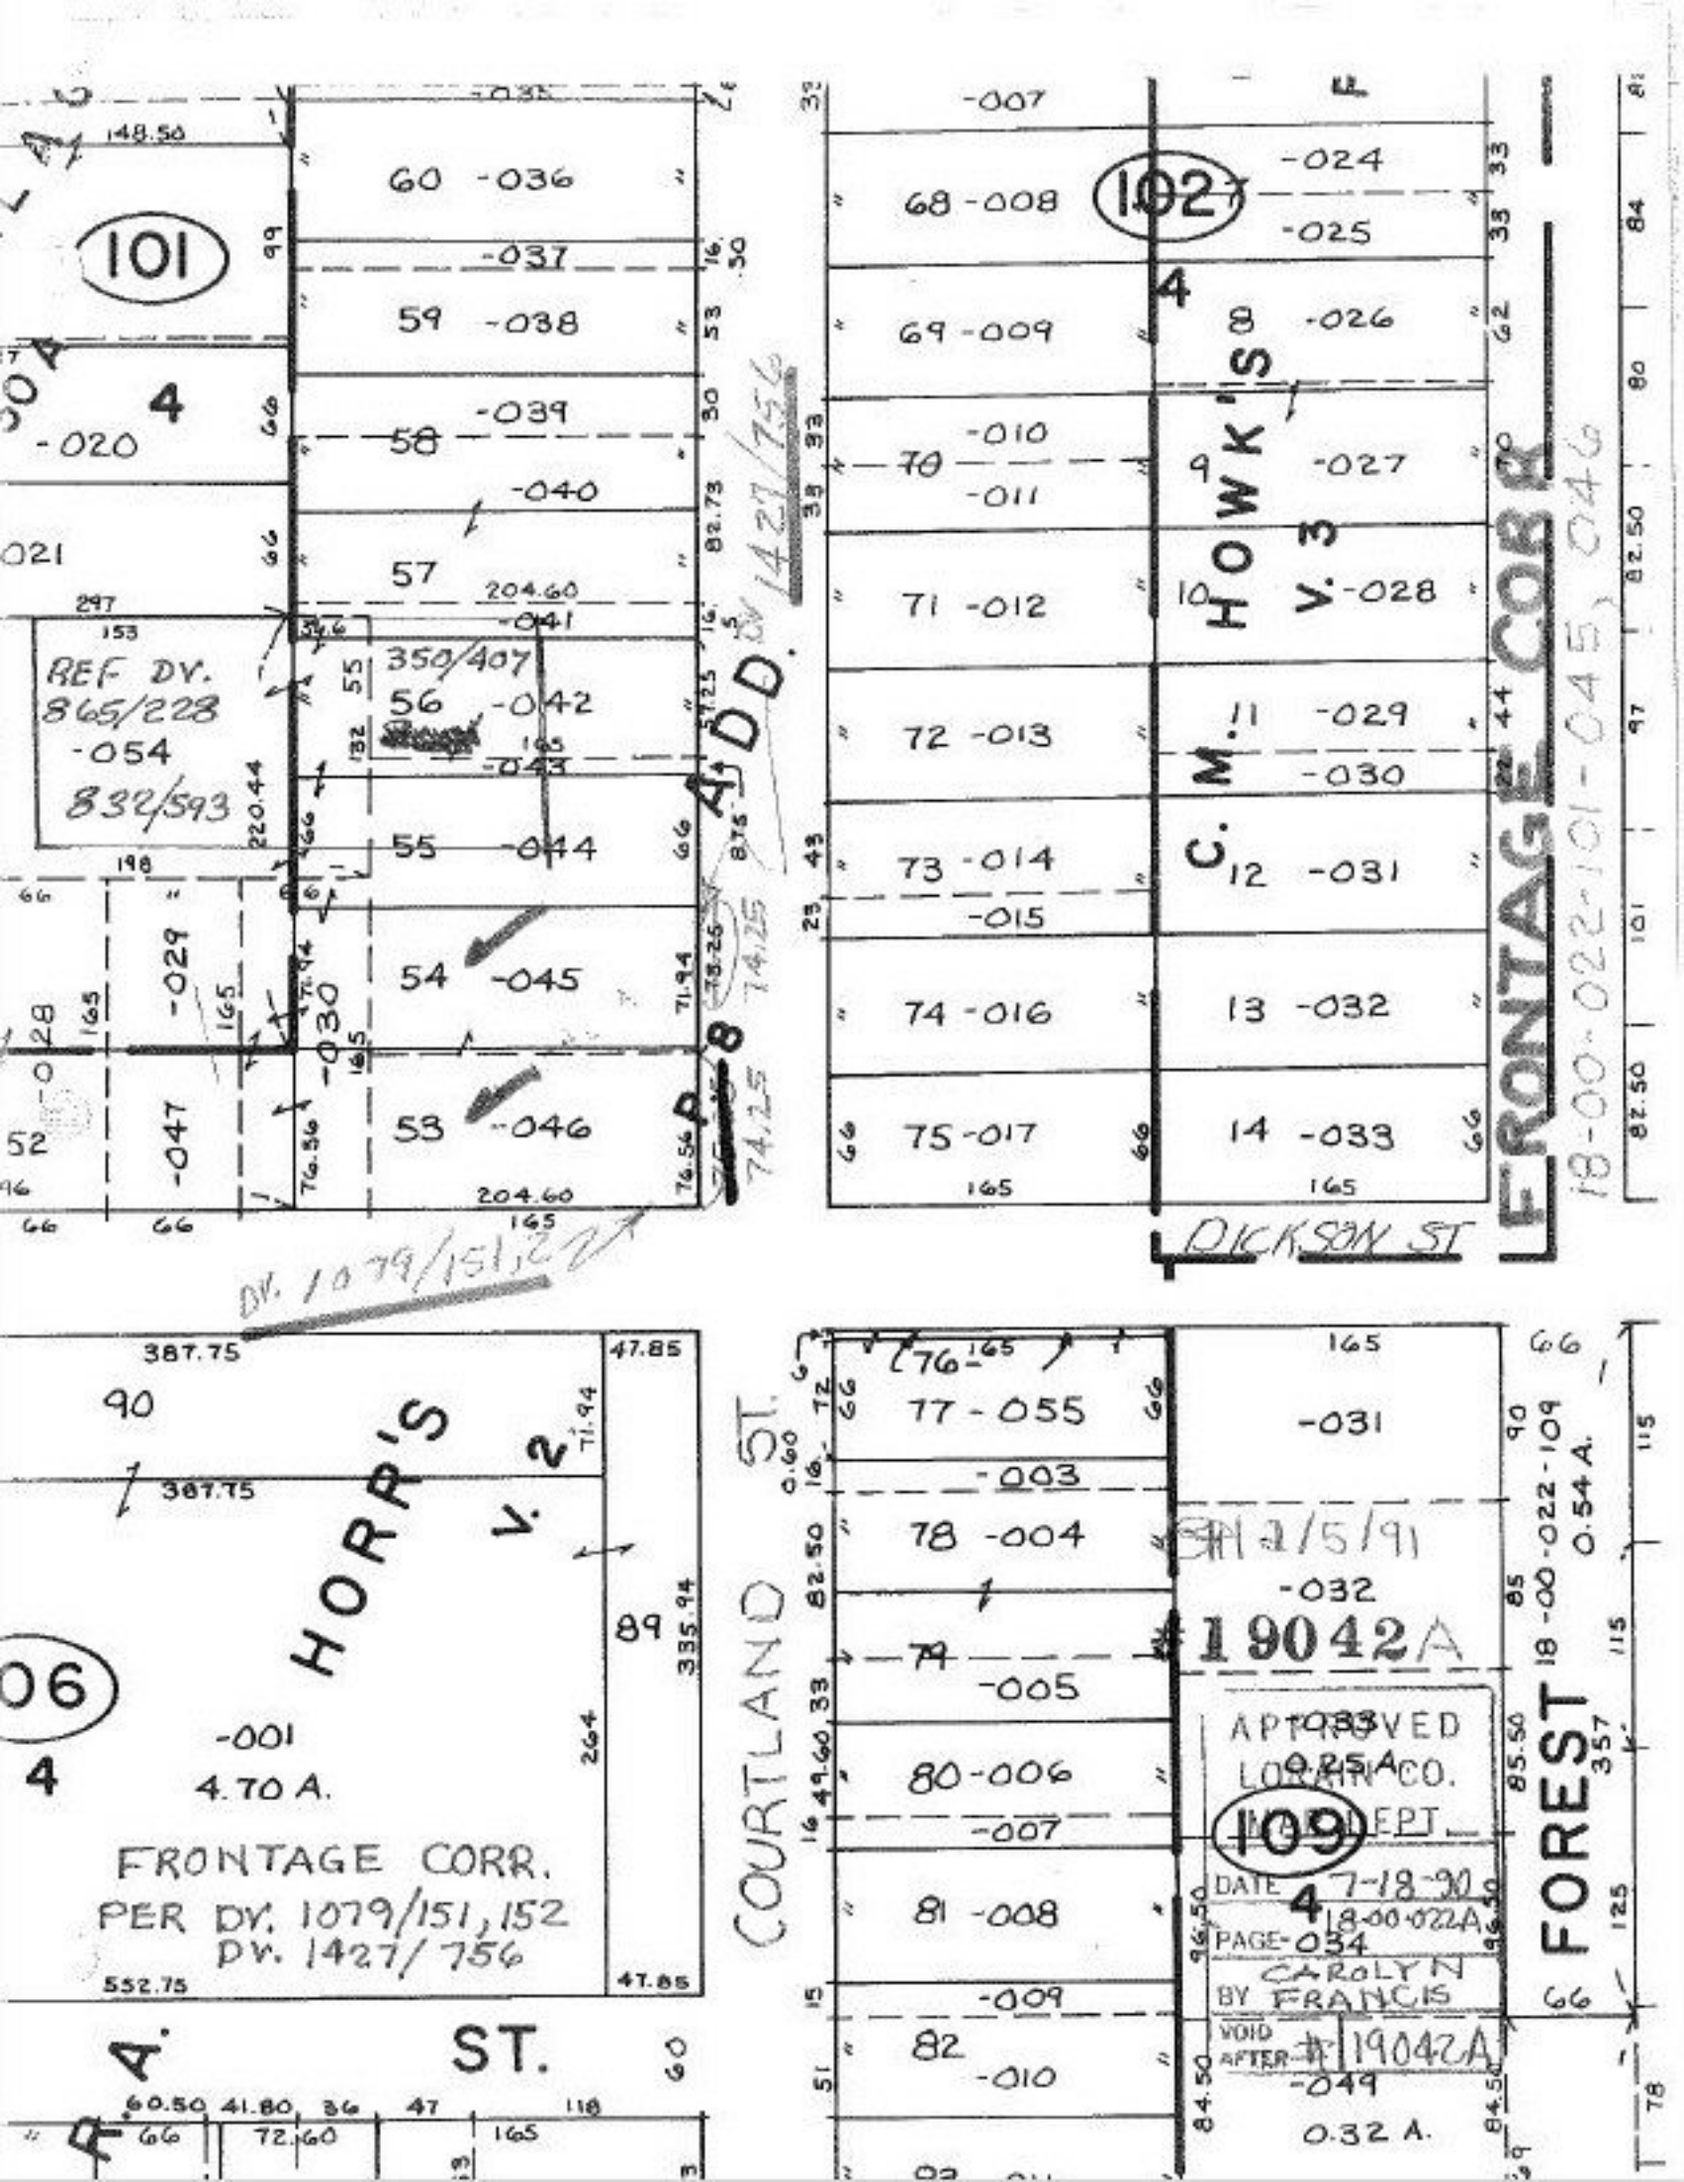

101
102
106
109
4
REF DV. 865/228 -054 832/593
350/407
DV. 1079/151,152
DV. 1427/756
P.B. ADD.
C. M. HOWK'S V. 3
DICKSON ST
FRONTAGE CORR
18-00-022-101-045, 046
HORR'S V. 2
FRONTAGE CORR. PER DV. 1079/151, 152 DV. 1427/756
COURTLAND ST.
FOREST
18-00-022-109 0.54 A.
#19042A
APPROVED LORAIN CO. MAP DEPT.
DATE 7-18-90
PAGE 034
BY CAROLYN FRANCIS
VOID AFTER #19042A