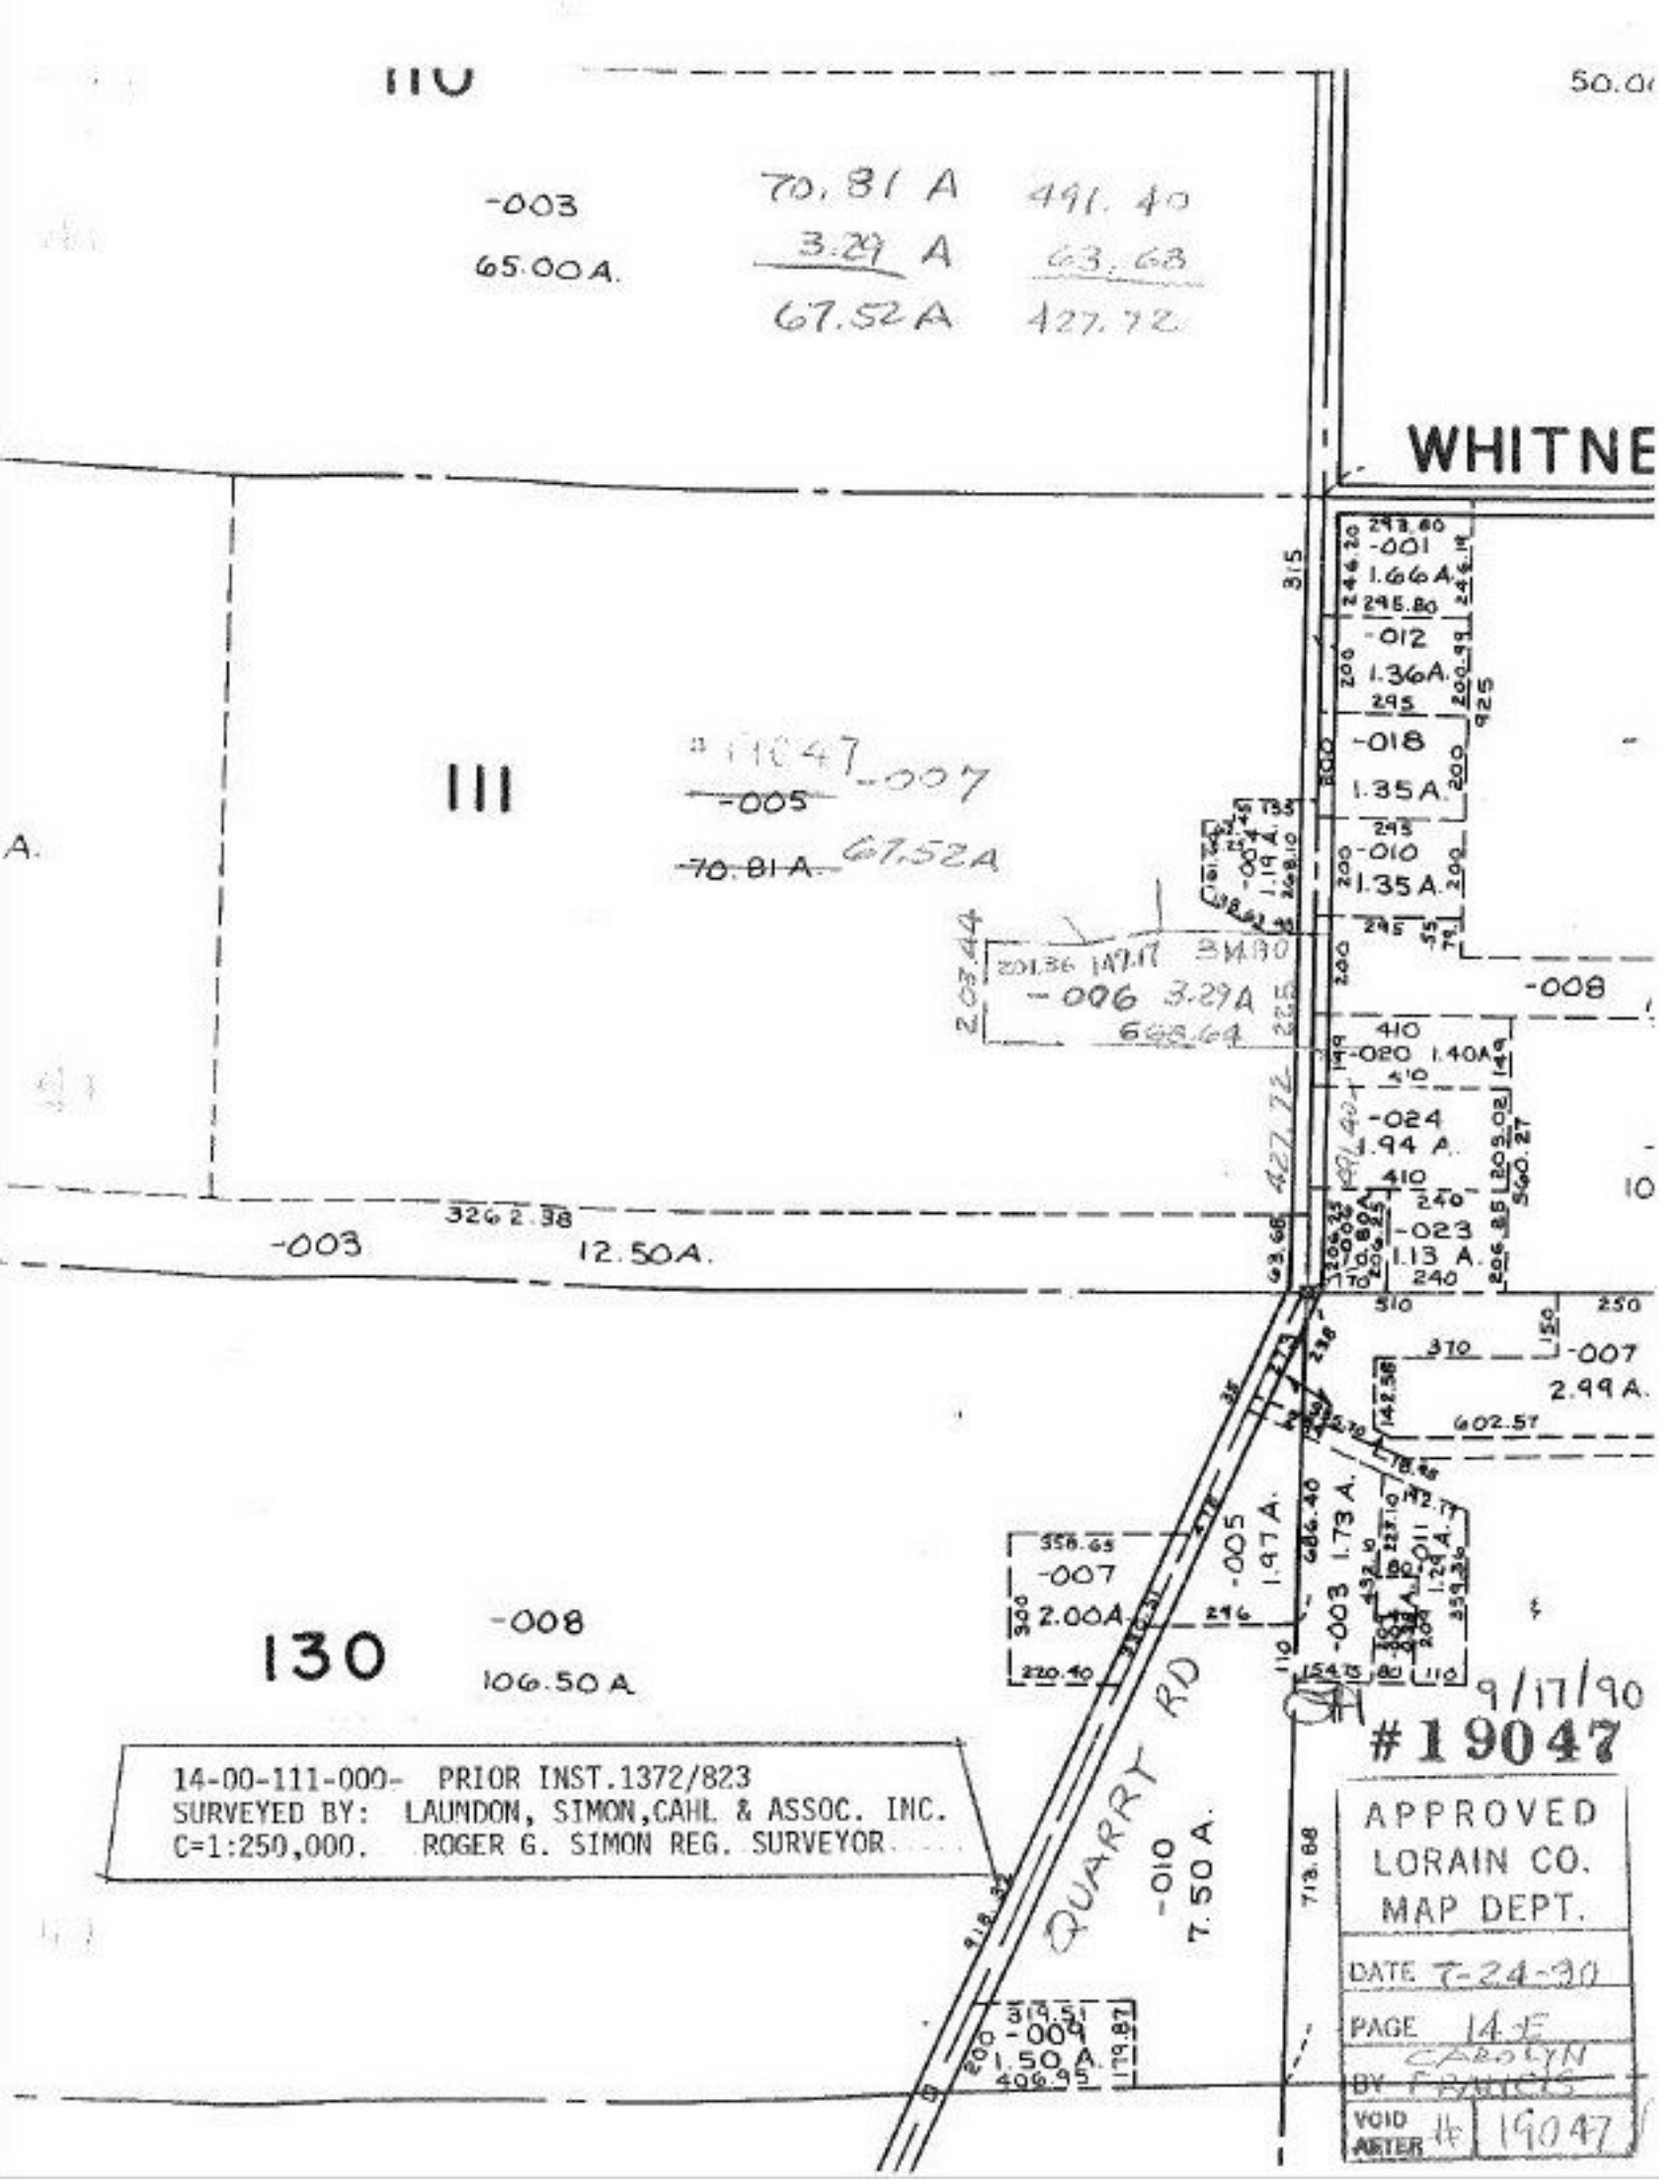
110
-003
65.00A.
70.81 A 491.40
3.29 A 63.68
67.52A 427.72
WHITNE
111
-005
70.81A
67.52A
-007
-006 3.29A
-001 1.66A.
-012 1.36A.
-018 1.35A.
-010 1.35A.
-008
-020 1.40A
-024 1.94 A.
-023 1.13 A.
-007 2.99A.
-005 1.97A.
-003 1.73 A.
-011 1.24 A.
-010 7.50 A.
-009 1.50 A.
12.50A.
130
-008
106.50 A
-007 2.00A
QUARRY RD
14-00-111-000- PRIOR INST.1372/823
SURVEYED BY: LAUNDON, SIMON, CAHL & ASSOC. INC.
C=1:250,000. ROGER G. SIMON REG. SURVEYOR
9/17/90
#19047
APPROVED
LORAIN CO.
MAP DEPT.
DATE 7-24-90
PAGE 14E
BY CAROLYN FRANCIS
VOID AFTER # 19047