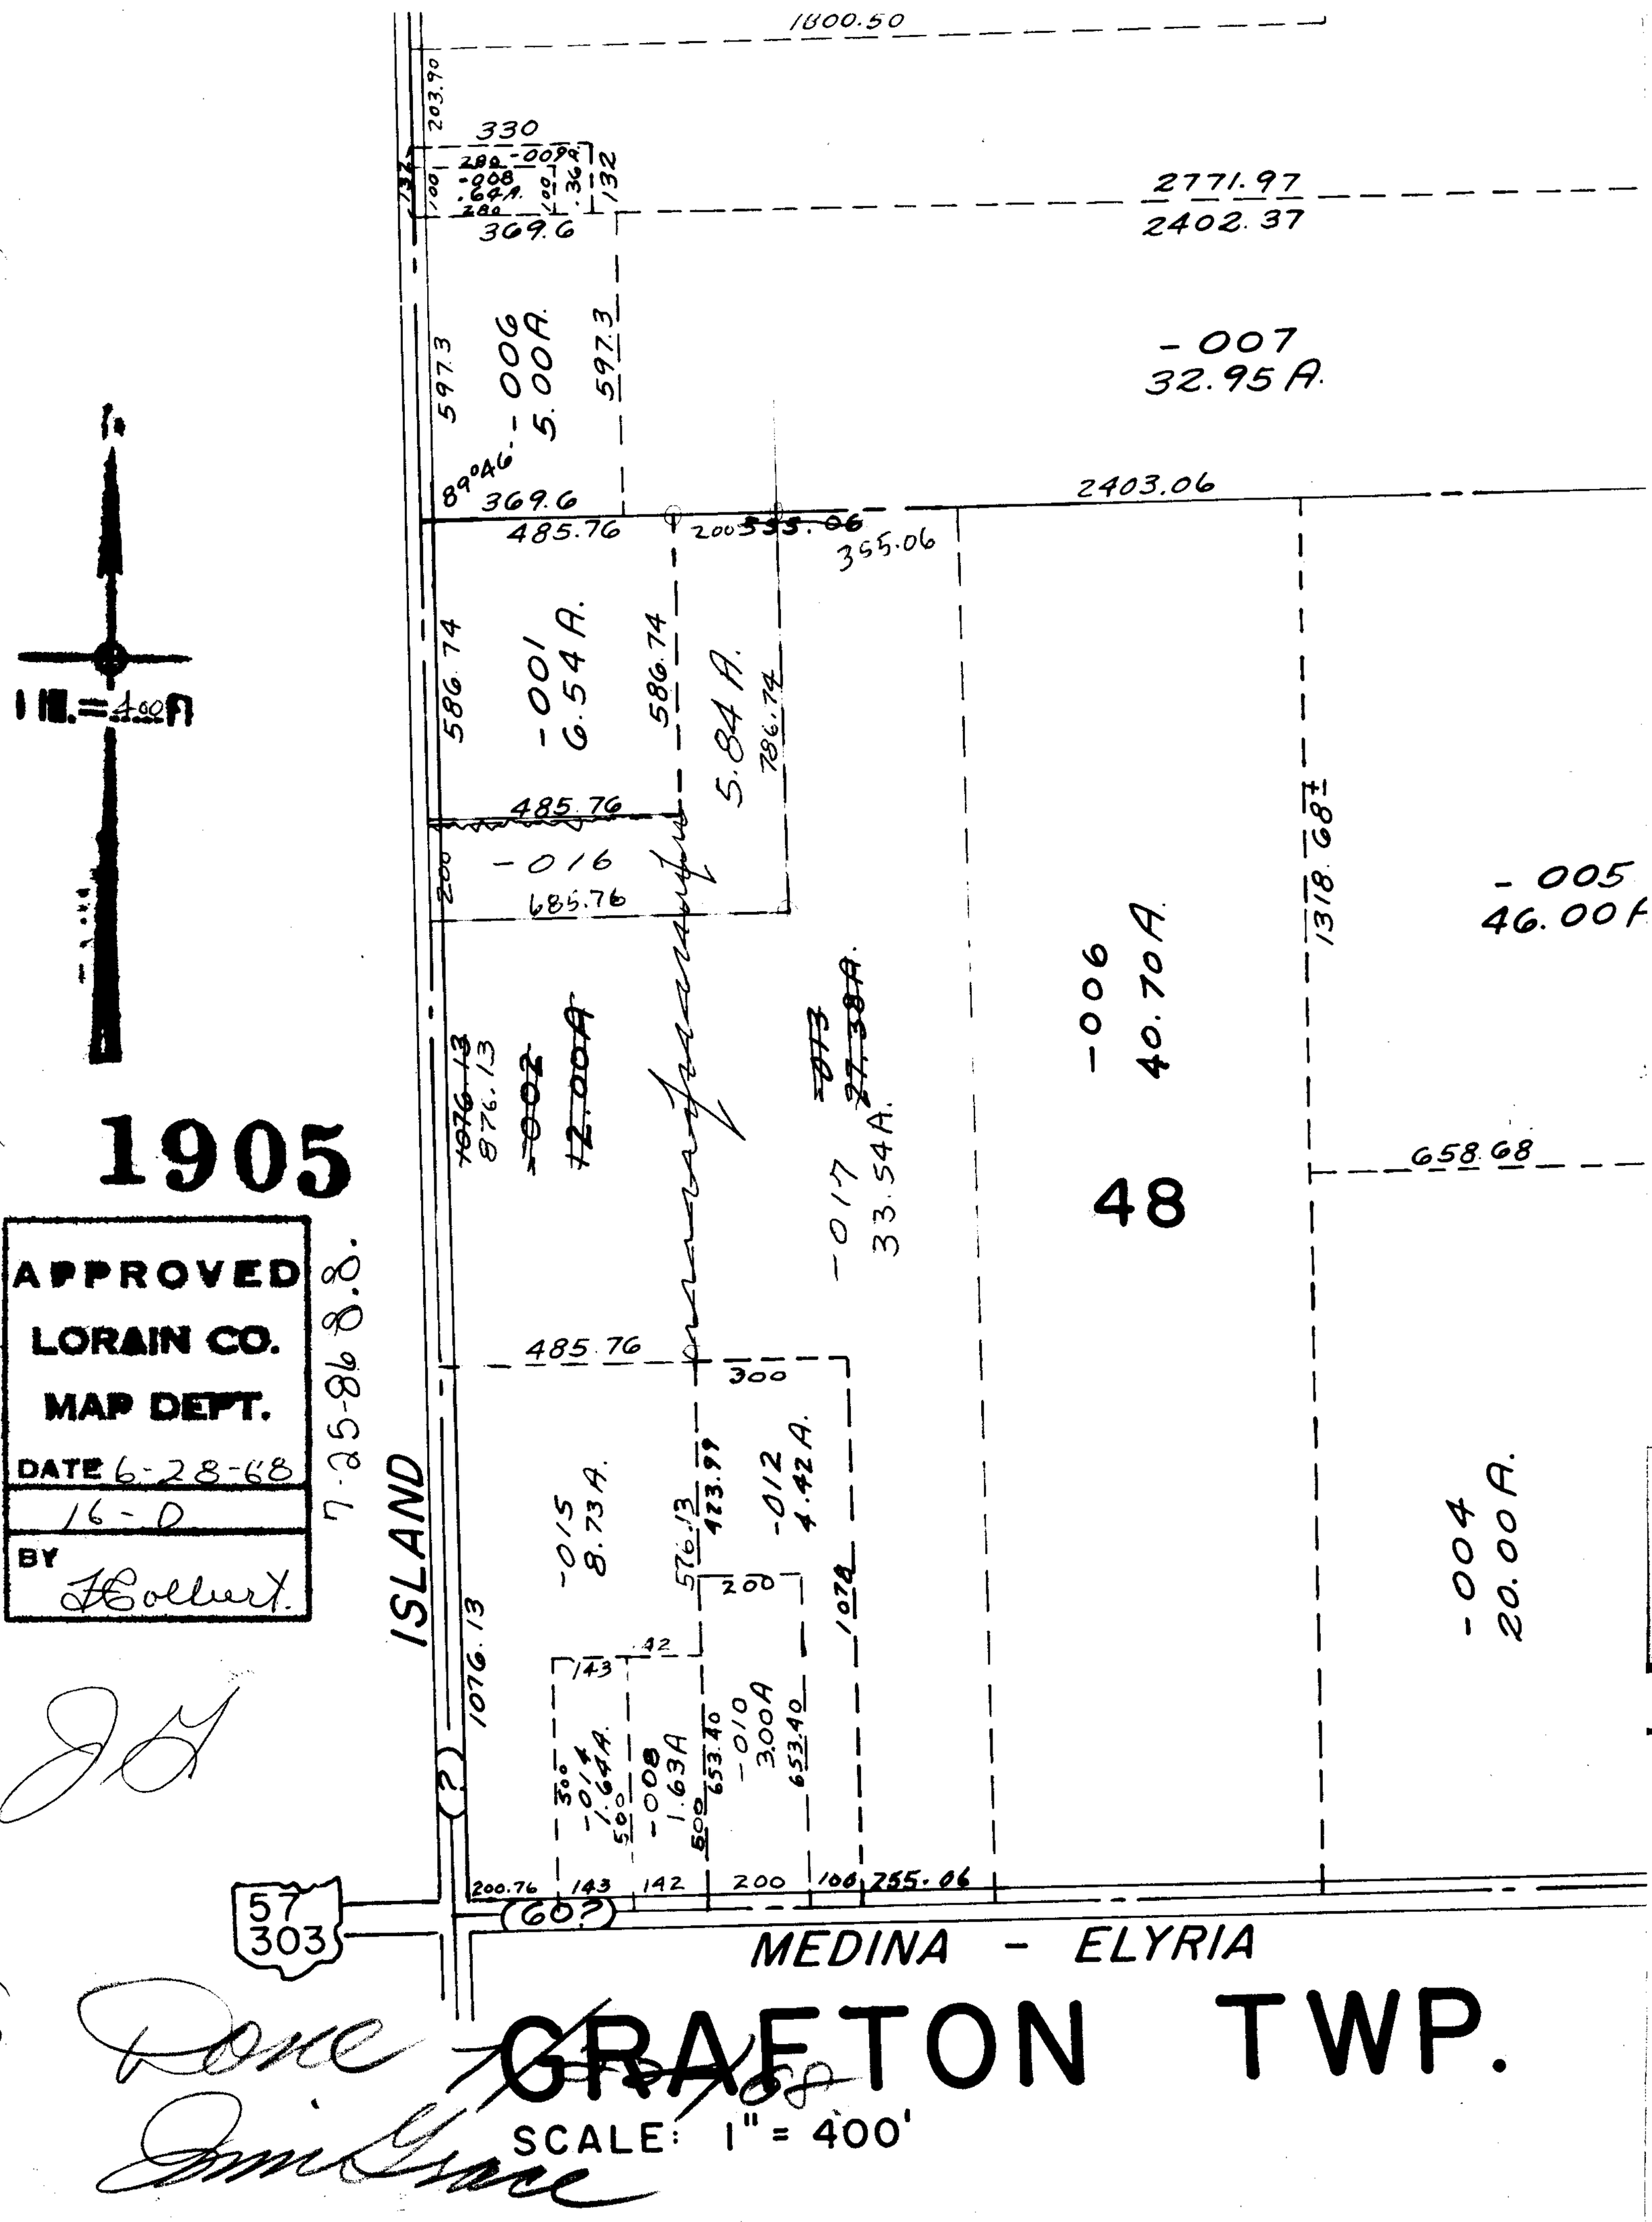
1800.50
2771.97
2402.37
-007
32.95 A.
2403.06
355.06
-001
6.54 A.
5.84 A.
-016
-006
40.70 A.
-005
46.00 A.
658.68
48
-017
33.54 A.
-015
8.73 A.
-012
4.42 A.
-014
1.64 A.
-008
1.63 A
-010
3.00 A
-004
20.00 A.
ISLAND
MEDINA - ELYRIA
57
303
60
1 IN. = 400 FT.
1905
APPROVED
LORAIN CO.
MAP DEPT.
DATE 6-28-68
16-D
BY H. Colbert
7-25-86 8.8.
GRAFTON TWP.
SCALE: 1" = 400'