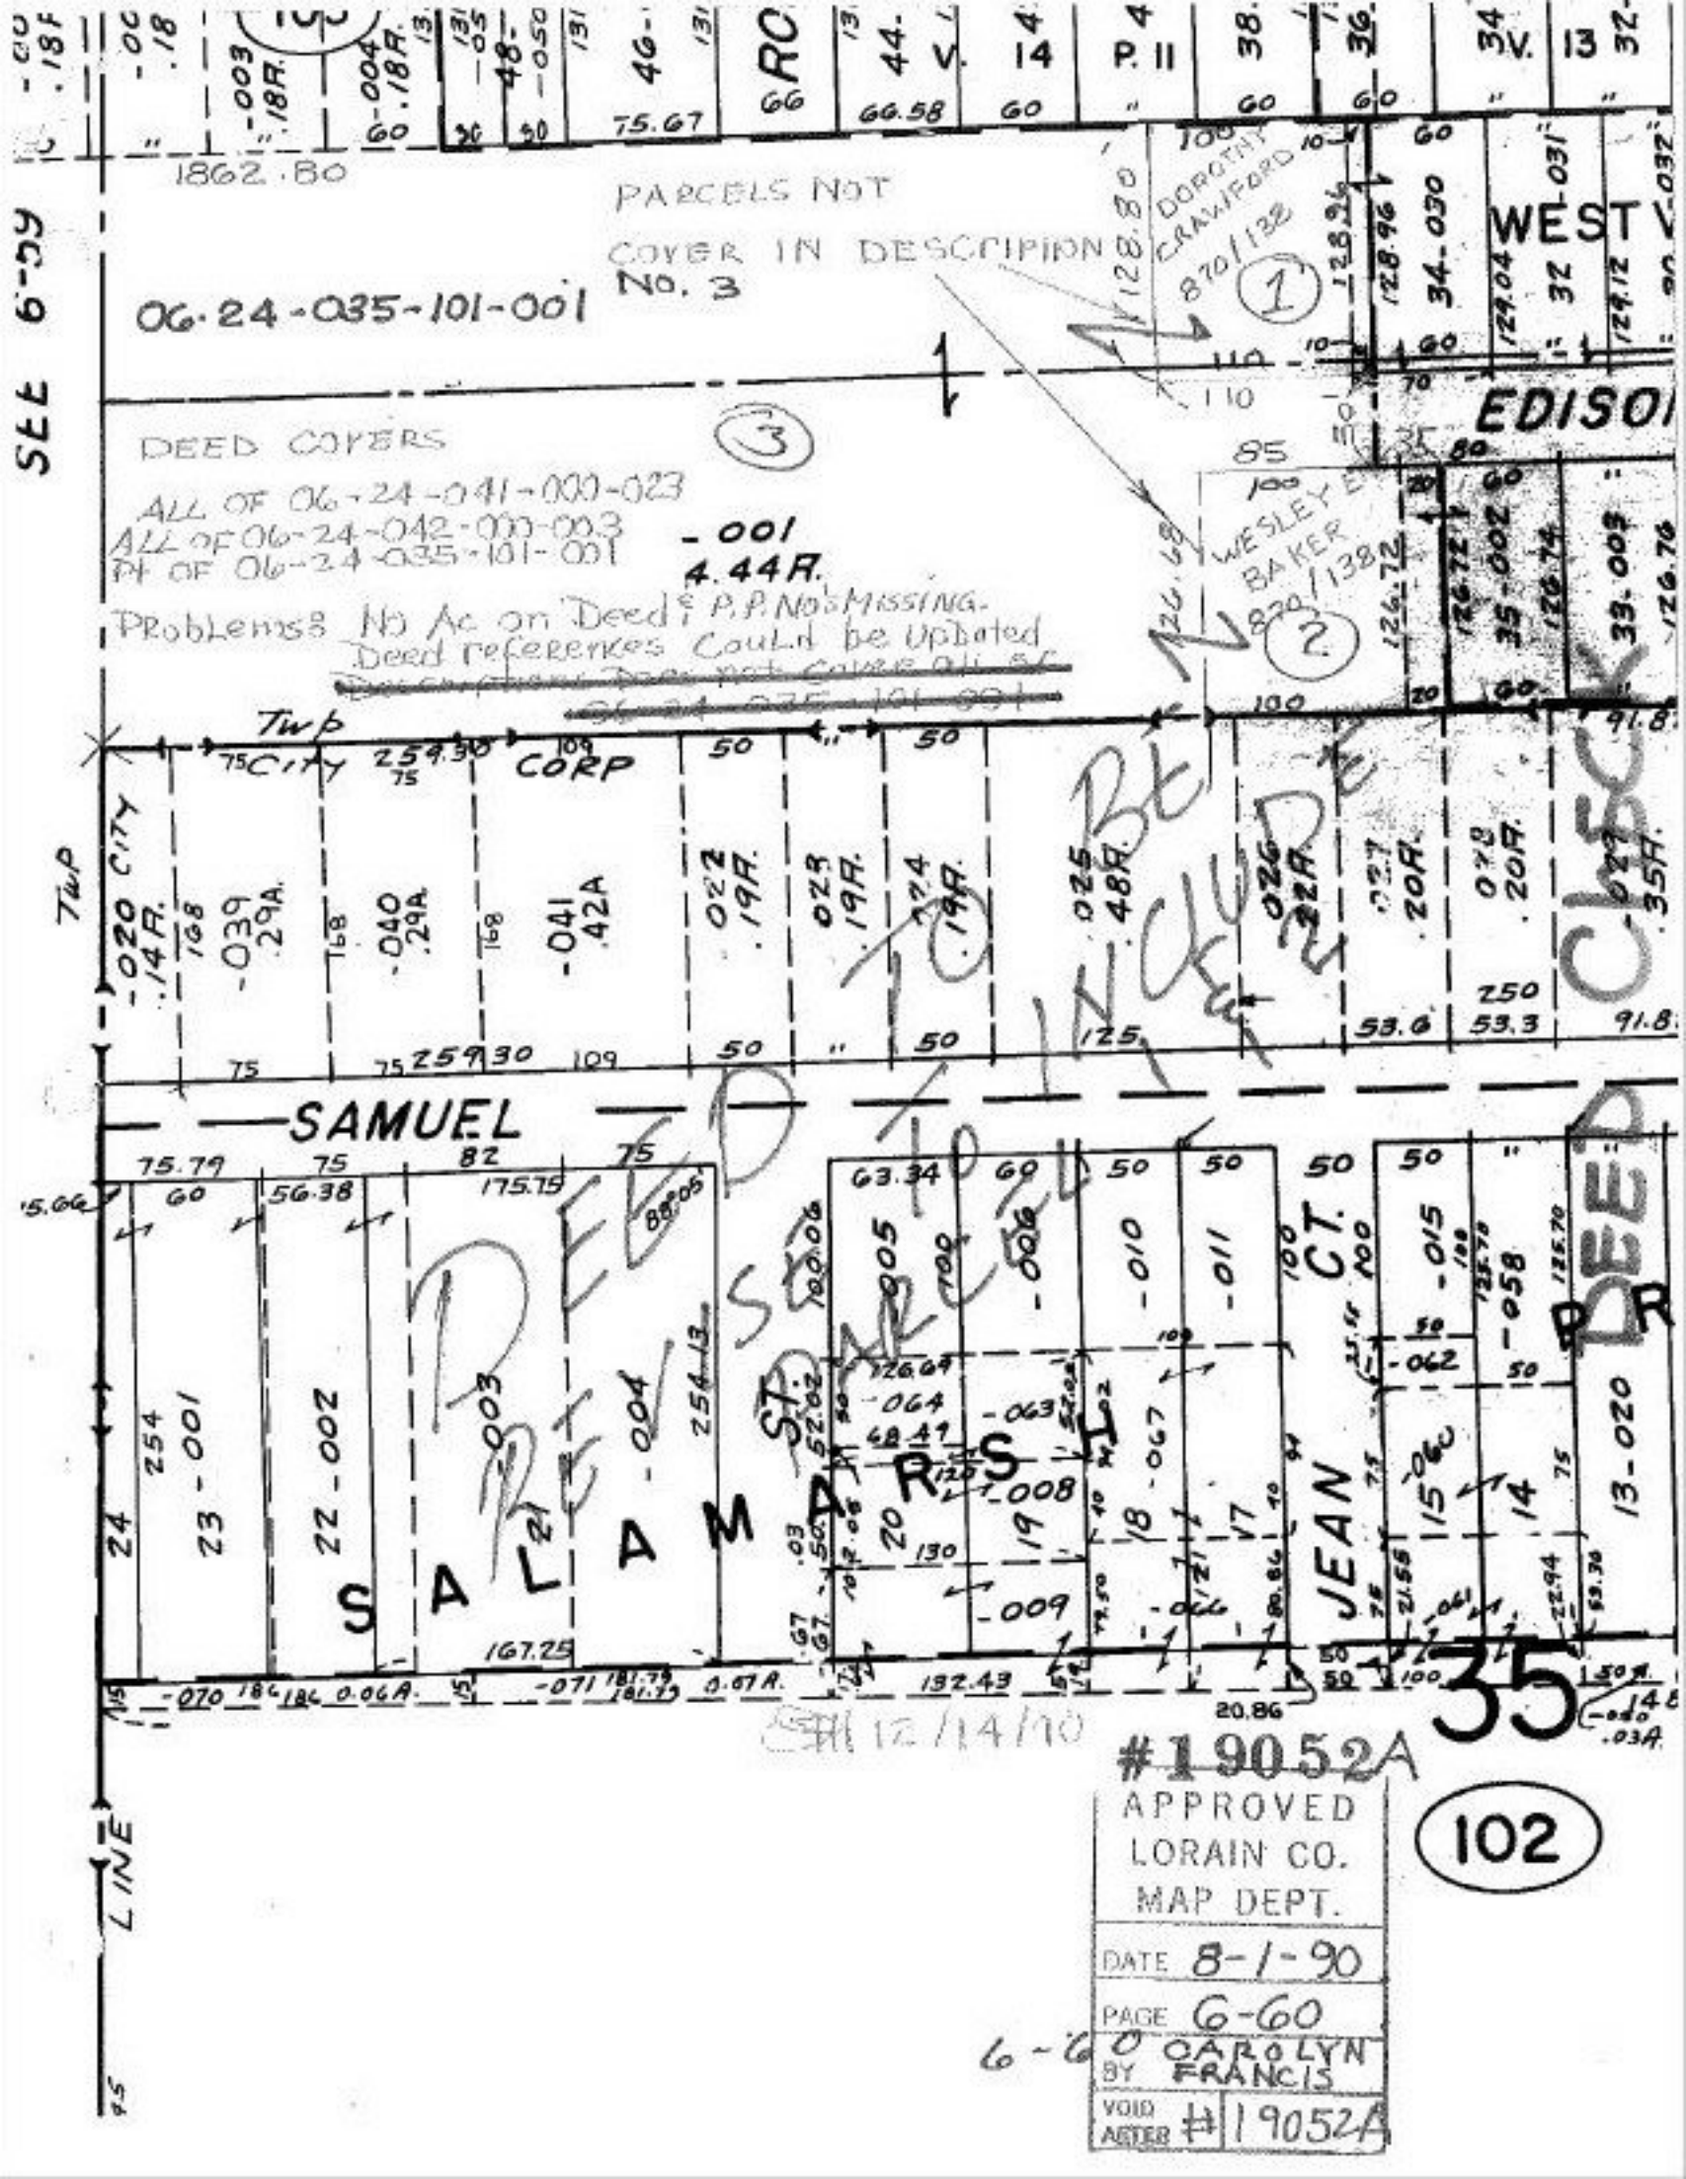

SEE 6-59
PARCELS NOT COVER IN DESCRIPTION No. 3
06-24-035-101-001
DEED COVERS
ALL OF 06-24-041-000-023
ALL OF 06-24-042-000-003
Pt OF 06-24-035-101-001
-001
4.44A.
Problems: No Ac on Deed & P.P. No's Missing.
Deed references Could be Updated
DOROTHY CRAWFORD 870/138
WESLEY E. BAKER 870/138
WEST
EDISON
SAMUEL
SALAMARSH
JEAN CT.
DEED TO BE REVISED TO INCLUDE PARCEL
DEED CHECK
LINE
35
#19052A
APPROVED
LORAIN CO.
MAP DEPT.
DATE 8-1-90
PAGE 6-60
BY CAROLYN FRANCIS
VOID AFTER #19052A
102
6-60