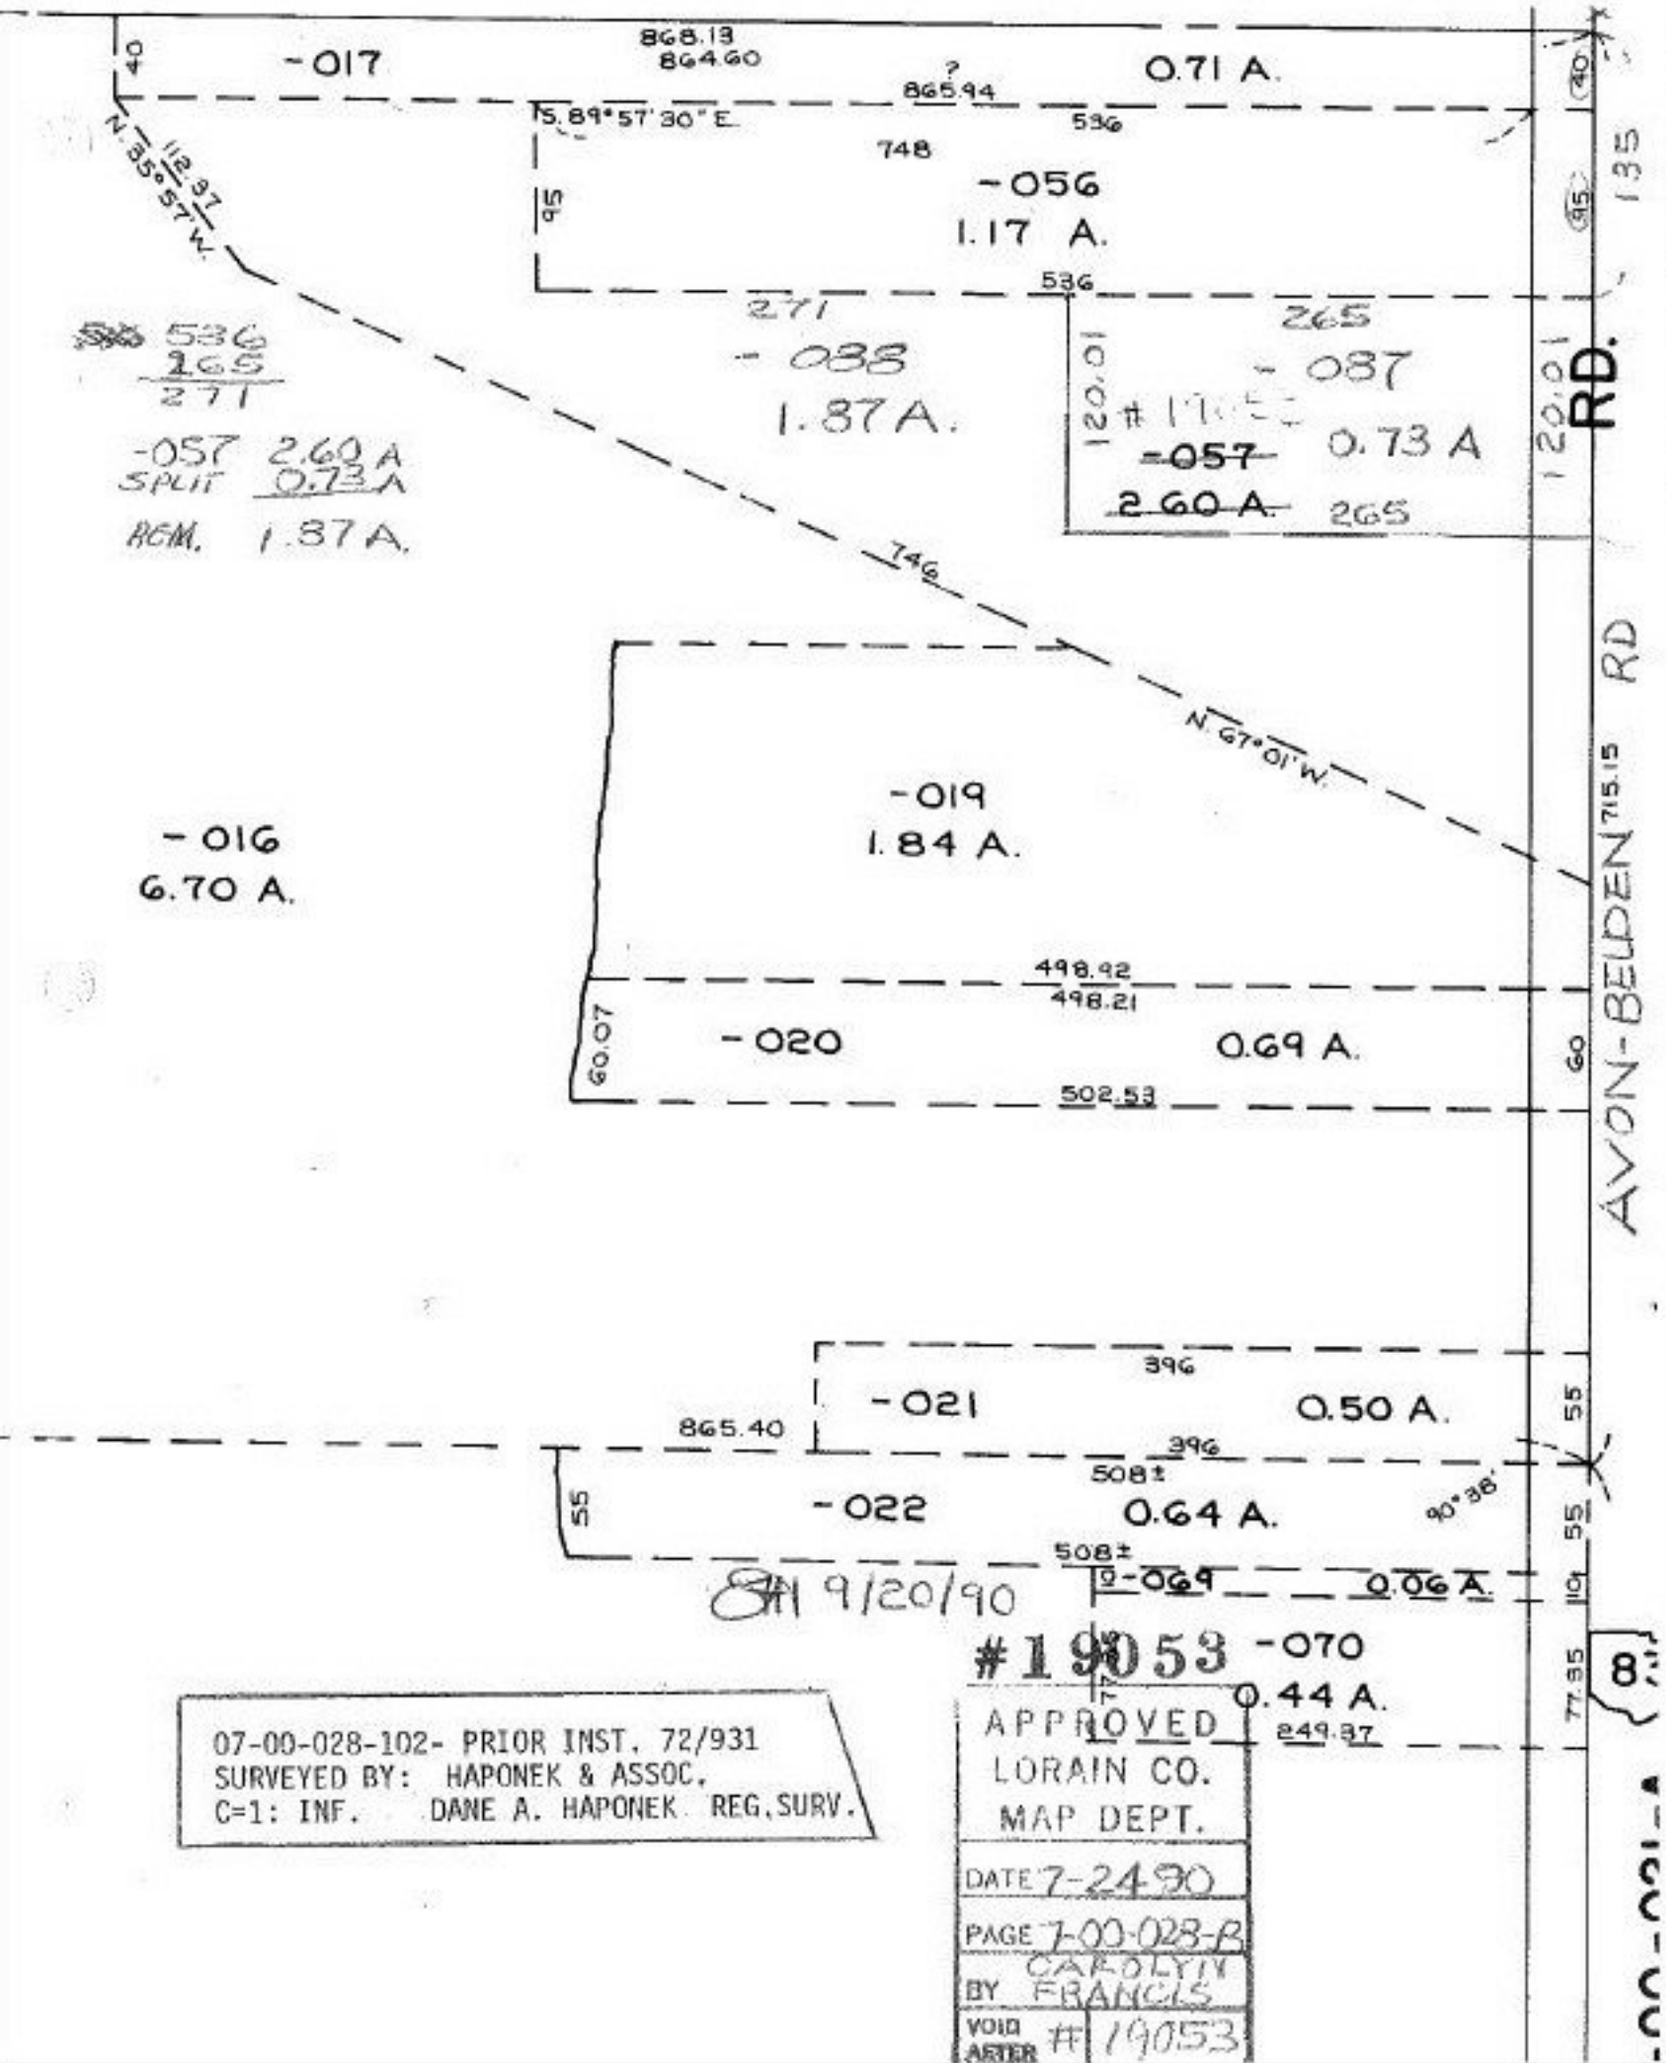

-017
868.13
864.60
865.94
0.71 A.
S.89°57'30"E.
536
748
-056
1.17 A.
536
271
-088
1.87 A.
265
-087
0.73 A
~~-057~~
~~2.60 A.~~
265
120.01
120.01
RD.
135
536
265
271
-057 2.60 A
SPLIT 0.73 A
REM. 1.87 A.
746
N.67°01'W.
-019
1.84 A.
-016
6.70 A.
715.15
AVON-BELDEN RD
498.92
498.21
60.07
-020
0.69 A.
502.53
396
-021
0.50 A.
865.40
396
508±
-022
0.64 A.
90°38'
508±
-069
0.06 A.
9/20/90
#19053
-070
0.44 A.
249.37
77.35
07-00-028-102- PRIOR INST. 72/931
SURVEYED BY: HAPONEK & ASSOC.
C=1: INF. DANE A. HAPONEK REG.SURV.
APPROVED
LORAIN CO.
MAP DEPT.
DATE 7-24-90
PAGE 7-00-028-B
BY CAROLYN FRANCIS
VOID AFTER # 19053