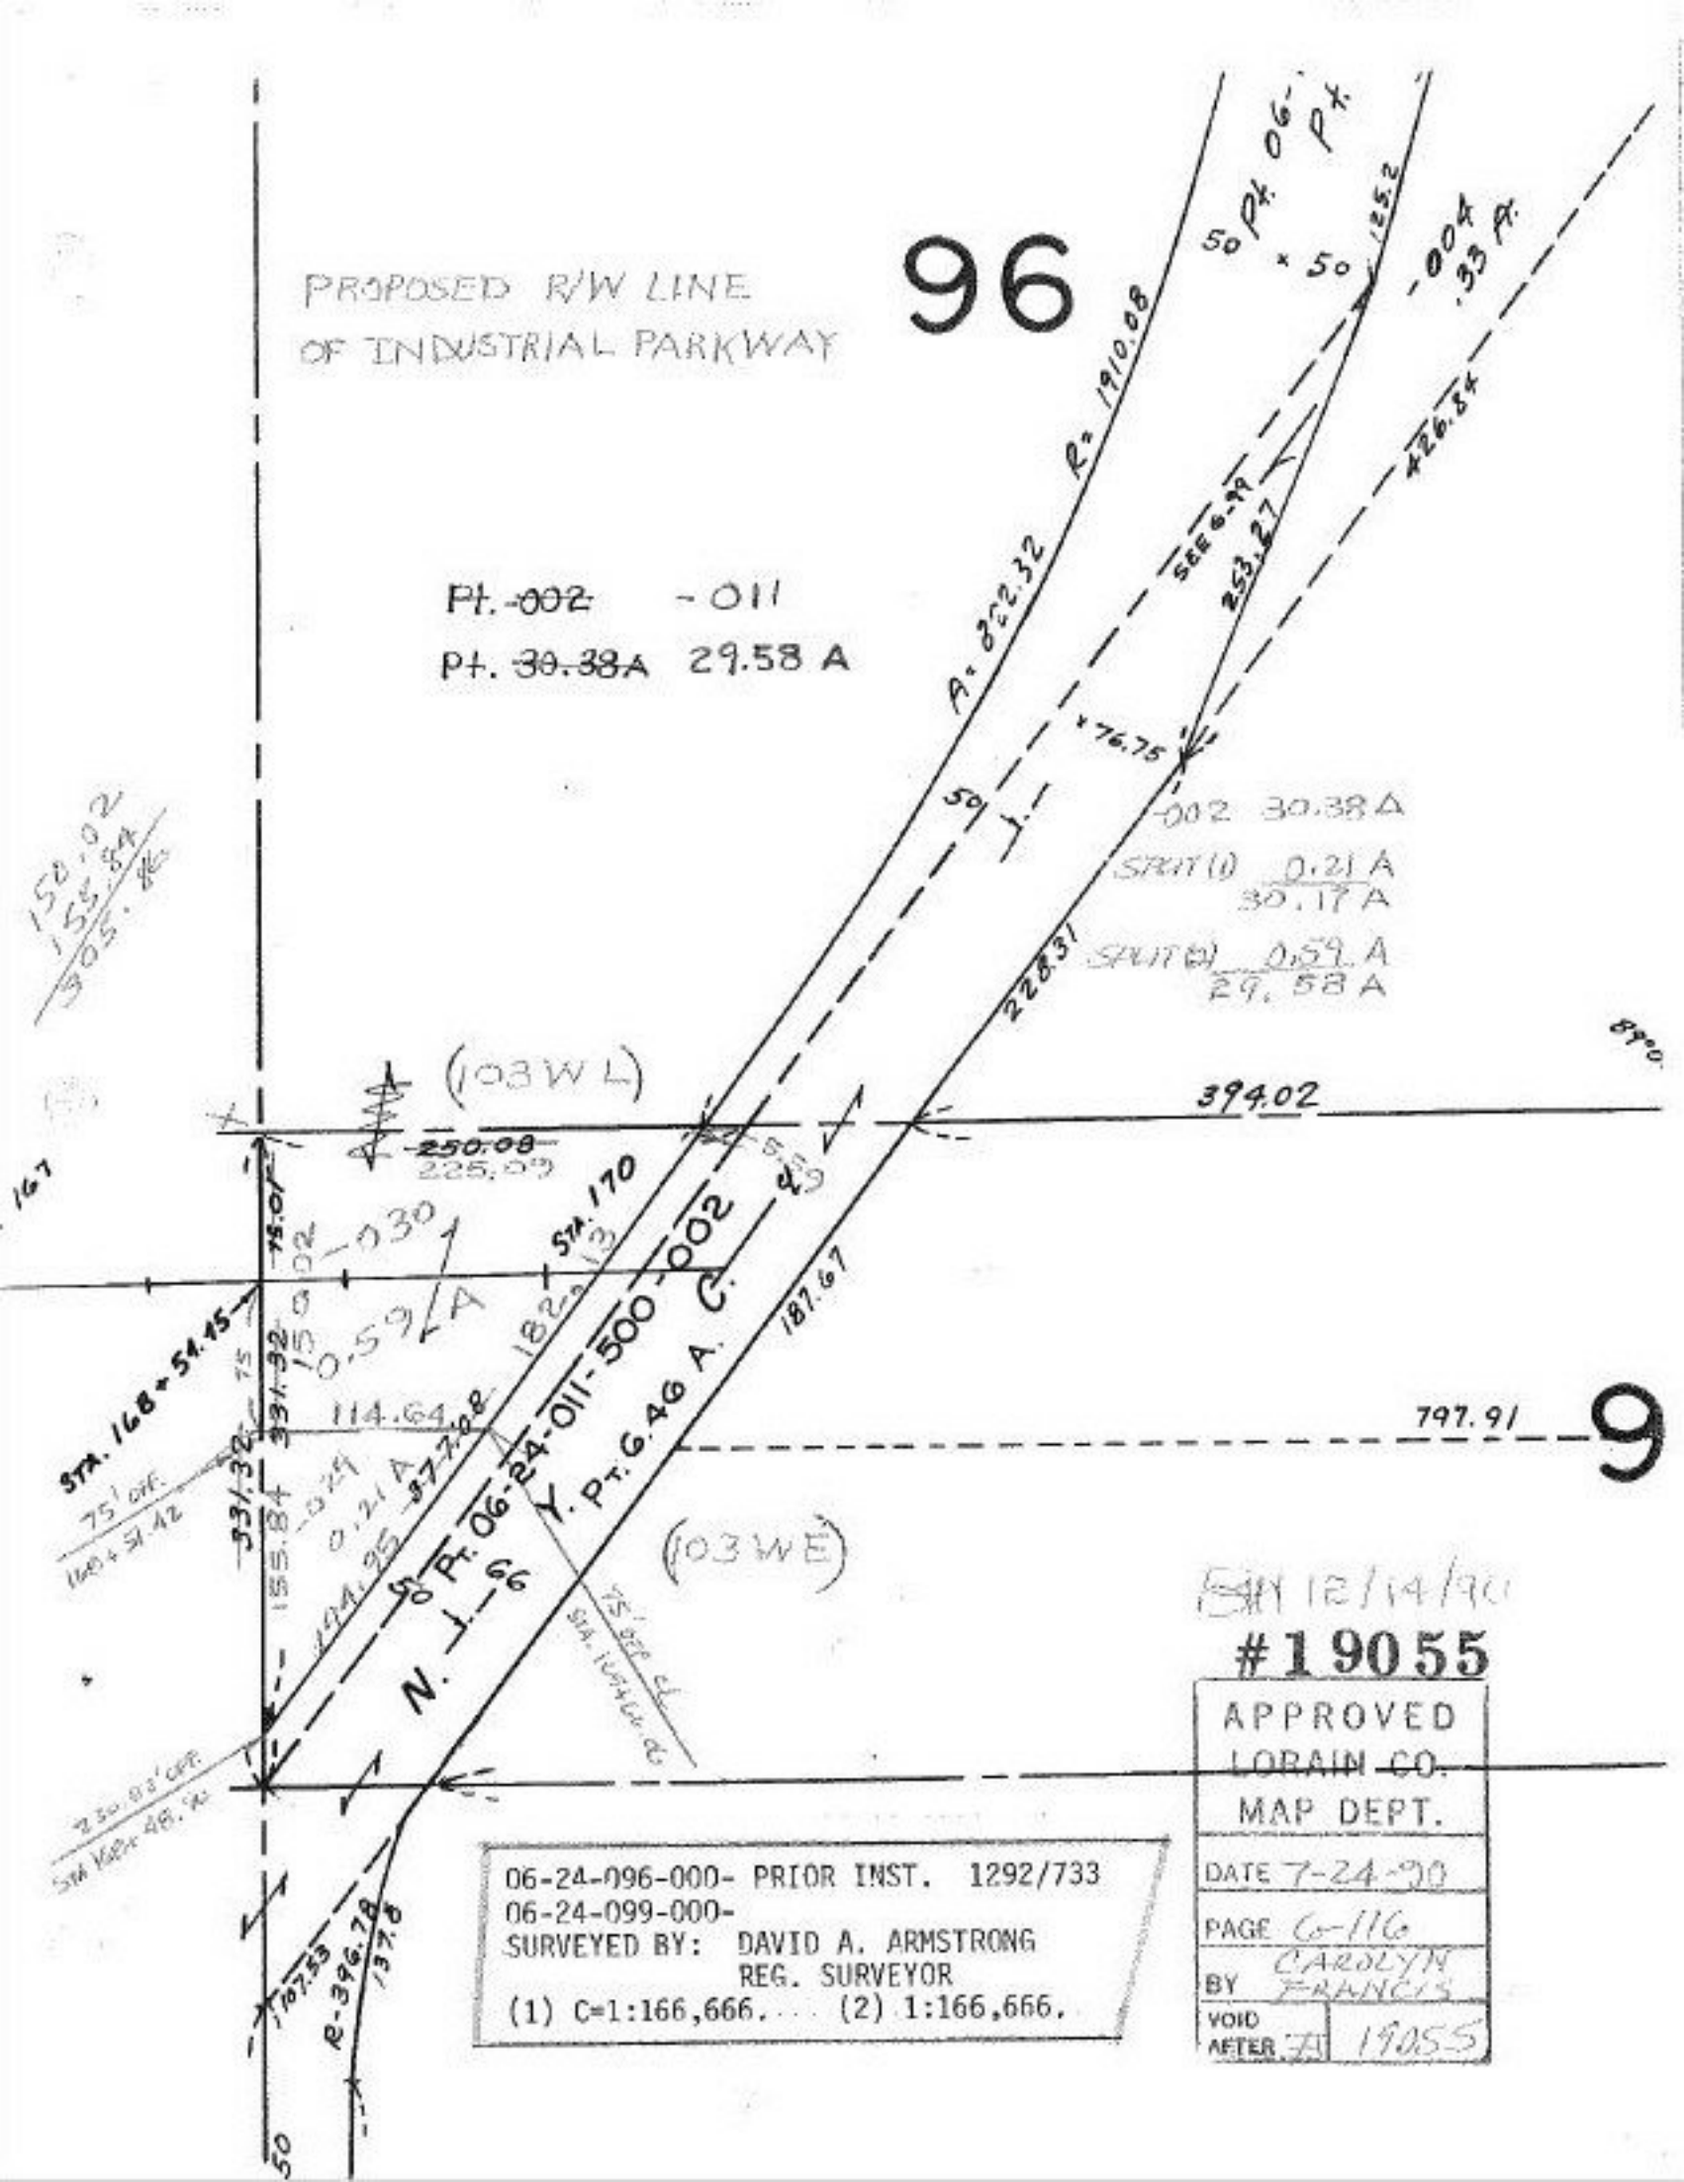
PROPOSED R/W LINE
OF INDUSTRIAL PARKWAY
96
Pt. -002 -011
Pt. 30.38A 29.58 A
(103WL)
394.02
797.91
9
(103WE)
N. J.-66
Y. Pt. 6.46 A.
-500
-002
-011
-030
0.59 A
0.21 A
114.64
331.32
155.84
187.67
228.31
253.27
426.84
R= 1910.08
A= 8°22.32
SEE 6-99
STA. 168+54.15
STA. 170
75' OFF.
75' RT. ℄
-004 .33 A.
50 Pt. 06-
+50 125.2
+76.75
-002 30.38 A
SPLIT (1) 0.21 A
30.17 A
SPLIT (2) 0.59 A
29.58 A
#19055
APPROVED
LORAIN CO.
MAP DEPT.
DATE 7-24-90
PAGE 6-116
BY CAROLYN FRANCIS
VOID AFTER 7-1 19055
06-24-096-000- PRIOR INST. 1292/733
06-24-099-000-
SURVEYED BY: DAVID A. ARMSTRONG
REG. SURVEYOR
(1) C=1:166,666. . . . (2) 1:166,666.