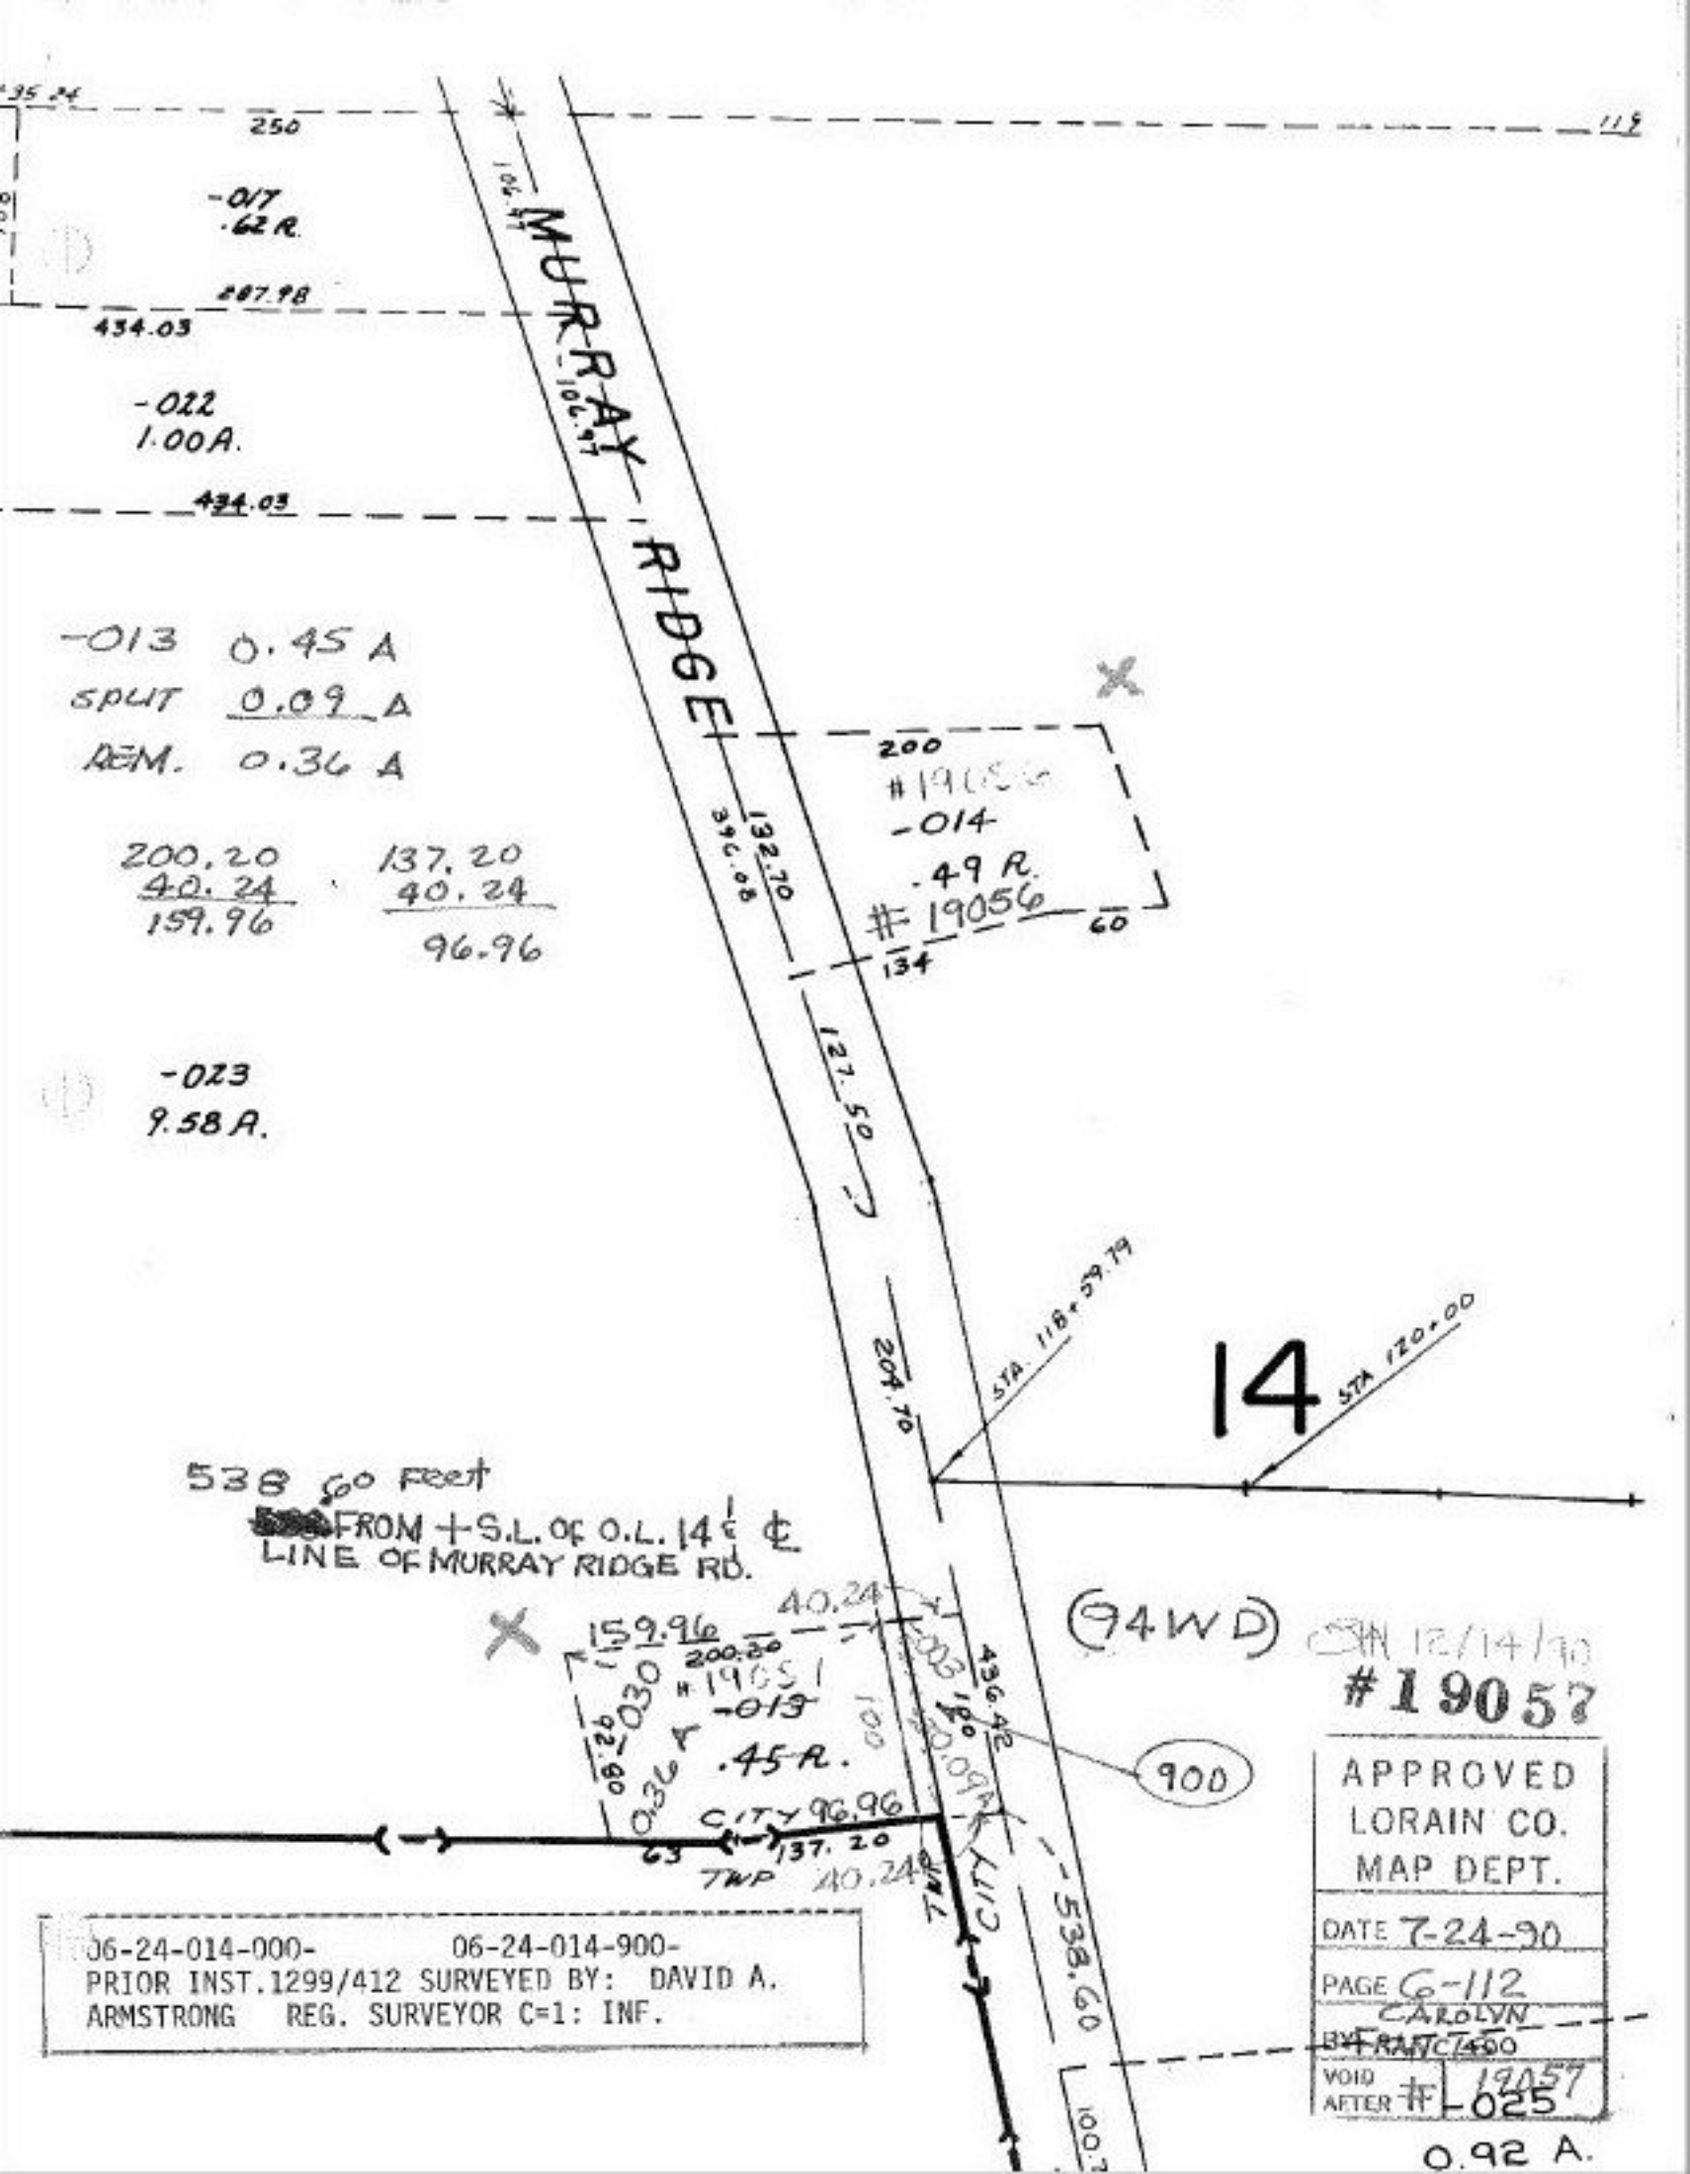
MURRAY RIDGE
250
-017
.62 R.
287.98
434.03
-022
1.00A.
434.03
-013 0.45 A
SPLIT 0.09 A
REM. 0.36 A
200.20
40.24
159.96
137.20
40.24
96.96
-023
9.58 A.
102.97
132.70
396.08
200
#19056
-014
.49 R.
#19056
60
134
127.50
204.70
STA. 118+59.79
STA. 120+00
14
538.60 Feet
FROM +S.L. of O.L. 14 & LINE OF MURRAY RIDGE RD.
(94WD)
12/14/90
#19057
159.96
200.20
#19055
-013
.45 R.
0.36 A
92.90
40.24
436.42
100
100
900
CITY 96.96
137.20
TWP 40.24
CITY
538.60
100.7
APPROVED
LORAIN CO.
MAP DEPT.
DATE 7-24-90
PAGE G-112
BY CAROLYN FRANC 7490
VOID AFTER # 19057
-025
0.92 A.
06-24-014-000- 06-24-014-900-
PRIOR INST. 1299/412 SURVEYED BY: DAVID A. ARMSTRONG REG. SURVEYOR C=1: INF.