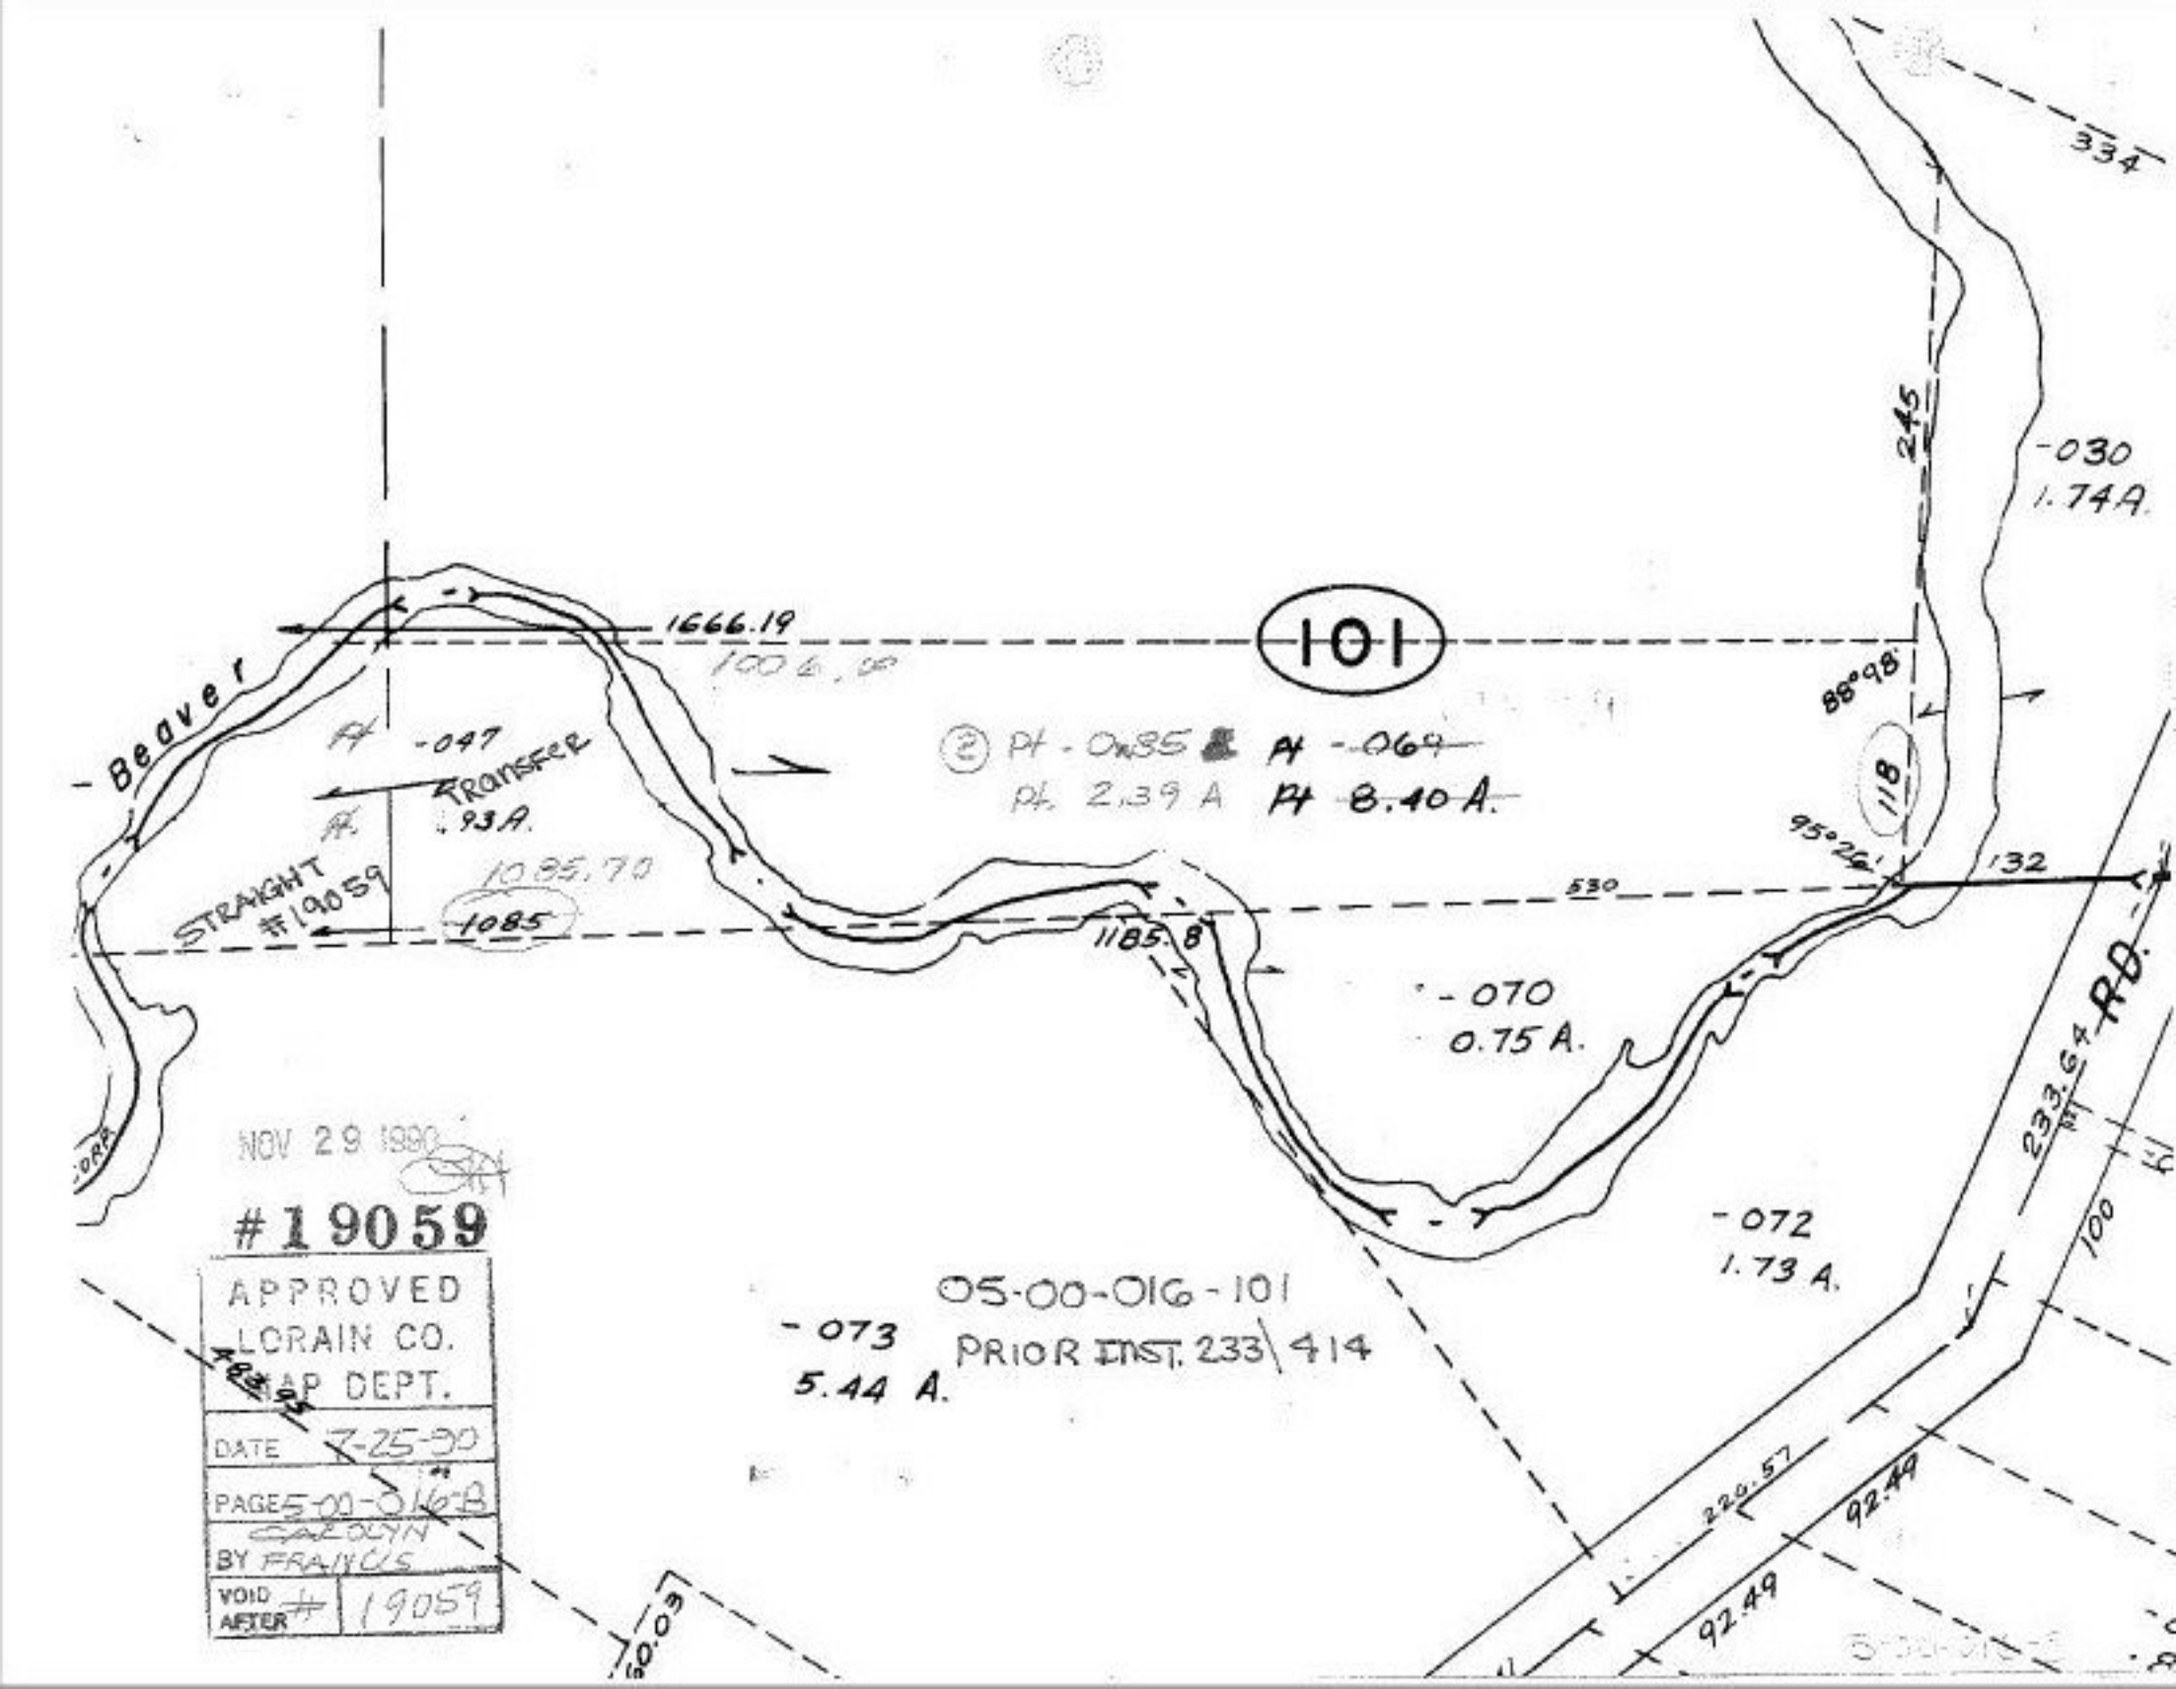
- Beaver
1666.19
1006.00
101
Pt -047
Transfer
.93A.
STRAIGHT
#19059
1085.70
1085
Pt - 0035 & Pt -064
Pt. 2.39 A Pt 8.40 A.
1185.8
530
88°98'
118
95°26'
132
245
334
-030
1.74A.
-070
0.75 A.
-072
1.73 A.
233.64 RD.
100
220.57
92.49
92.49
-073
5.44 A.
05-00-016-101
PRIOR INST. 233\414
NOV 29 1990
#19059
APPROVED
LORAIN CO.
MAP DEPT.
DATE 7-25-90
PAGES 00-016-B
BY CAROLYN FRANCIS
VOID AFTER # 19059