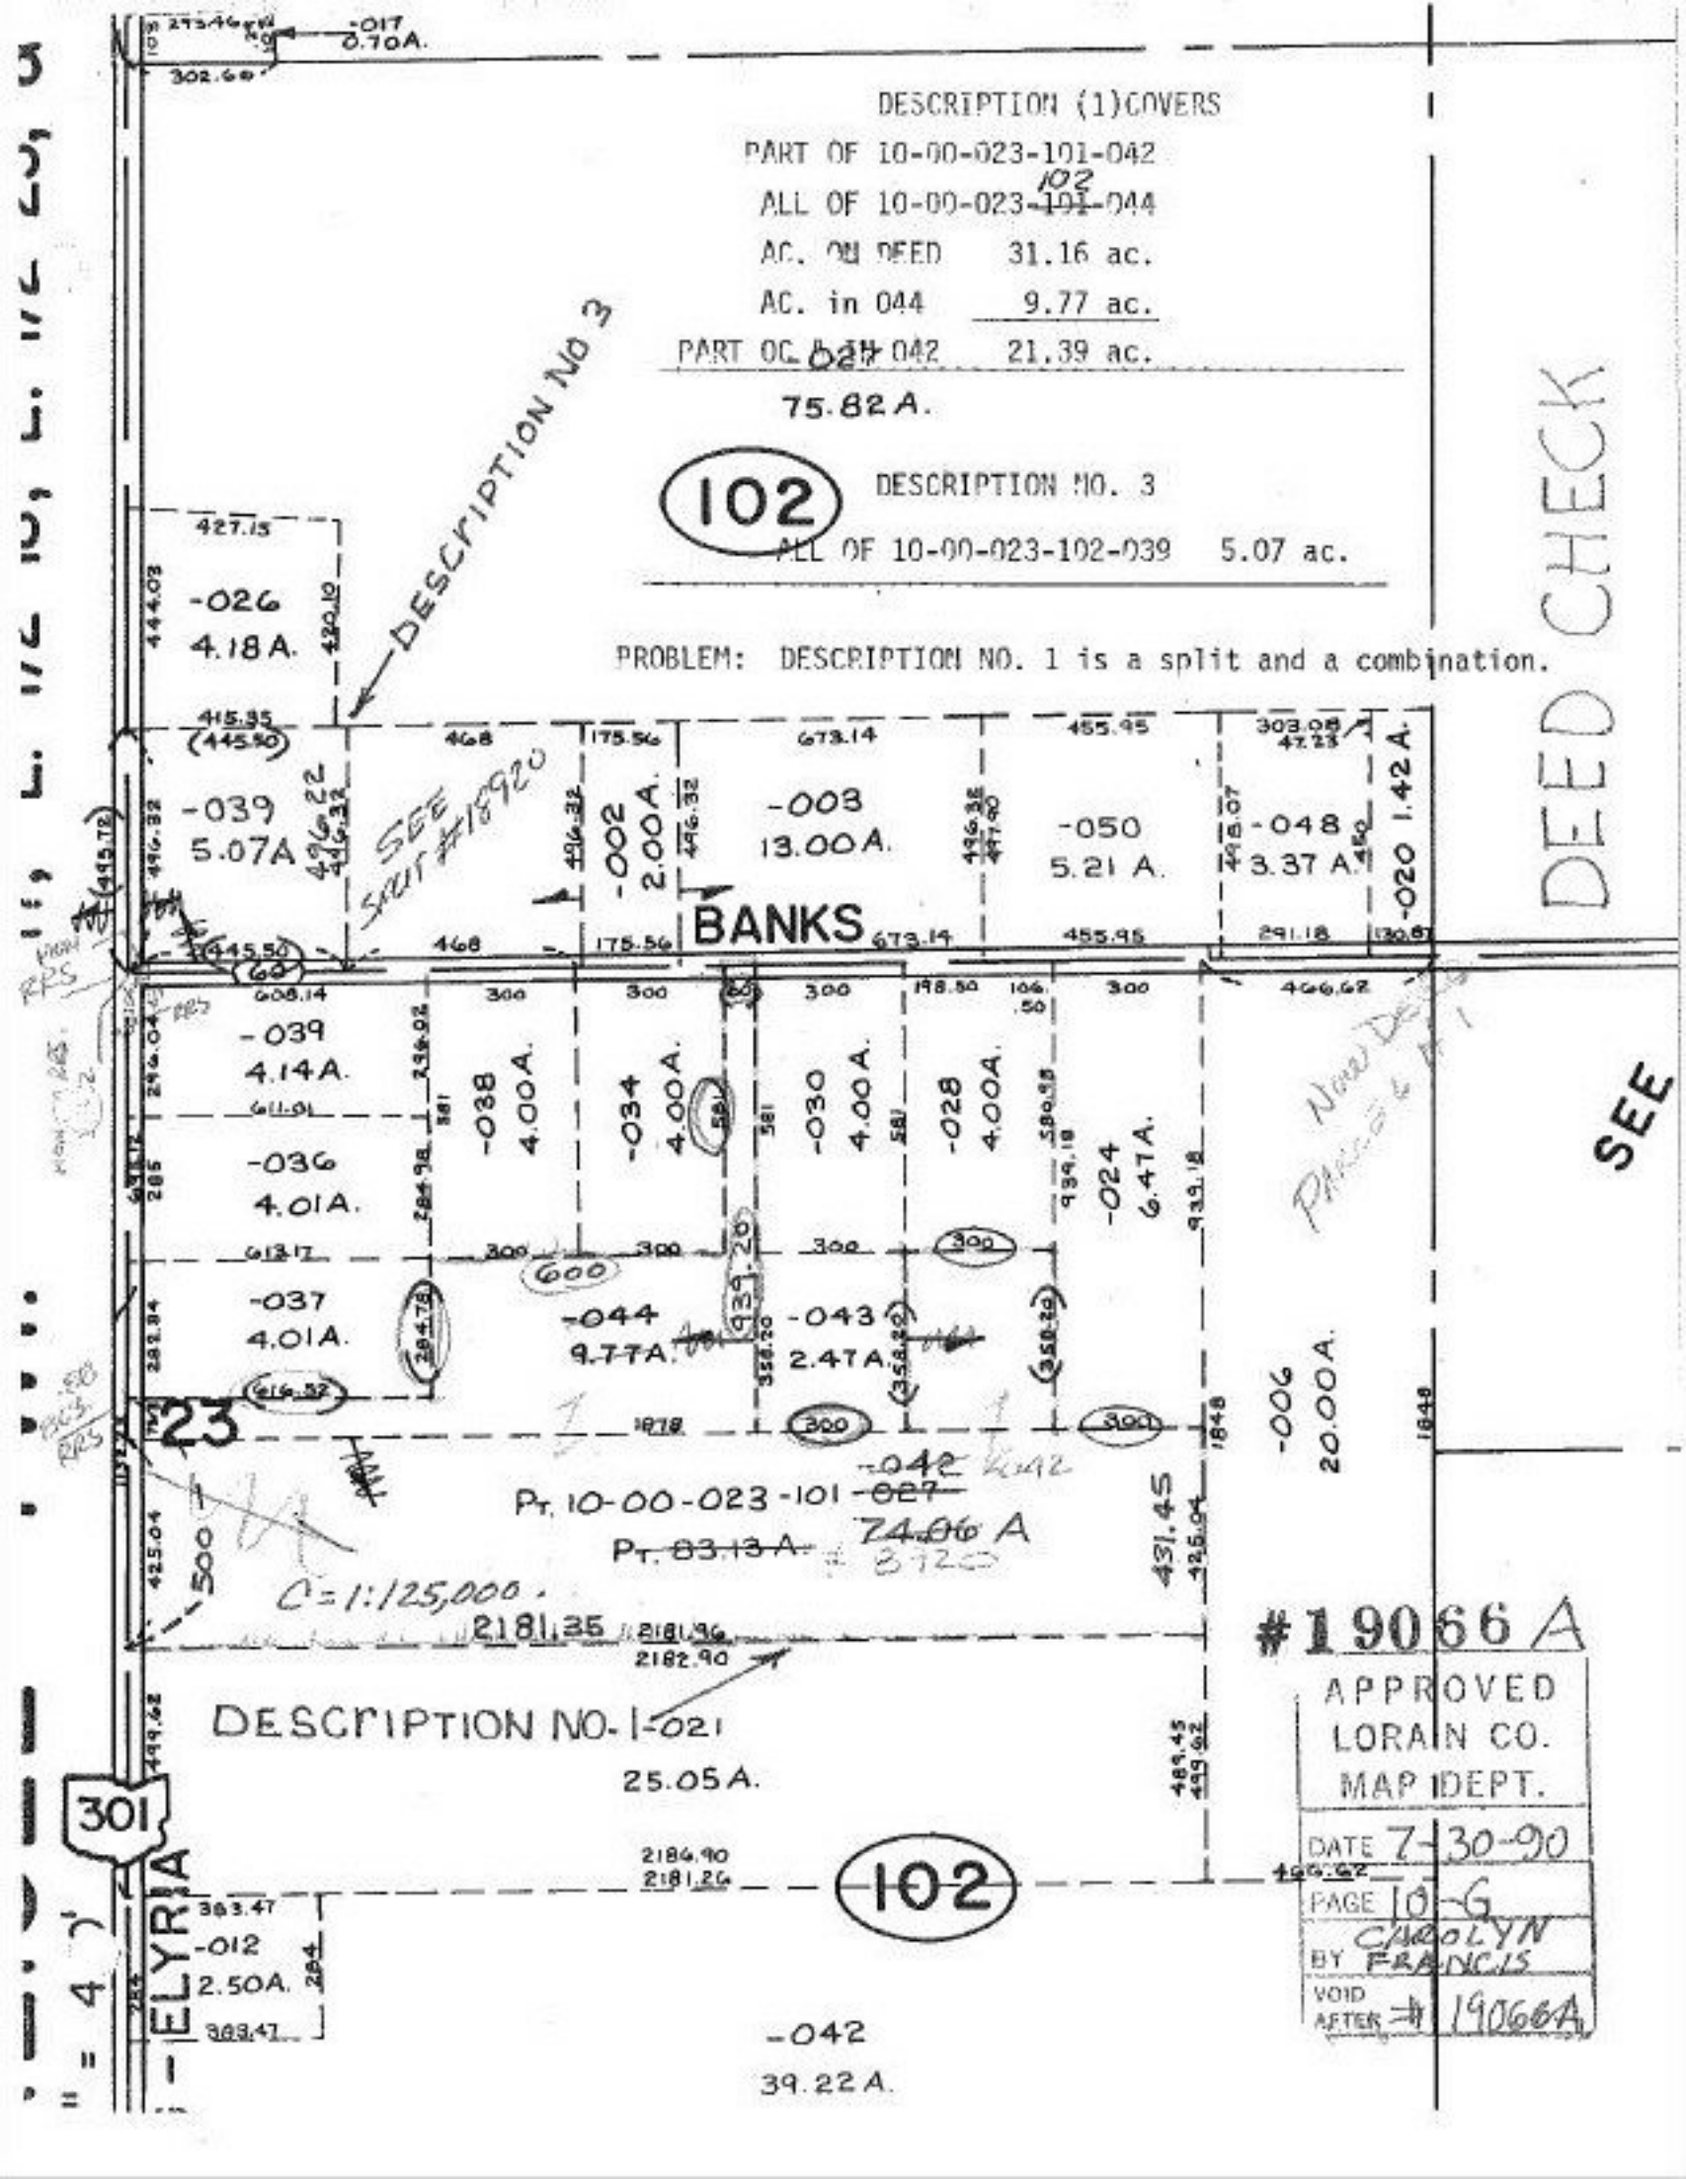
DESCRIPTION (1) COVERS
PART OF 10-00-023-101-042
ALL OF 10-00-023-102-044
AC. ON DEED 31.16 ac.
AC. in 044 9.77 ac.
PART OF 042 21.39 ac.
75.82 A.
102
DESCRIPTION NO. 3
ALL OF 10-00-023-102-039 5.07 ac.
PROBLEM: DESCRIPTION NO. 1 is a split and a combination.
DESCRIPTION NO 3
DEED CHECK
-026 4.18 A.
-039 5.07A
-002 2.00A.
-003 13.00A.
-050 5.21 A.
-048 3.37 A.
-020 1.42 A.
BANKS
-039 4.14A.
-038 4.00A.
-034 4.00A.
-030 4.00A.
-028 4.00A.
-024 6.47A.
-036 4.01A.
-037 4.01A.
-044 9.77A.
-043 2.47A
-042
-006 20.00A.
23
Pt. 10-00-023-101-027
Pt. 83.13A
74.06 A
C=1:125,000
DESCRIPTION NO. 1-021
25.05A.
-042
39.22 A.
ELYRIA
301
-012 2.50A.
SEE
#19066A
APPROVED
LORAIN CO.
MAP DEPT.
DATE 7-30-90
PAGE 10-6
BY CAROLYN FRANCIS
VOID AFTER #19066A