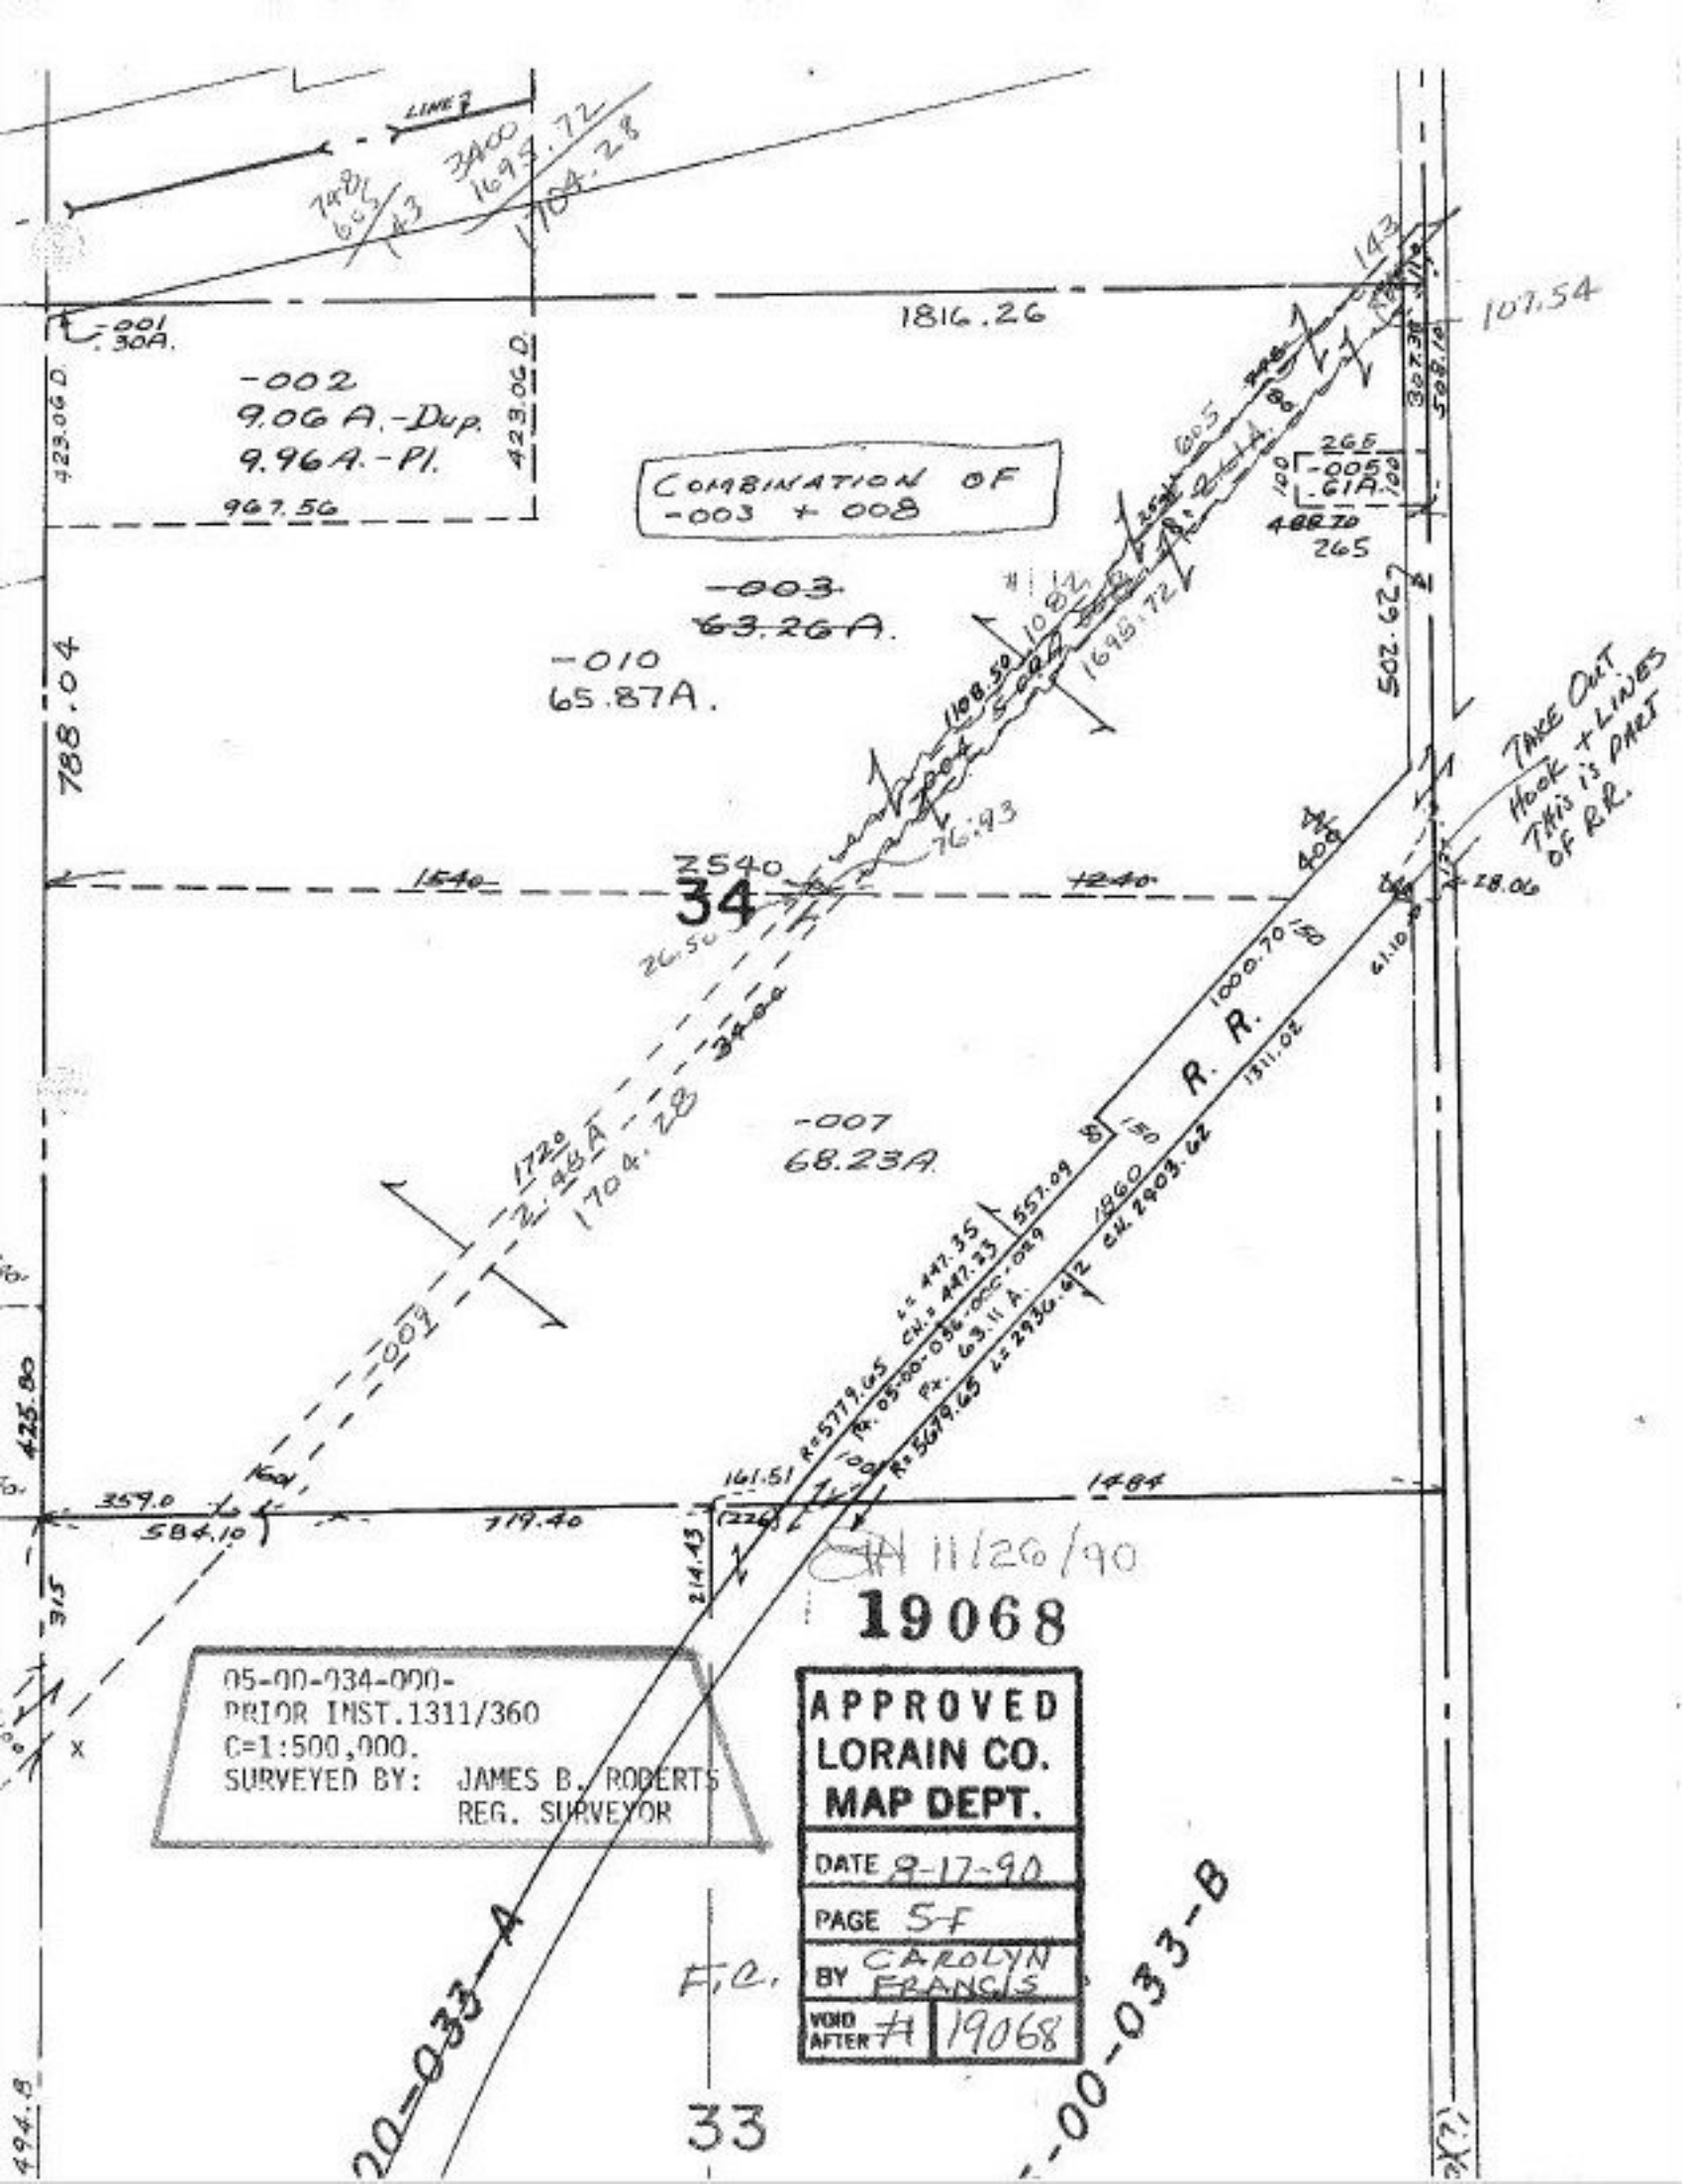

LINE 2
1816.26
107.54
-001
.30A.
-002
9.06 A.-Dup.
9.96 A.-Pl.
967.56
423.06 D.
COMBINATION OF
-003 + 008
-003
63.26 A.
-010
65.87A.
788.04
502.62
TAKE OUT
HOOK + LINES
THIS IS PART
OF R.R.
2540
34
1540
1240
-007
68.23A.
R. R.
1000.70
1311.02
1860
CH. 2903.62
557.09
1720
2.48A
1704.28
-009
359.0
584.10
719.40
161.51
1484
214.43
425.80
315
494.8
11/26/90
19068
05-00-034-000-
PRIOR INST.1311/360
C=1:500,000.
SURVEYED BY: JAMES B. ROBERTS
REG. SURVEYOR
APPROVED
LORAIN CO.
MAP DEPT.
DATE 8-17-90
PAGE 5-F
BY CAROLYN FRANCIS
VOID AFTER # 19068
F.C.
00-033-A
-00-033-B
33