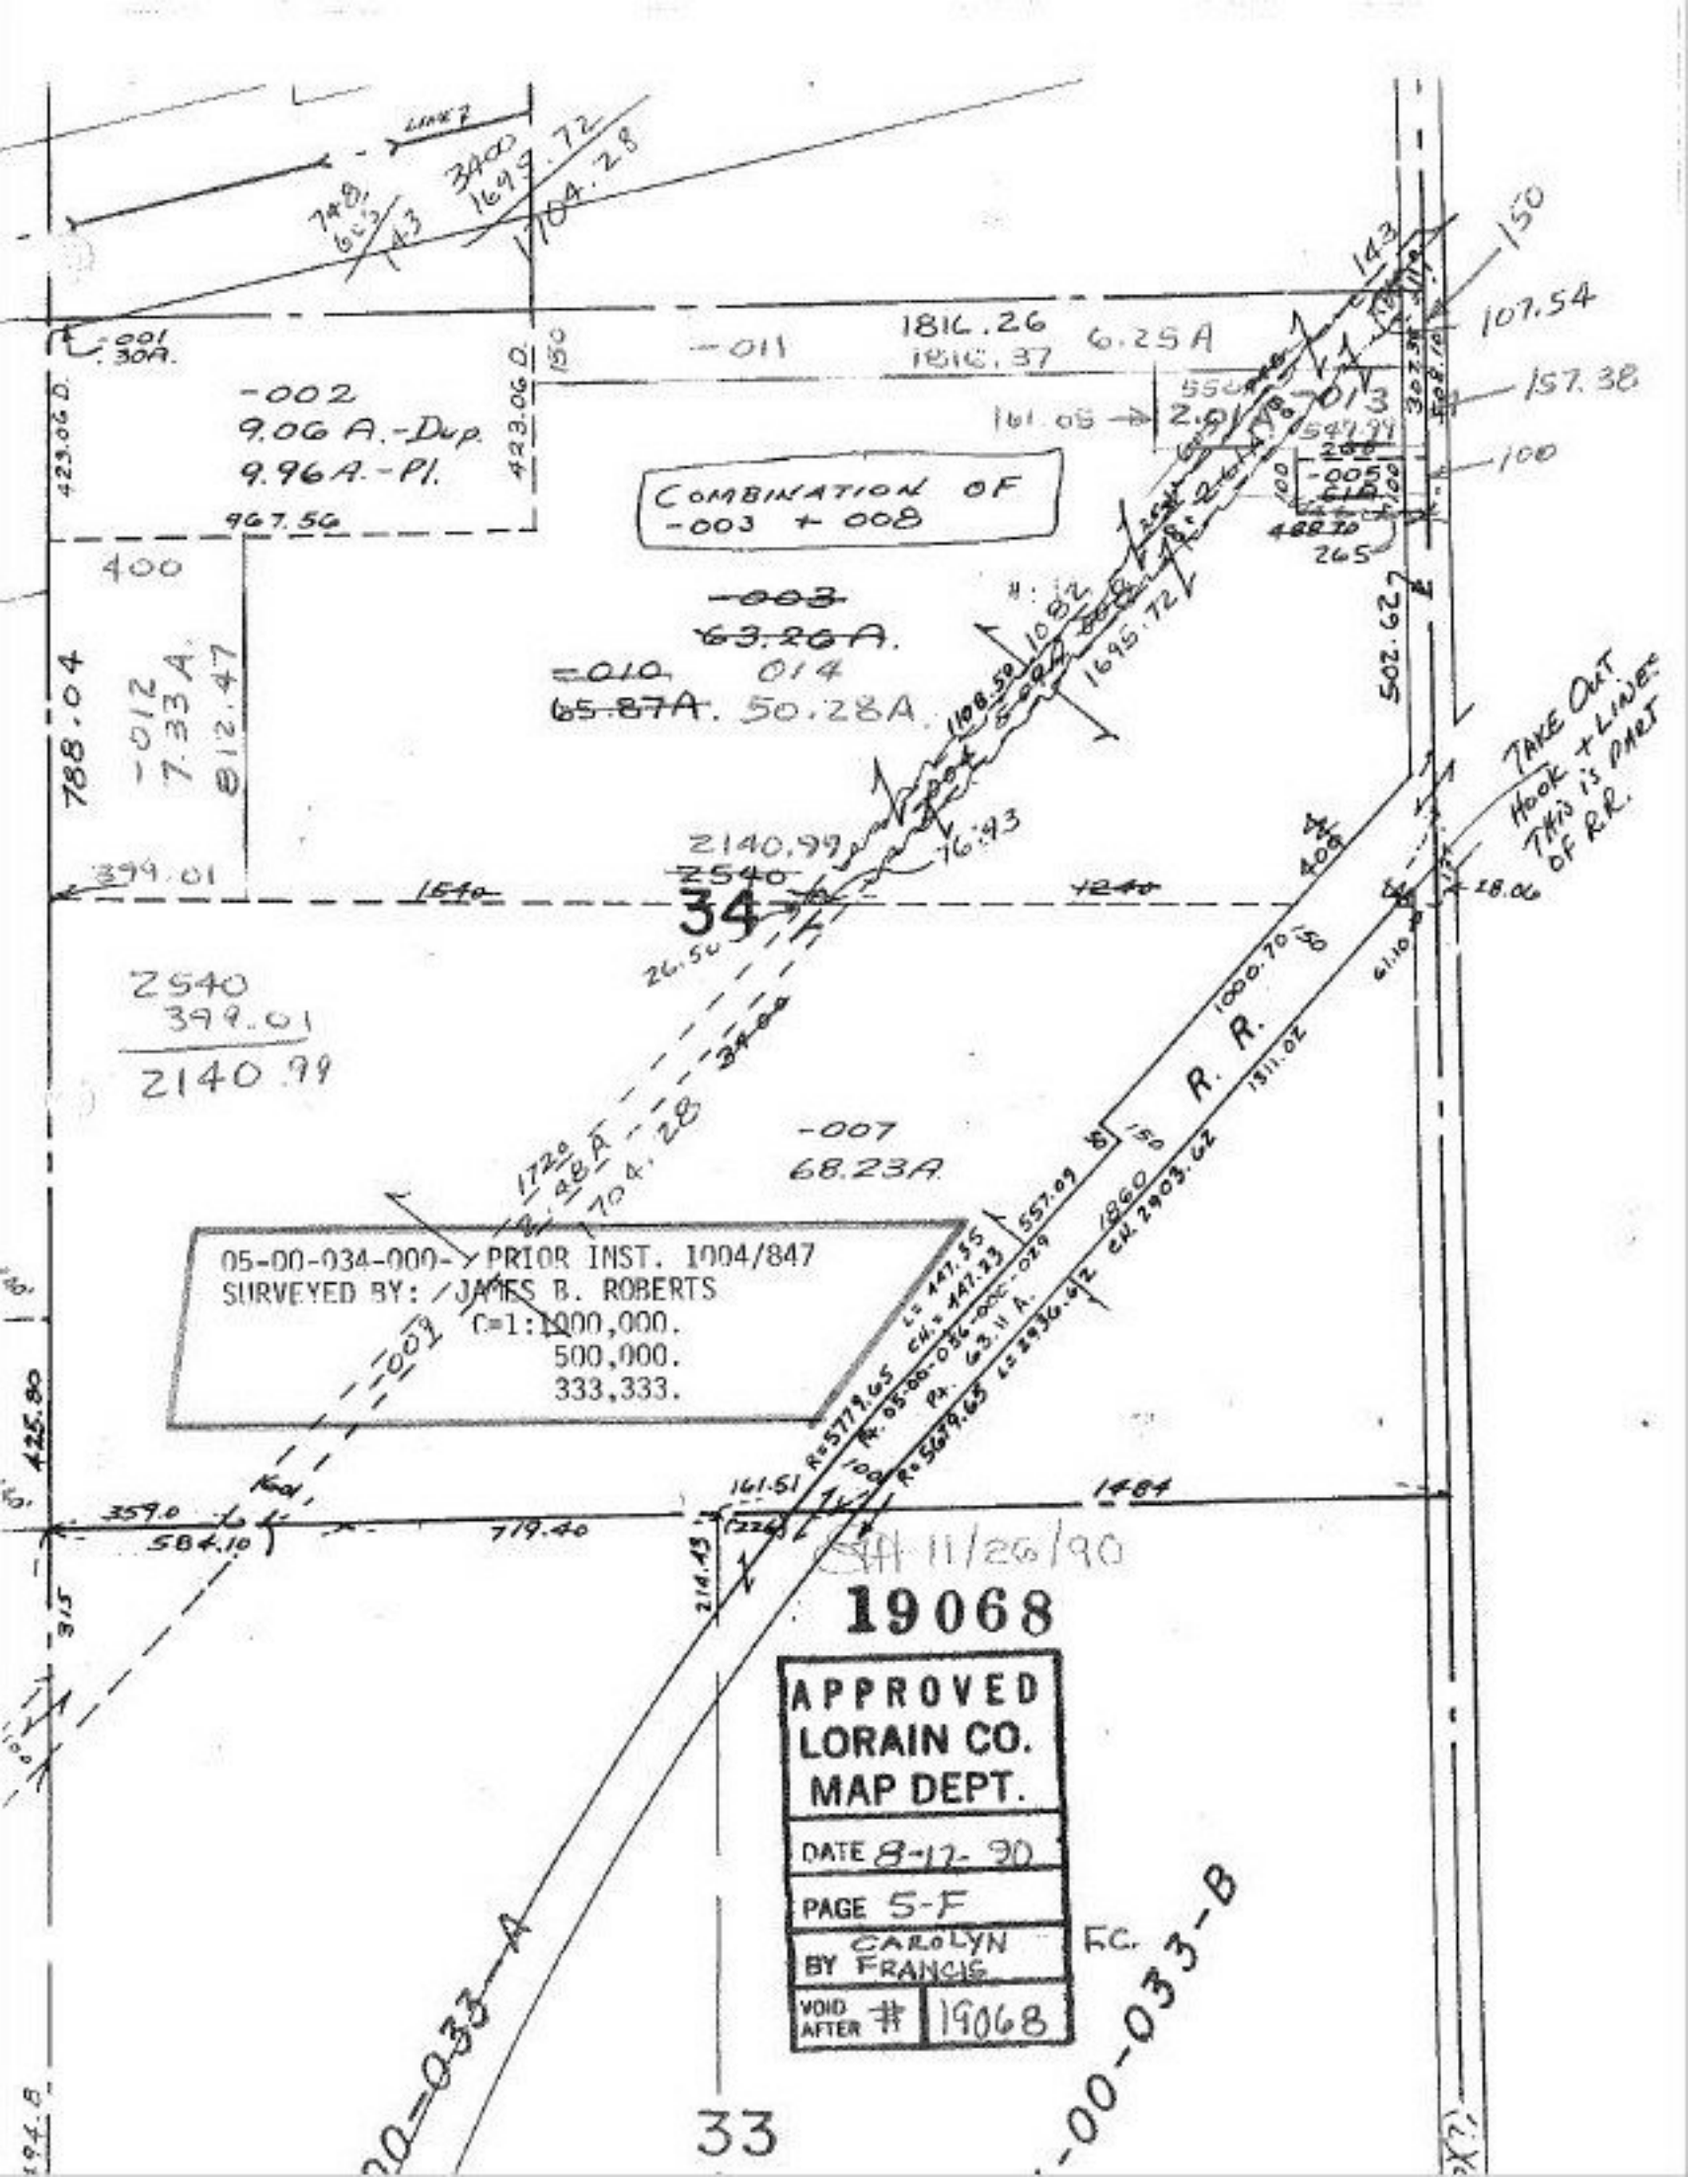

COMBINATION OF -003 + 008
-002
9.06 A.-Dup.
9.96 A.-Pl.
-011
1816.26
1816.37
6.25 A
-003
63.26 A.
-010
65.87 A.
014
50.28 A.
-012
7.33 A.
812.47
788.04
400
967.56
423.06 D.
399.01
2540
399.01
2140.99
2140.99
2540
34
-007
68.23 A.
R. R.
TAKE OUT HOOK + LINES THIS IS PART OF R.R.
05-00-034-000- PRIOR INST. 1004/847
SURVEYED BY: JAMES B. ROBERTS
C=1:1000,000.
500,000.
333,333.
11/26/90
19068
APPROVED
LORAIN CO.
MAP DEPT.
DATE 8-12-90
PAGE 5-F
BY CAROLYN FRANCIS F.C.
VOID AFTER # 19068
33