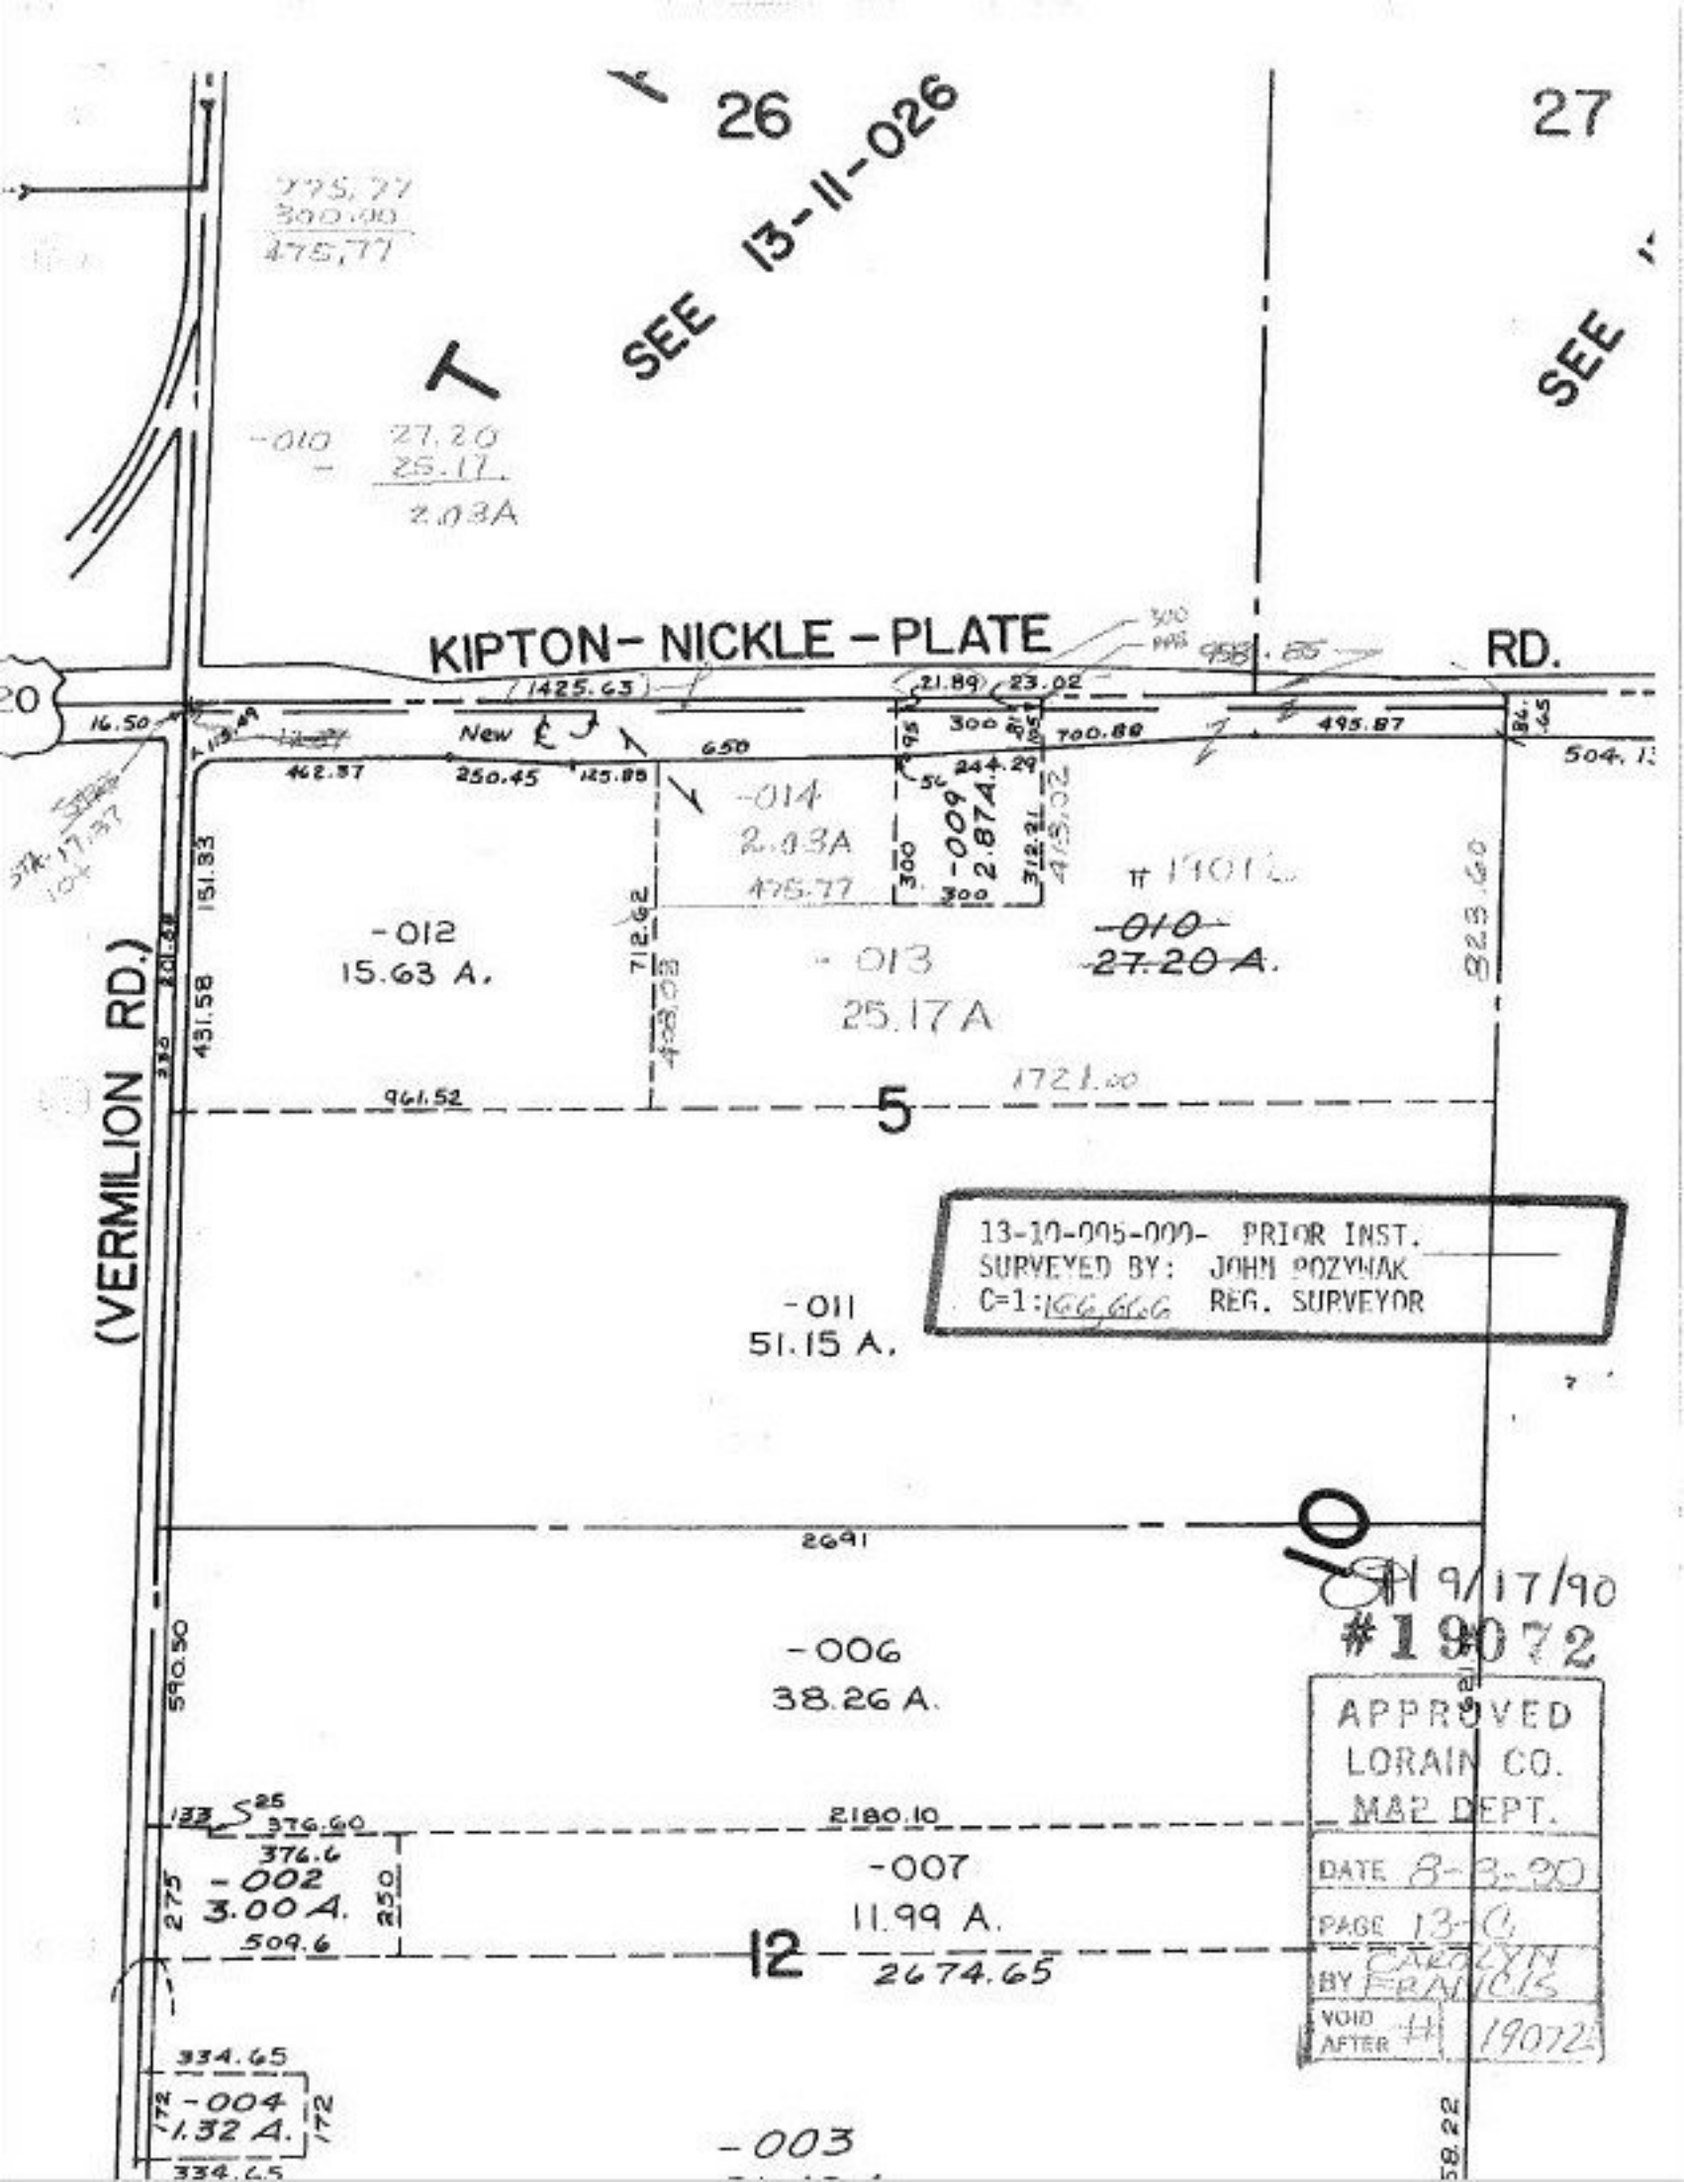
26
27
SEE 13-11-026
SEE
T
275.77
300.00
475.77
-010 27.20
25.17
2.03A
KIPTON-NICKLE-PLATE RD.
(1425.63)
21.89
23.02
958.85
300 PVC
16.50
New
650
462.87
250.45
125.80
700.80
495.87
504.1
-014
2.03A
475.77
-009
2.874
312.31
415.02
244.29
300
#19072
-010
27.20 A.
-012
15.63 A.
-013
25.17A
712.62
151.33
431.58
961.52
1721.00
823.60
5
(VERMILION RD.)
13-10-005-000- PRIOR INST.
SURVEYED BY: JOHN POZYNAK
C=1:166,666 REG. SURVEYOR
-011
51.15 A.
2691
10
9/17/90
#19072
APPROVED
LORAIN CO.
MAP DEPT.
DATE 8-3-20
PAGE 13-C
BY CAROLYN FRANCIS
VOID AFTER 19072
590.50
-006
38.26 A.
2180.10
376.60
-002
3.00 A.
509.6
275
250
-007
11.99 A.
2674.65
12
334.65
-004
1.32 A.
334.65
-003
58.22