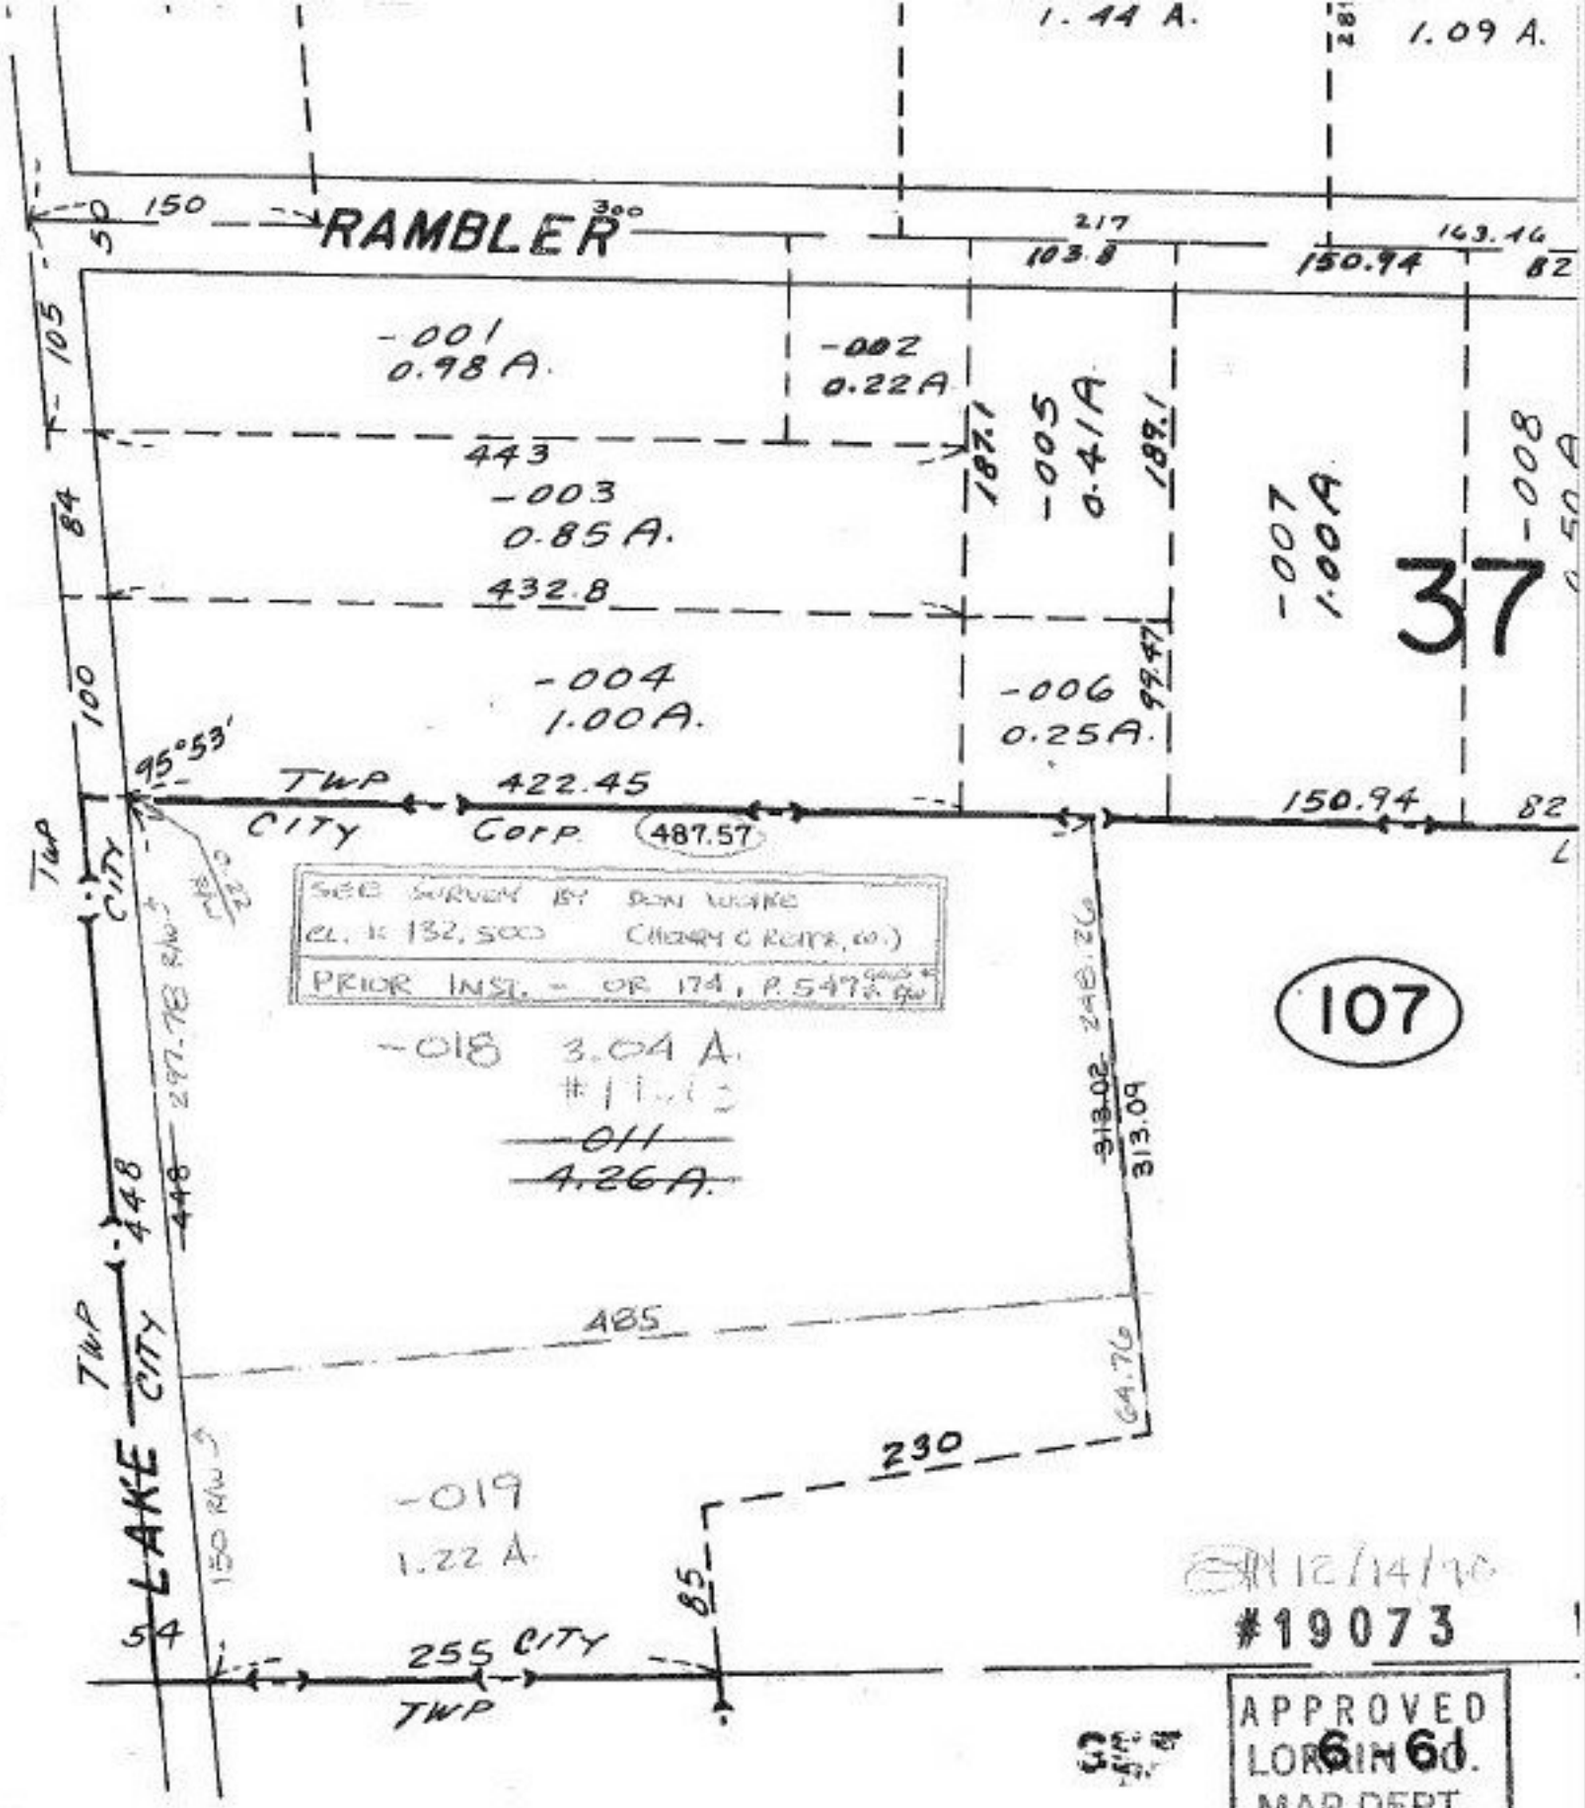

12/14/90

#19073

APPROVED
LORAIN CO.
MAP DEPT.
DATE 7-31-90
PAGE 6-43
BY T. McNair
VOID AFTER 19073

6 61

SE·LY PT. LOT 11

R NE·LY PT. LOT 37 E·LY PT. LOT 38