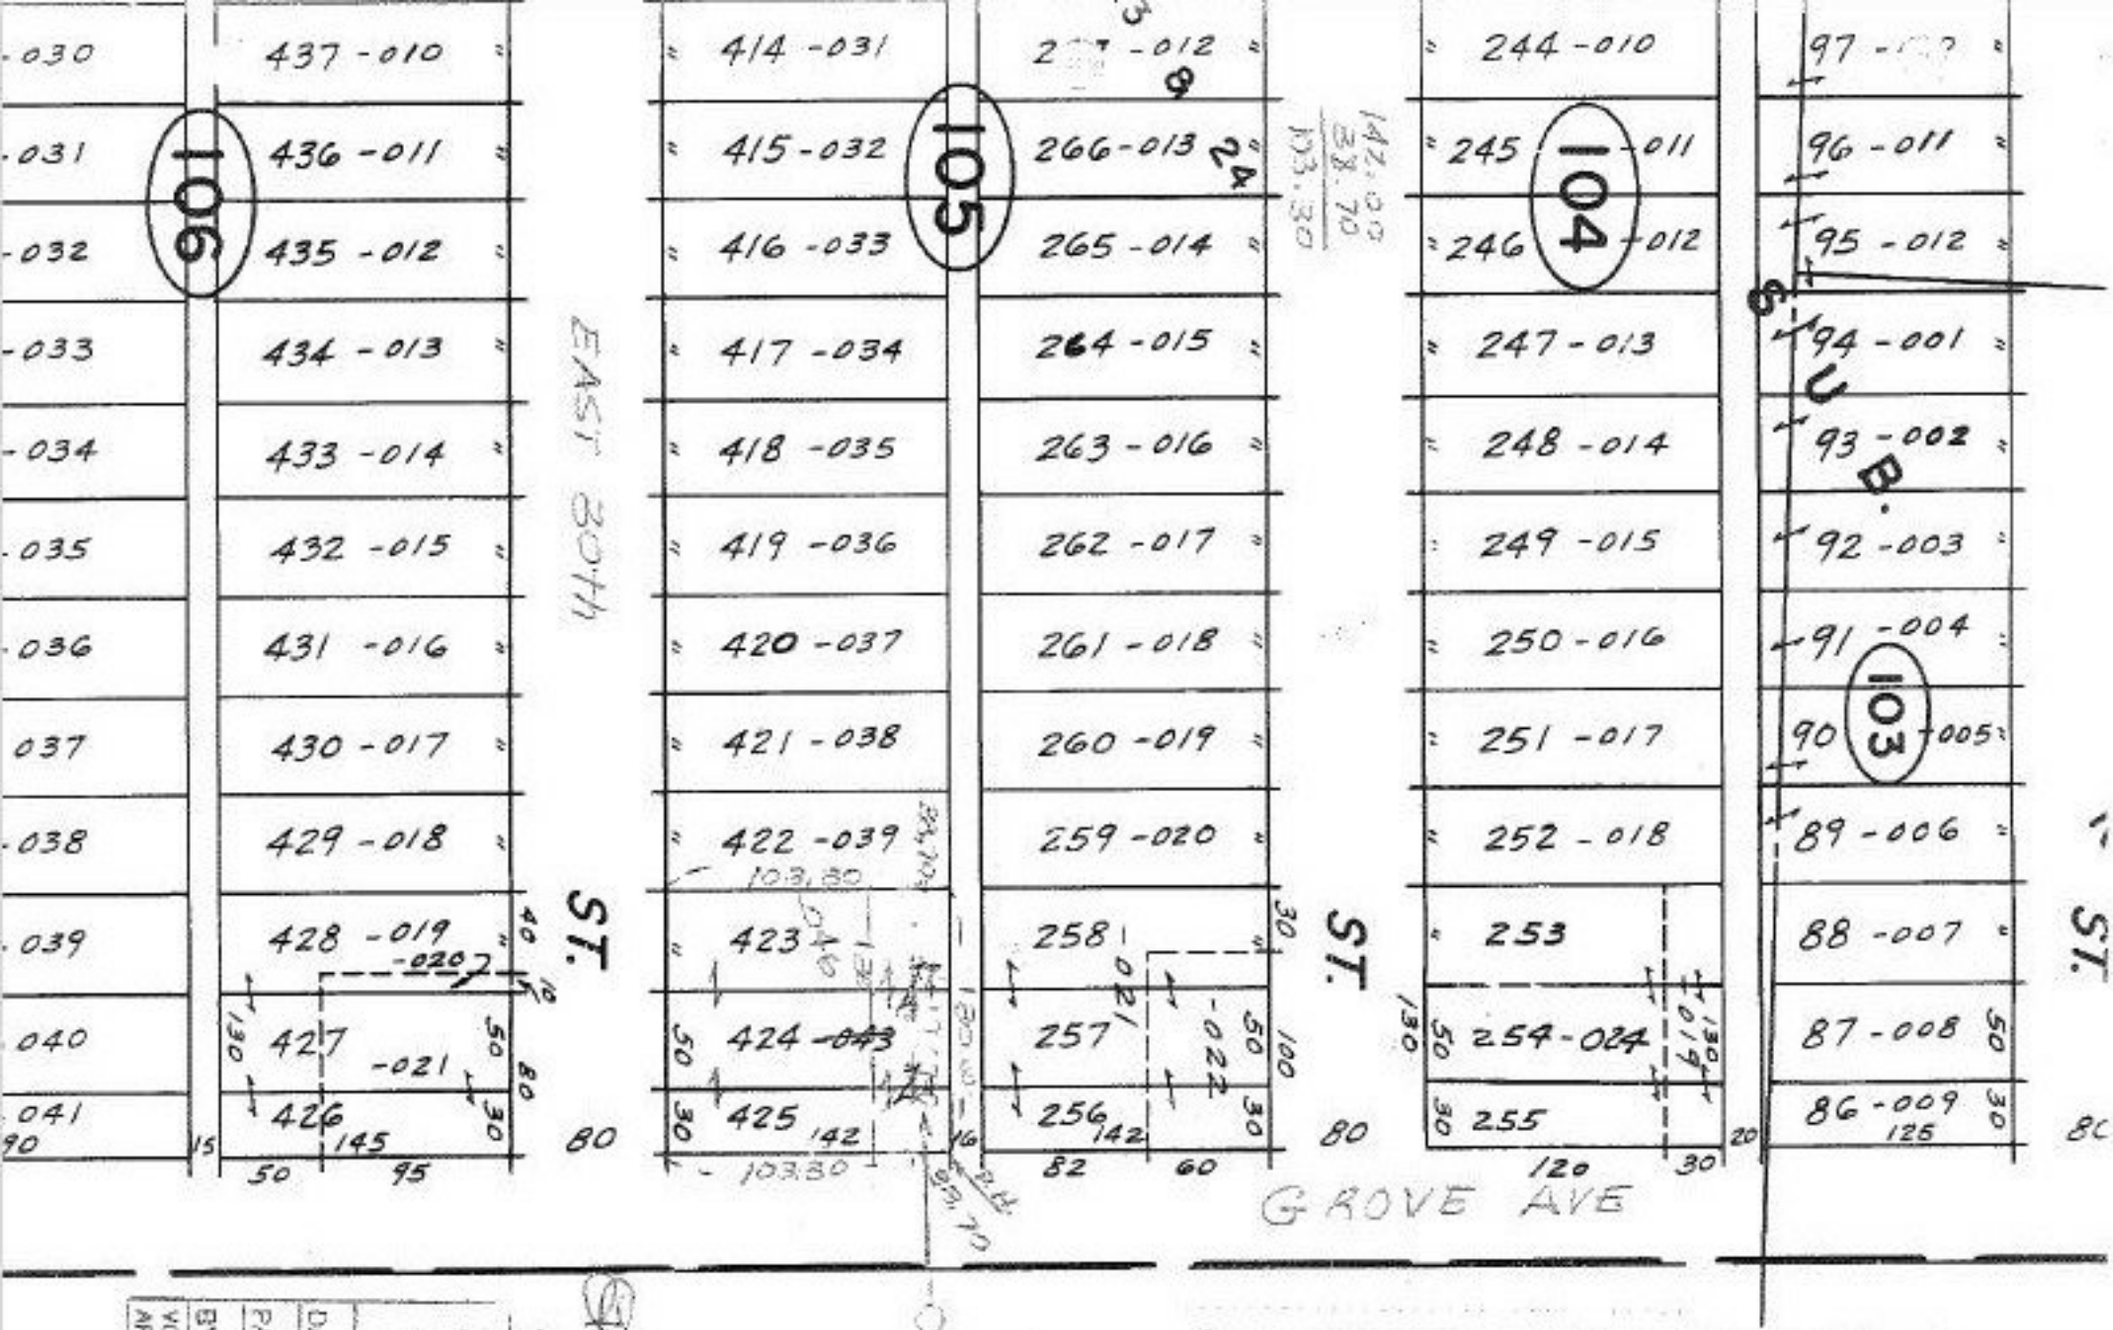

APPROVED
LORAIN CO.
MAP DEPT.
DATE 8-6-90
PAGE 300 OMA
BY CAROLYN FRANCIS
VOID AFTER #19076

#19076
11/11/91

03-00-094-105-045 PRIOR INST. 1038/100
SURVEYED BY: JAMES B. ROBERTS McCARTNEY
C=1: REG. SURVEYOR & ASSOC.