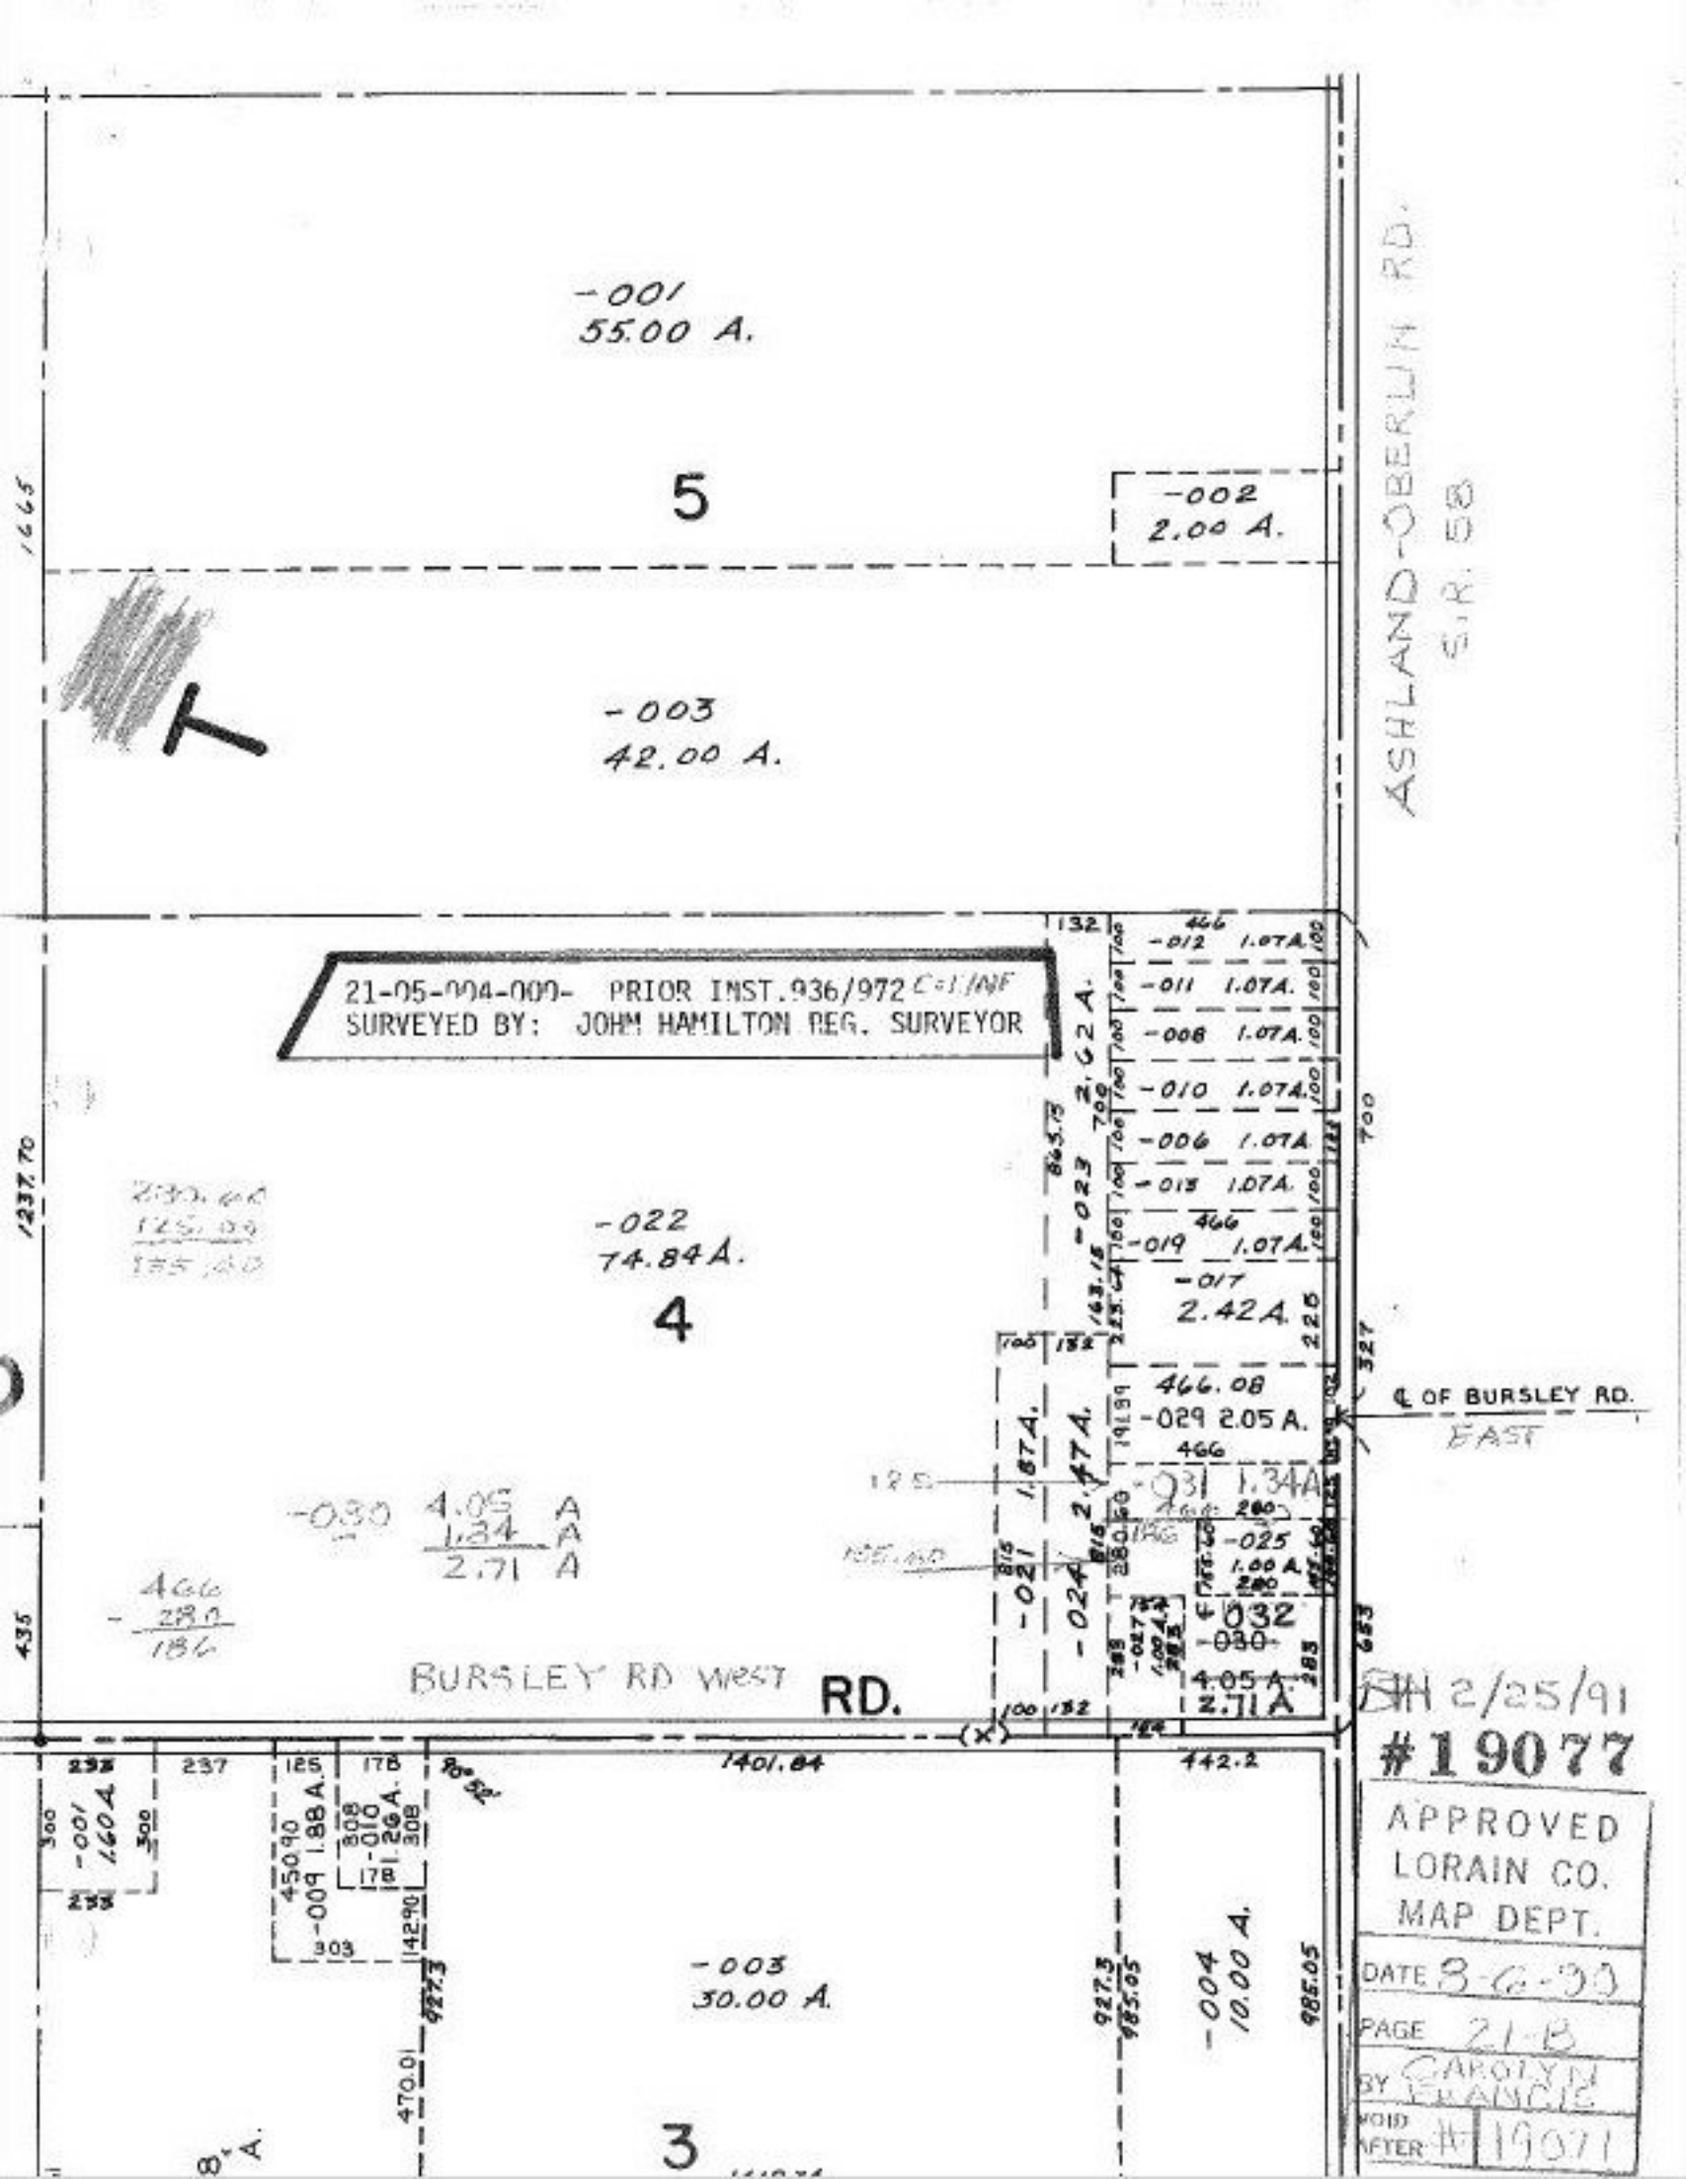

SH 2/25/91

#19077

APPROVED
LORAIN CO.
MAP DEPT.

DATE 8-6-91

PAGE 21-B

BY CAROLYN FRANCIS

VOID AFTER # 19071