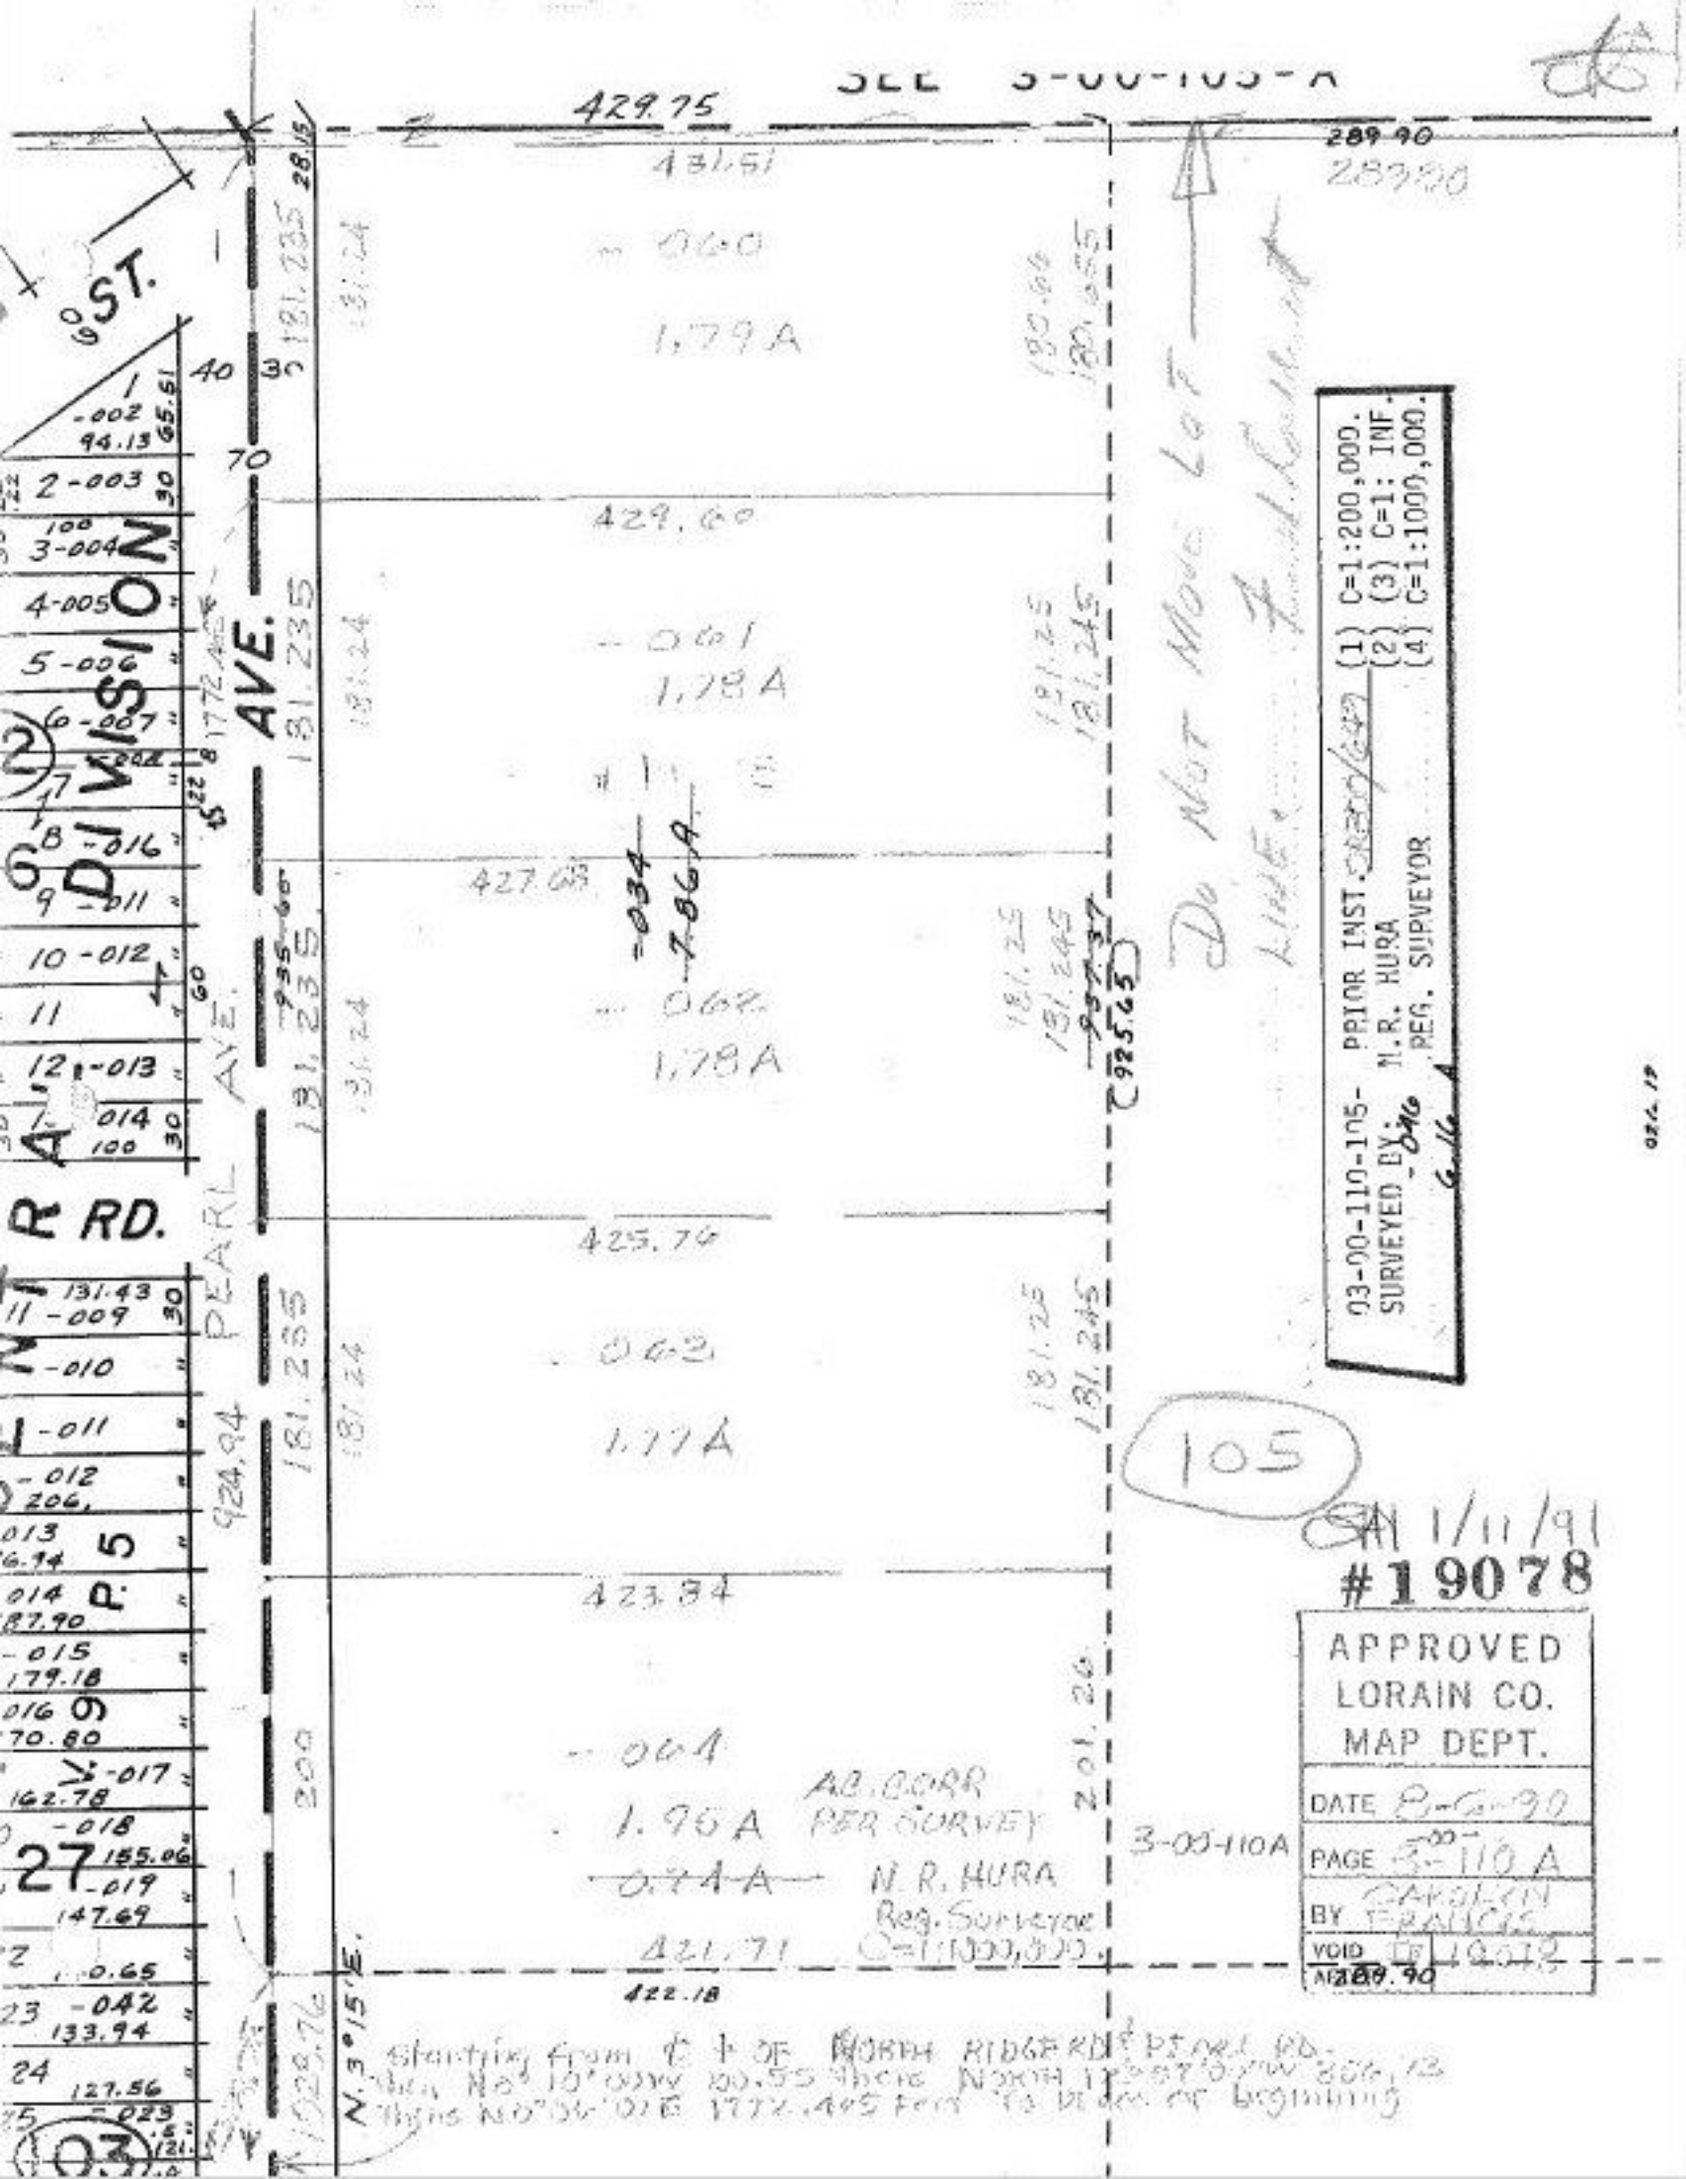
SEE 3-00-105-A
429.75
289.90
131.51
1.79A
429.60
1.78A
427.63
1.78A
425.74
1.77A
423.84
1.96A
AD. CORR PER SURVEY
0.74A
N. R. HURA Reg. Surveyor C-1(1000,000.
421.71
422.18
N 3°15'E
924.94
181.24
181.235
181.245
200
201.20
60 ST.
WISSION AVE.
PEARL AVE.
R RD.
03-00-110-105- PRIOR INST.
SURVEYED BY N.R. HURA REG. SURVEYOR
(1) C=1:200,000. (2) (3) C=1: INF. (4) C=1:1000,000.
Do Not Move Lot Line
105
1/11/91
#19078
APPROVED LORAIN CO. MAP DEPT.
DATE 8-6-90
PAGE 3-00-110 A
BY CAROLYN FRANCIS
VOID DEC 19 2012
3-00-110A
starting from ℄ of NORTH RIDGE RD & PEARL RD. run N 8° 10' 00" W 20.55 thence N 78° 50' 00" W 201.13 thence N 0° 26' 00" E 1772.405 feet to place of beginning