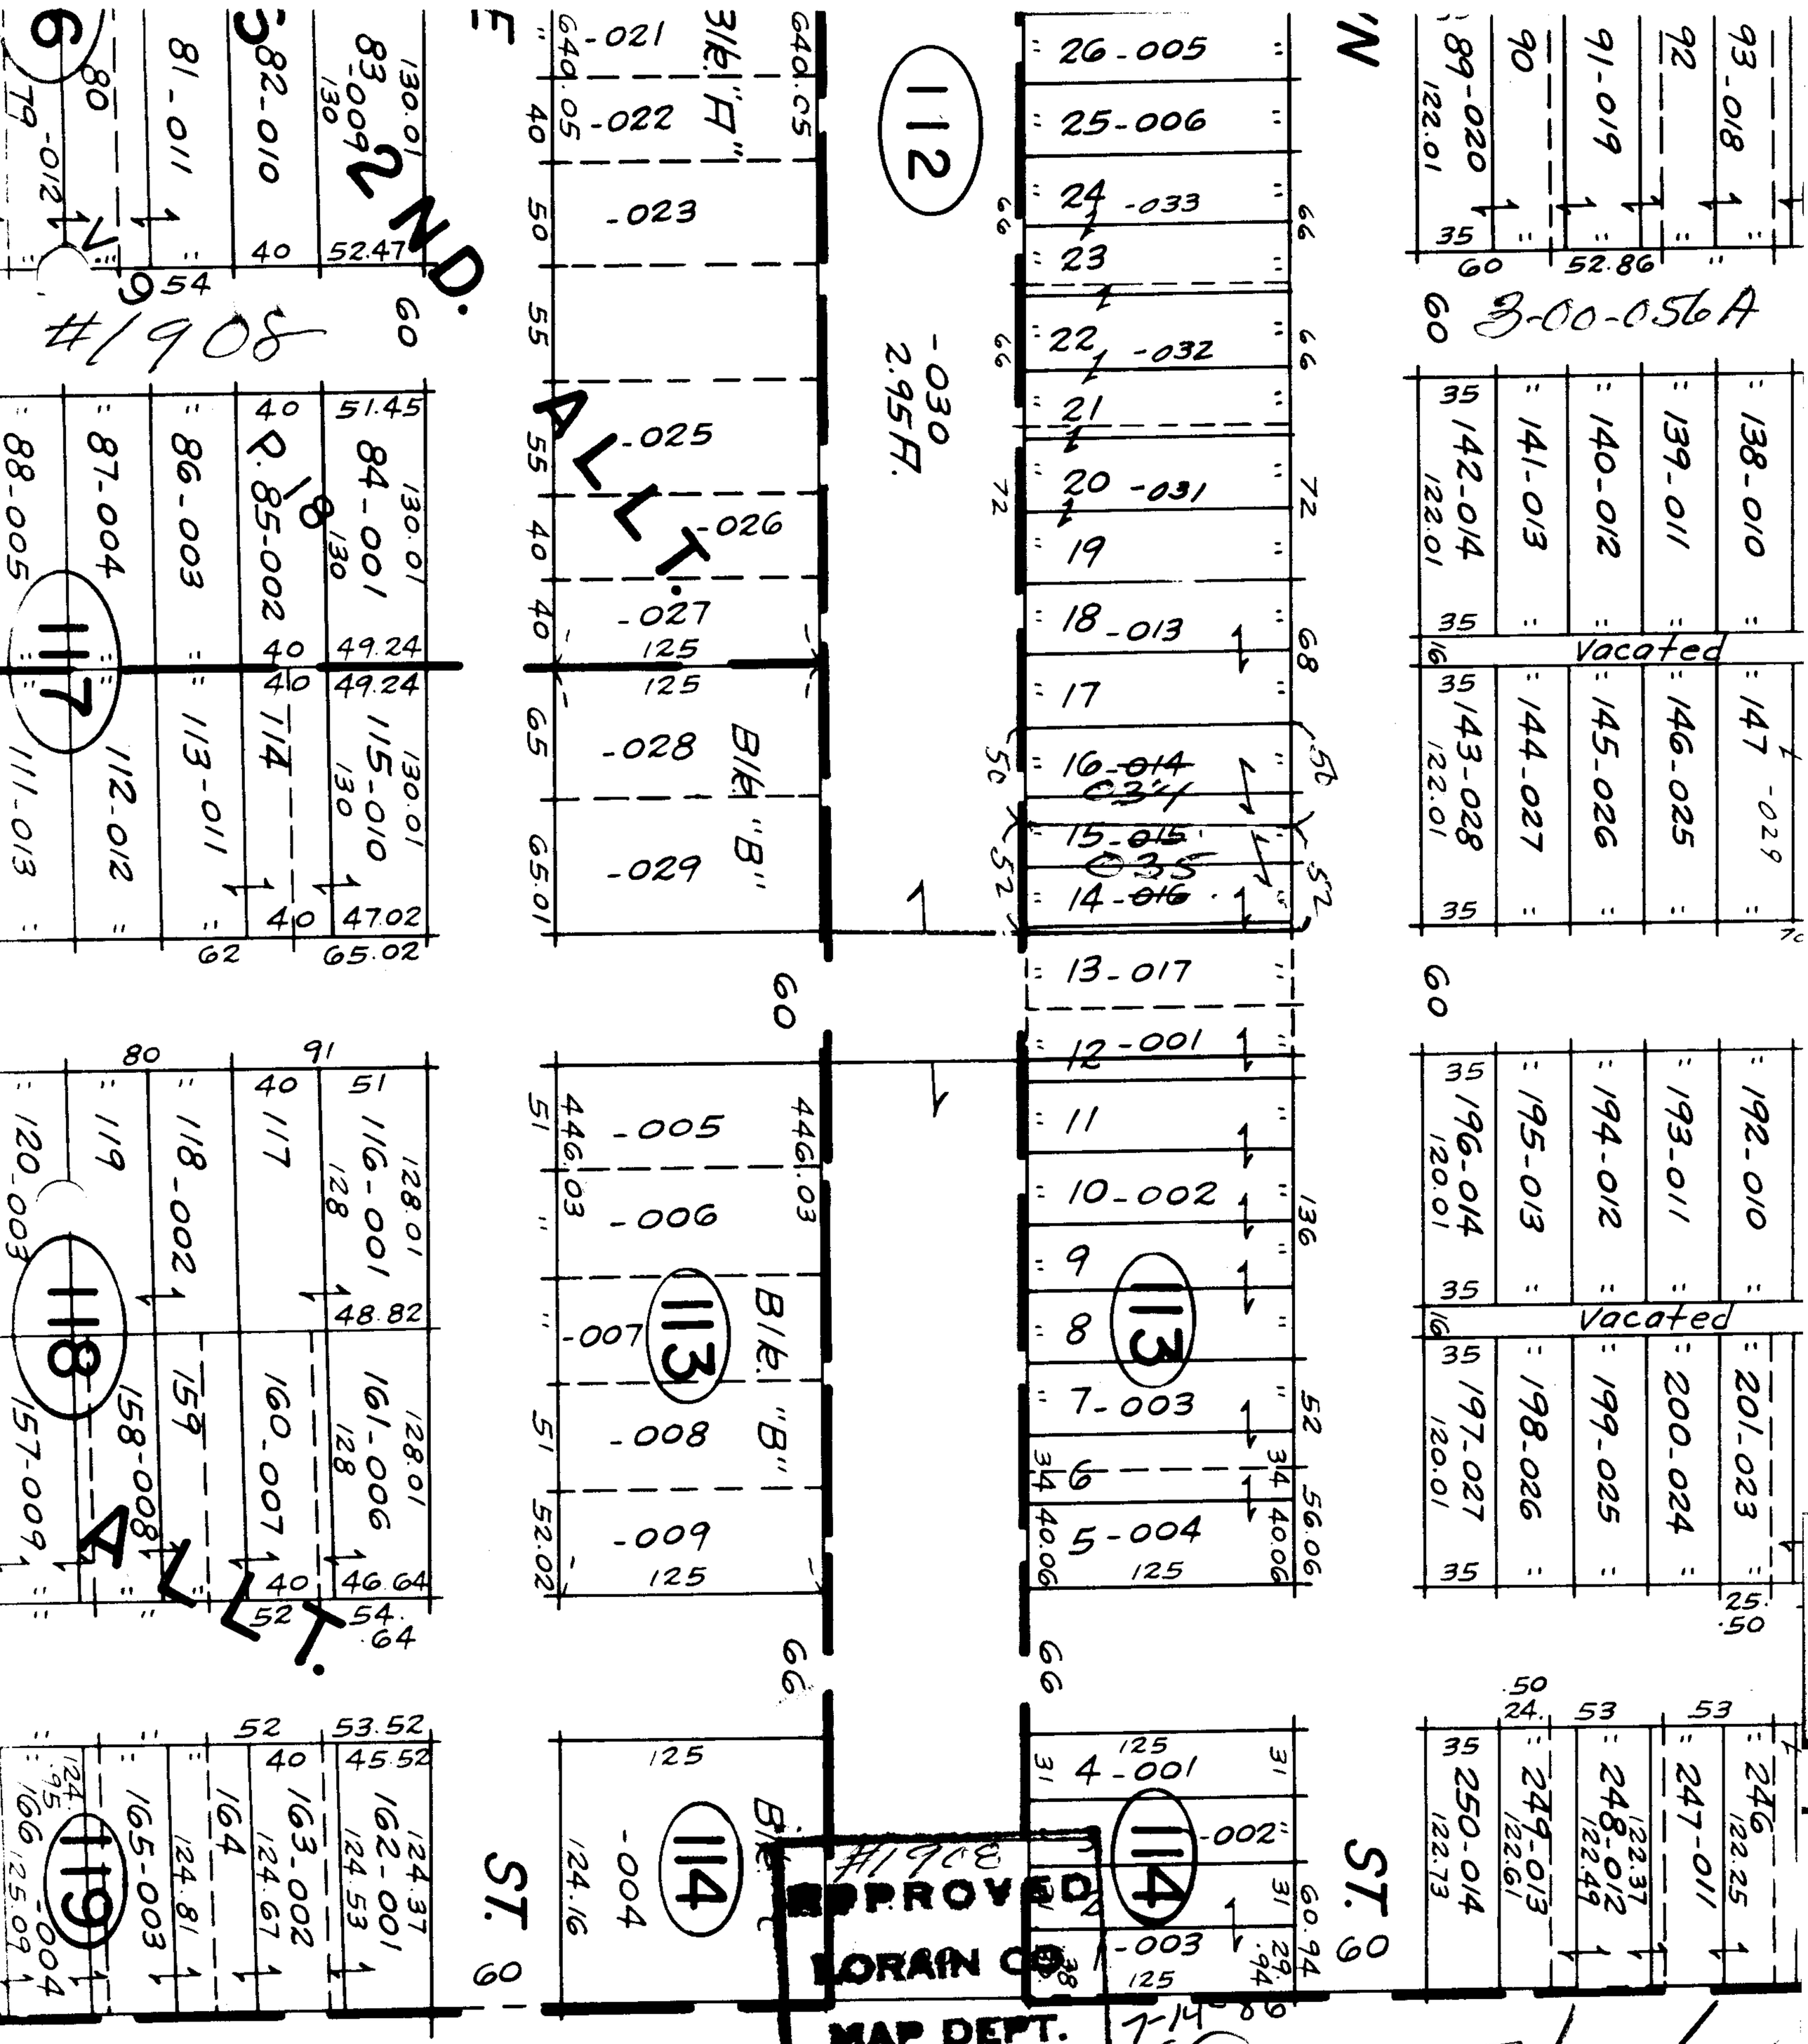

APPROVED
LORAIN CO.
MAP DEPT.
DATE 6/28/68
03-00-056 A
BY LW Hall

7-14-86
SS

Done 7/23/68

Tax Map Pg 3-00-056A