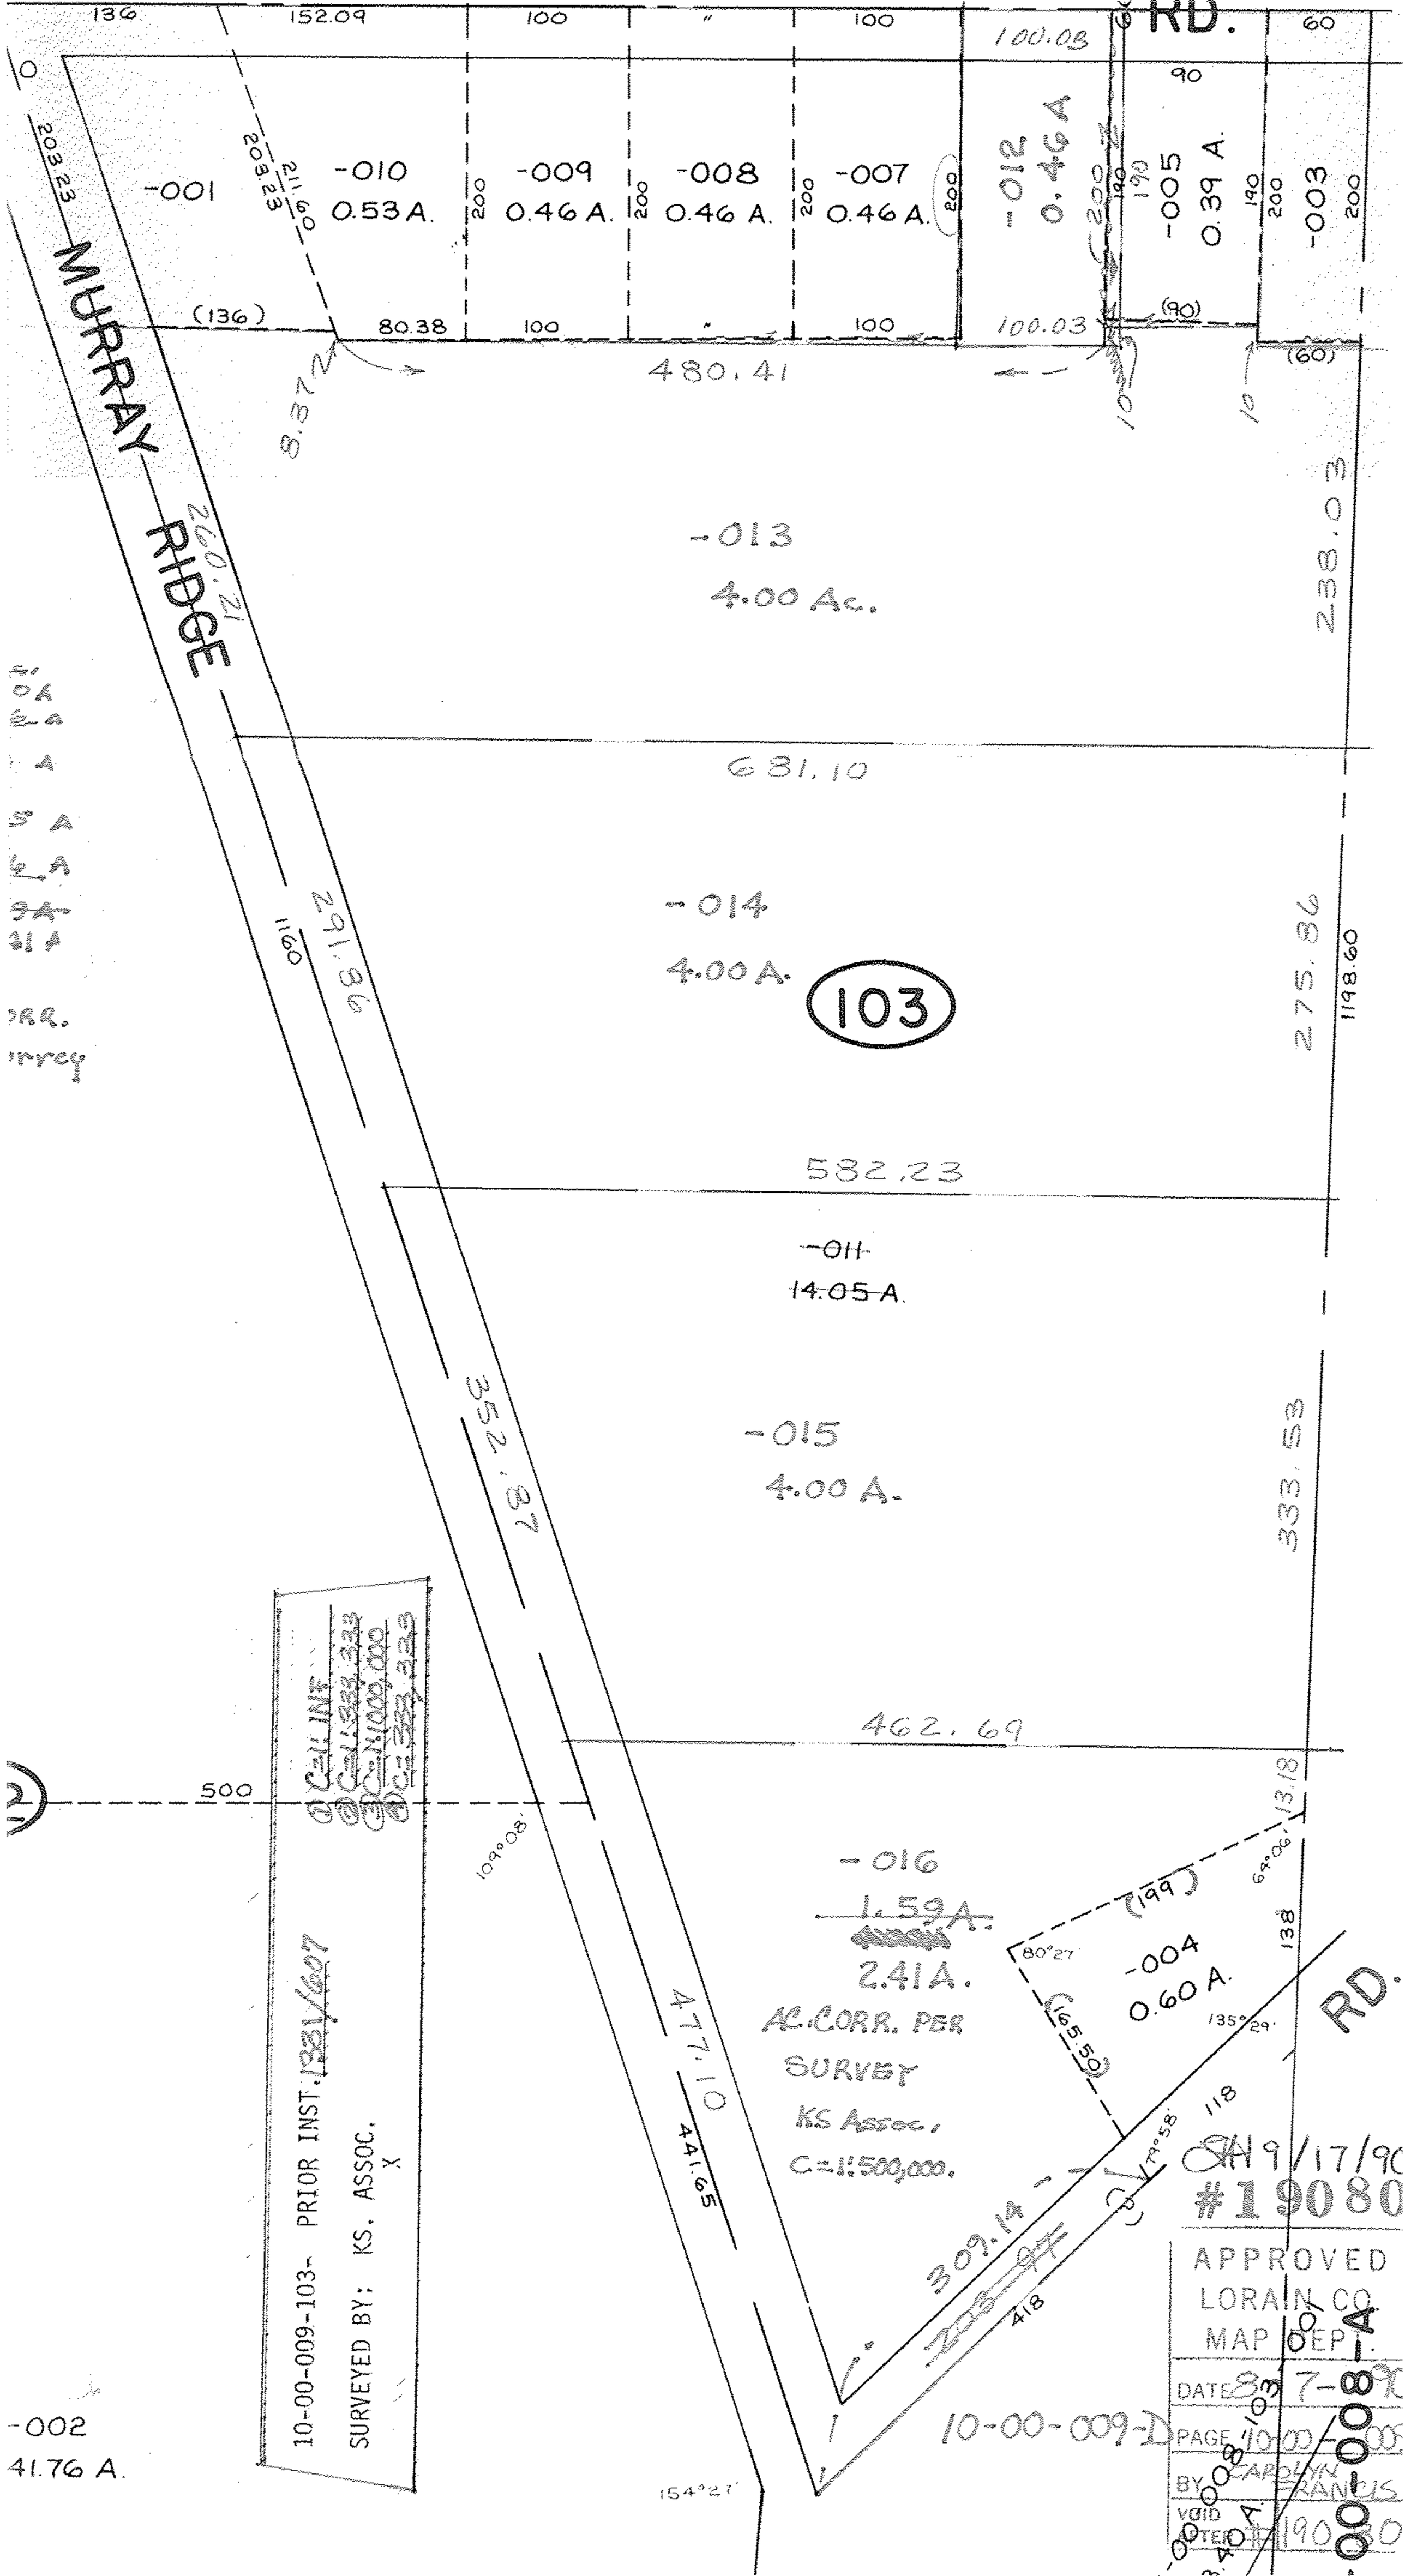
MURRAY RIDGE
RD.
-001
-010 0.53 A.
-009 0.46 A.
-008 0.46 A.
-007 0.46 A.
-012 0.46 A.
-005 0.39 A.
-003
-013 4.00 Ac.
-014 4.00 A.
103
-011 14.05 A.
-015 4.00 A.
-016 1.59 A.
2.41 A.
AC. CORR. PER SURVEY KS Assoc, C=1:500,000.
-004 0.60 A.
-002 41.76 A.
10-00-009-103- PRIOR INST. 1231/1607
SURVEYED BY: KS. ASSOC.
10-00-009-D
9/17/90
#19080
APPROVED
LORAIN CO
MAP DEPT.
DATE 8-7-90
BY CAROLYN FRANCIS
VOID
ENTER
10-00-008-A