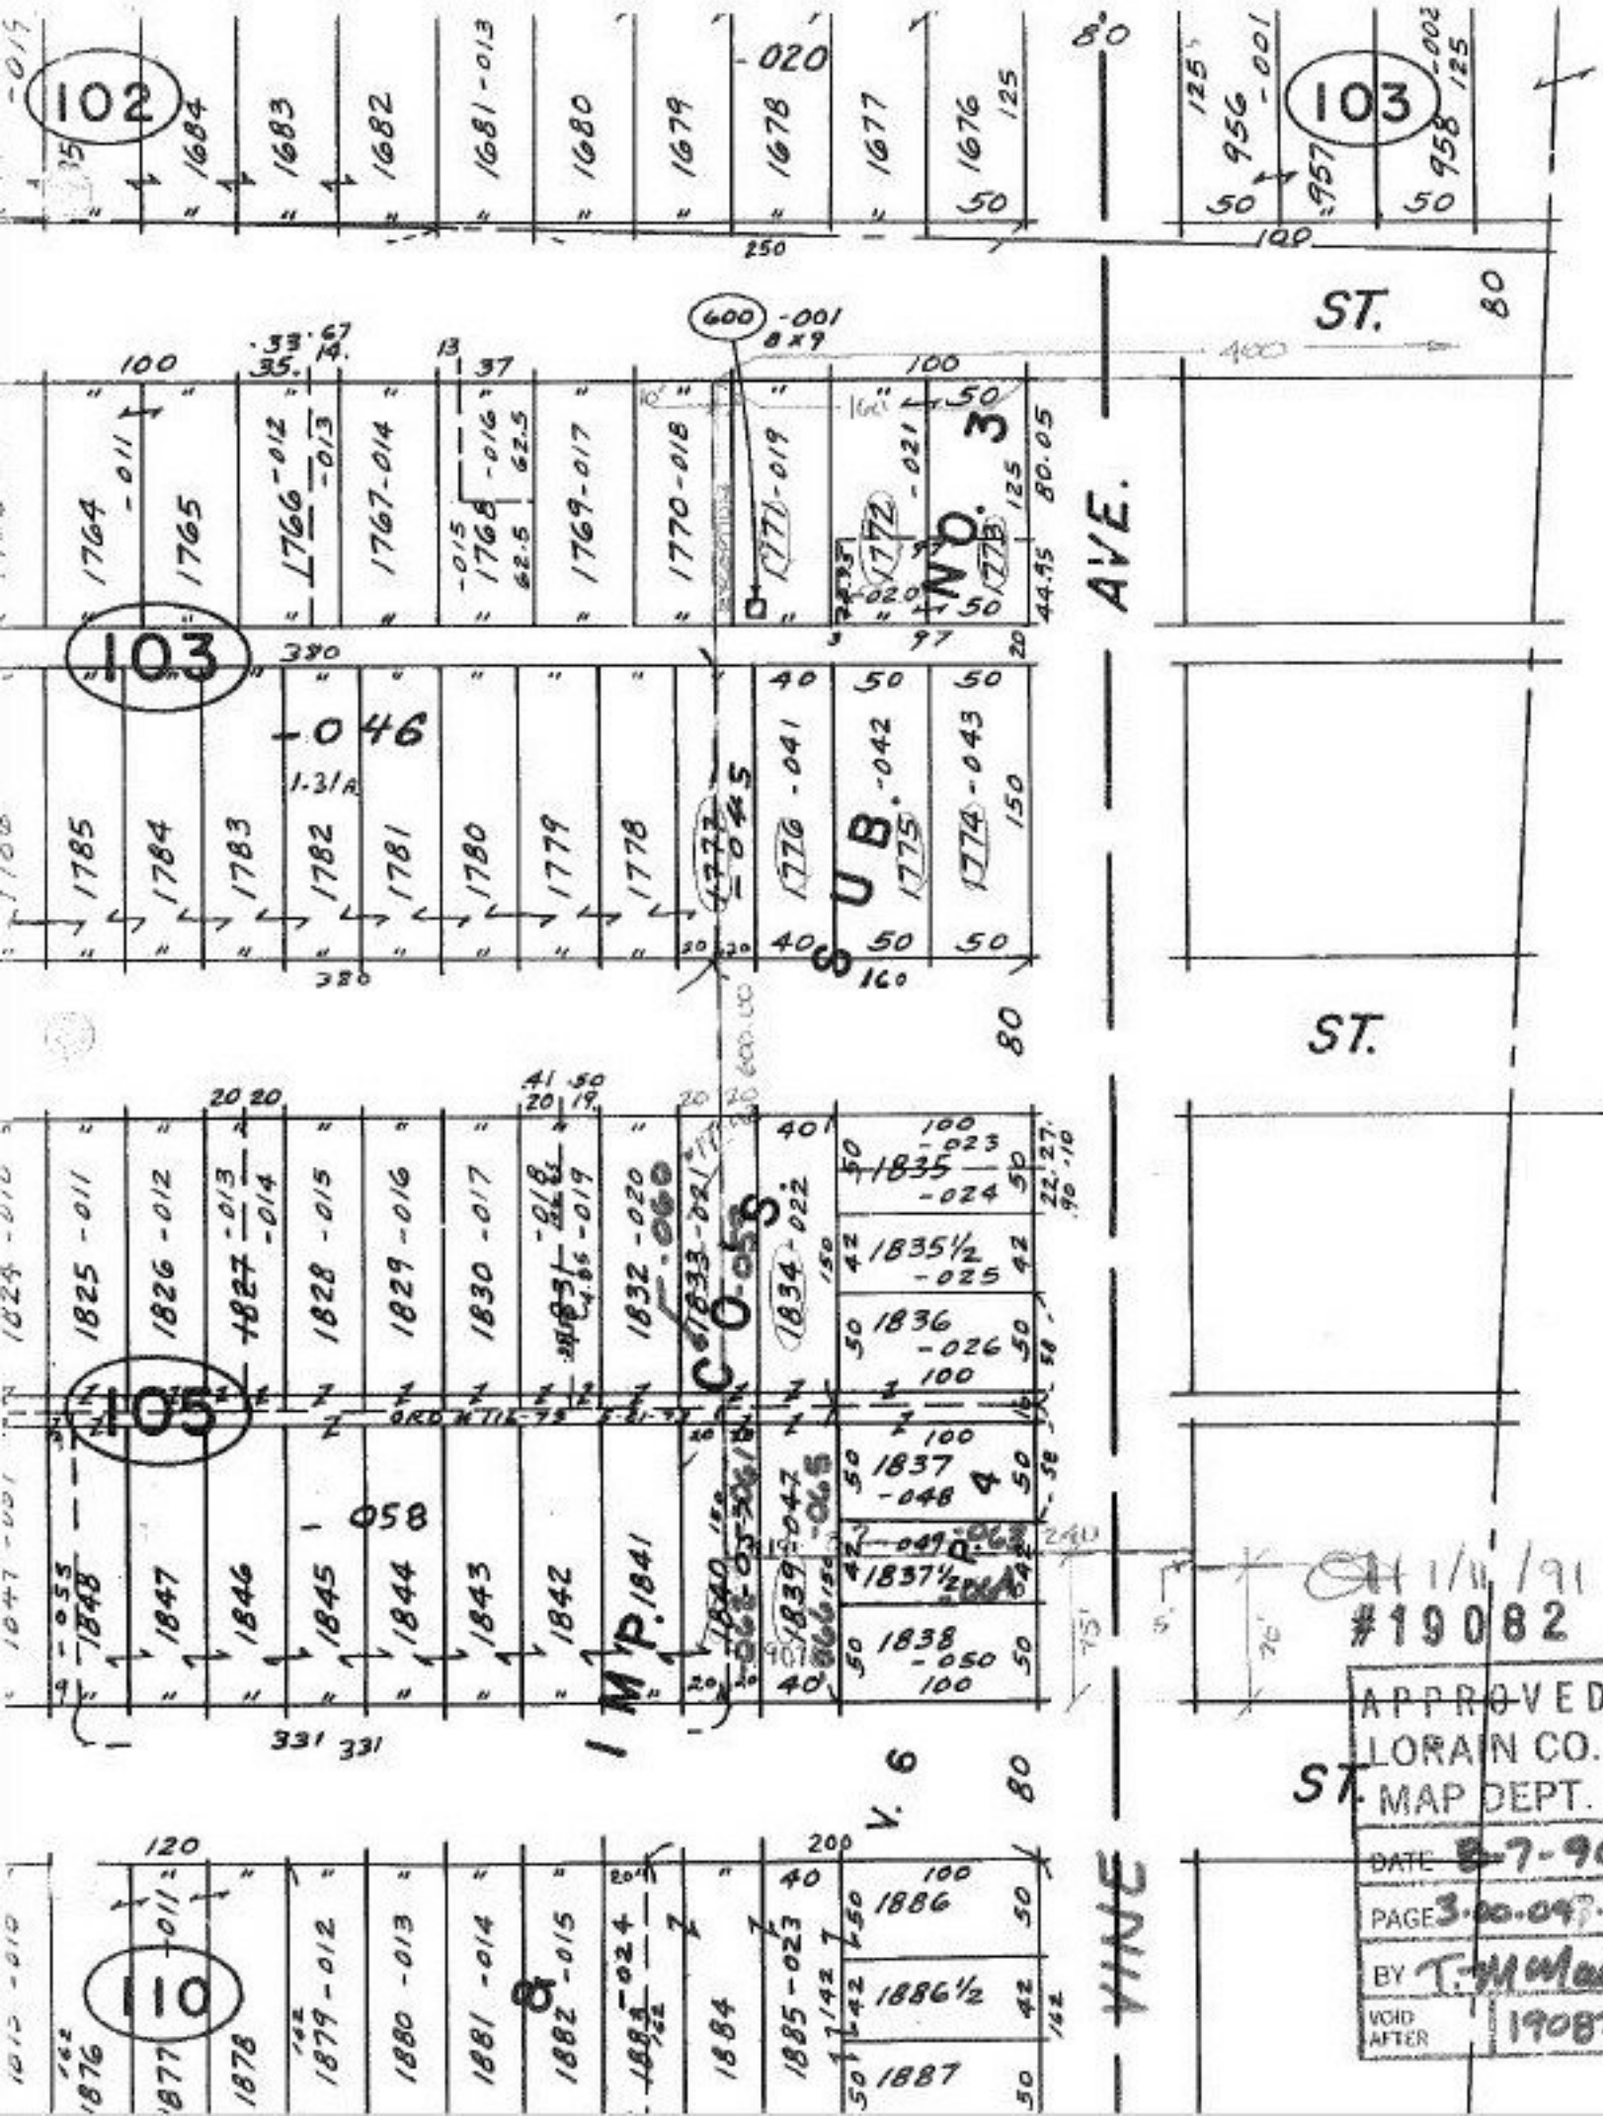
102
103
103
105
110
ST.
ST.
ST.
AVE.
VINE
SUB. NO. 3
COS.
IMP.
V. 6
#19082
APPROVED
LORAIN CO.
MAP DEPT.
DATE 8-7-90
PAGE 3-00-047-B
BY T. McMain
VOID AFTER 19082