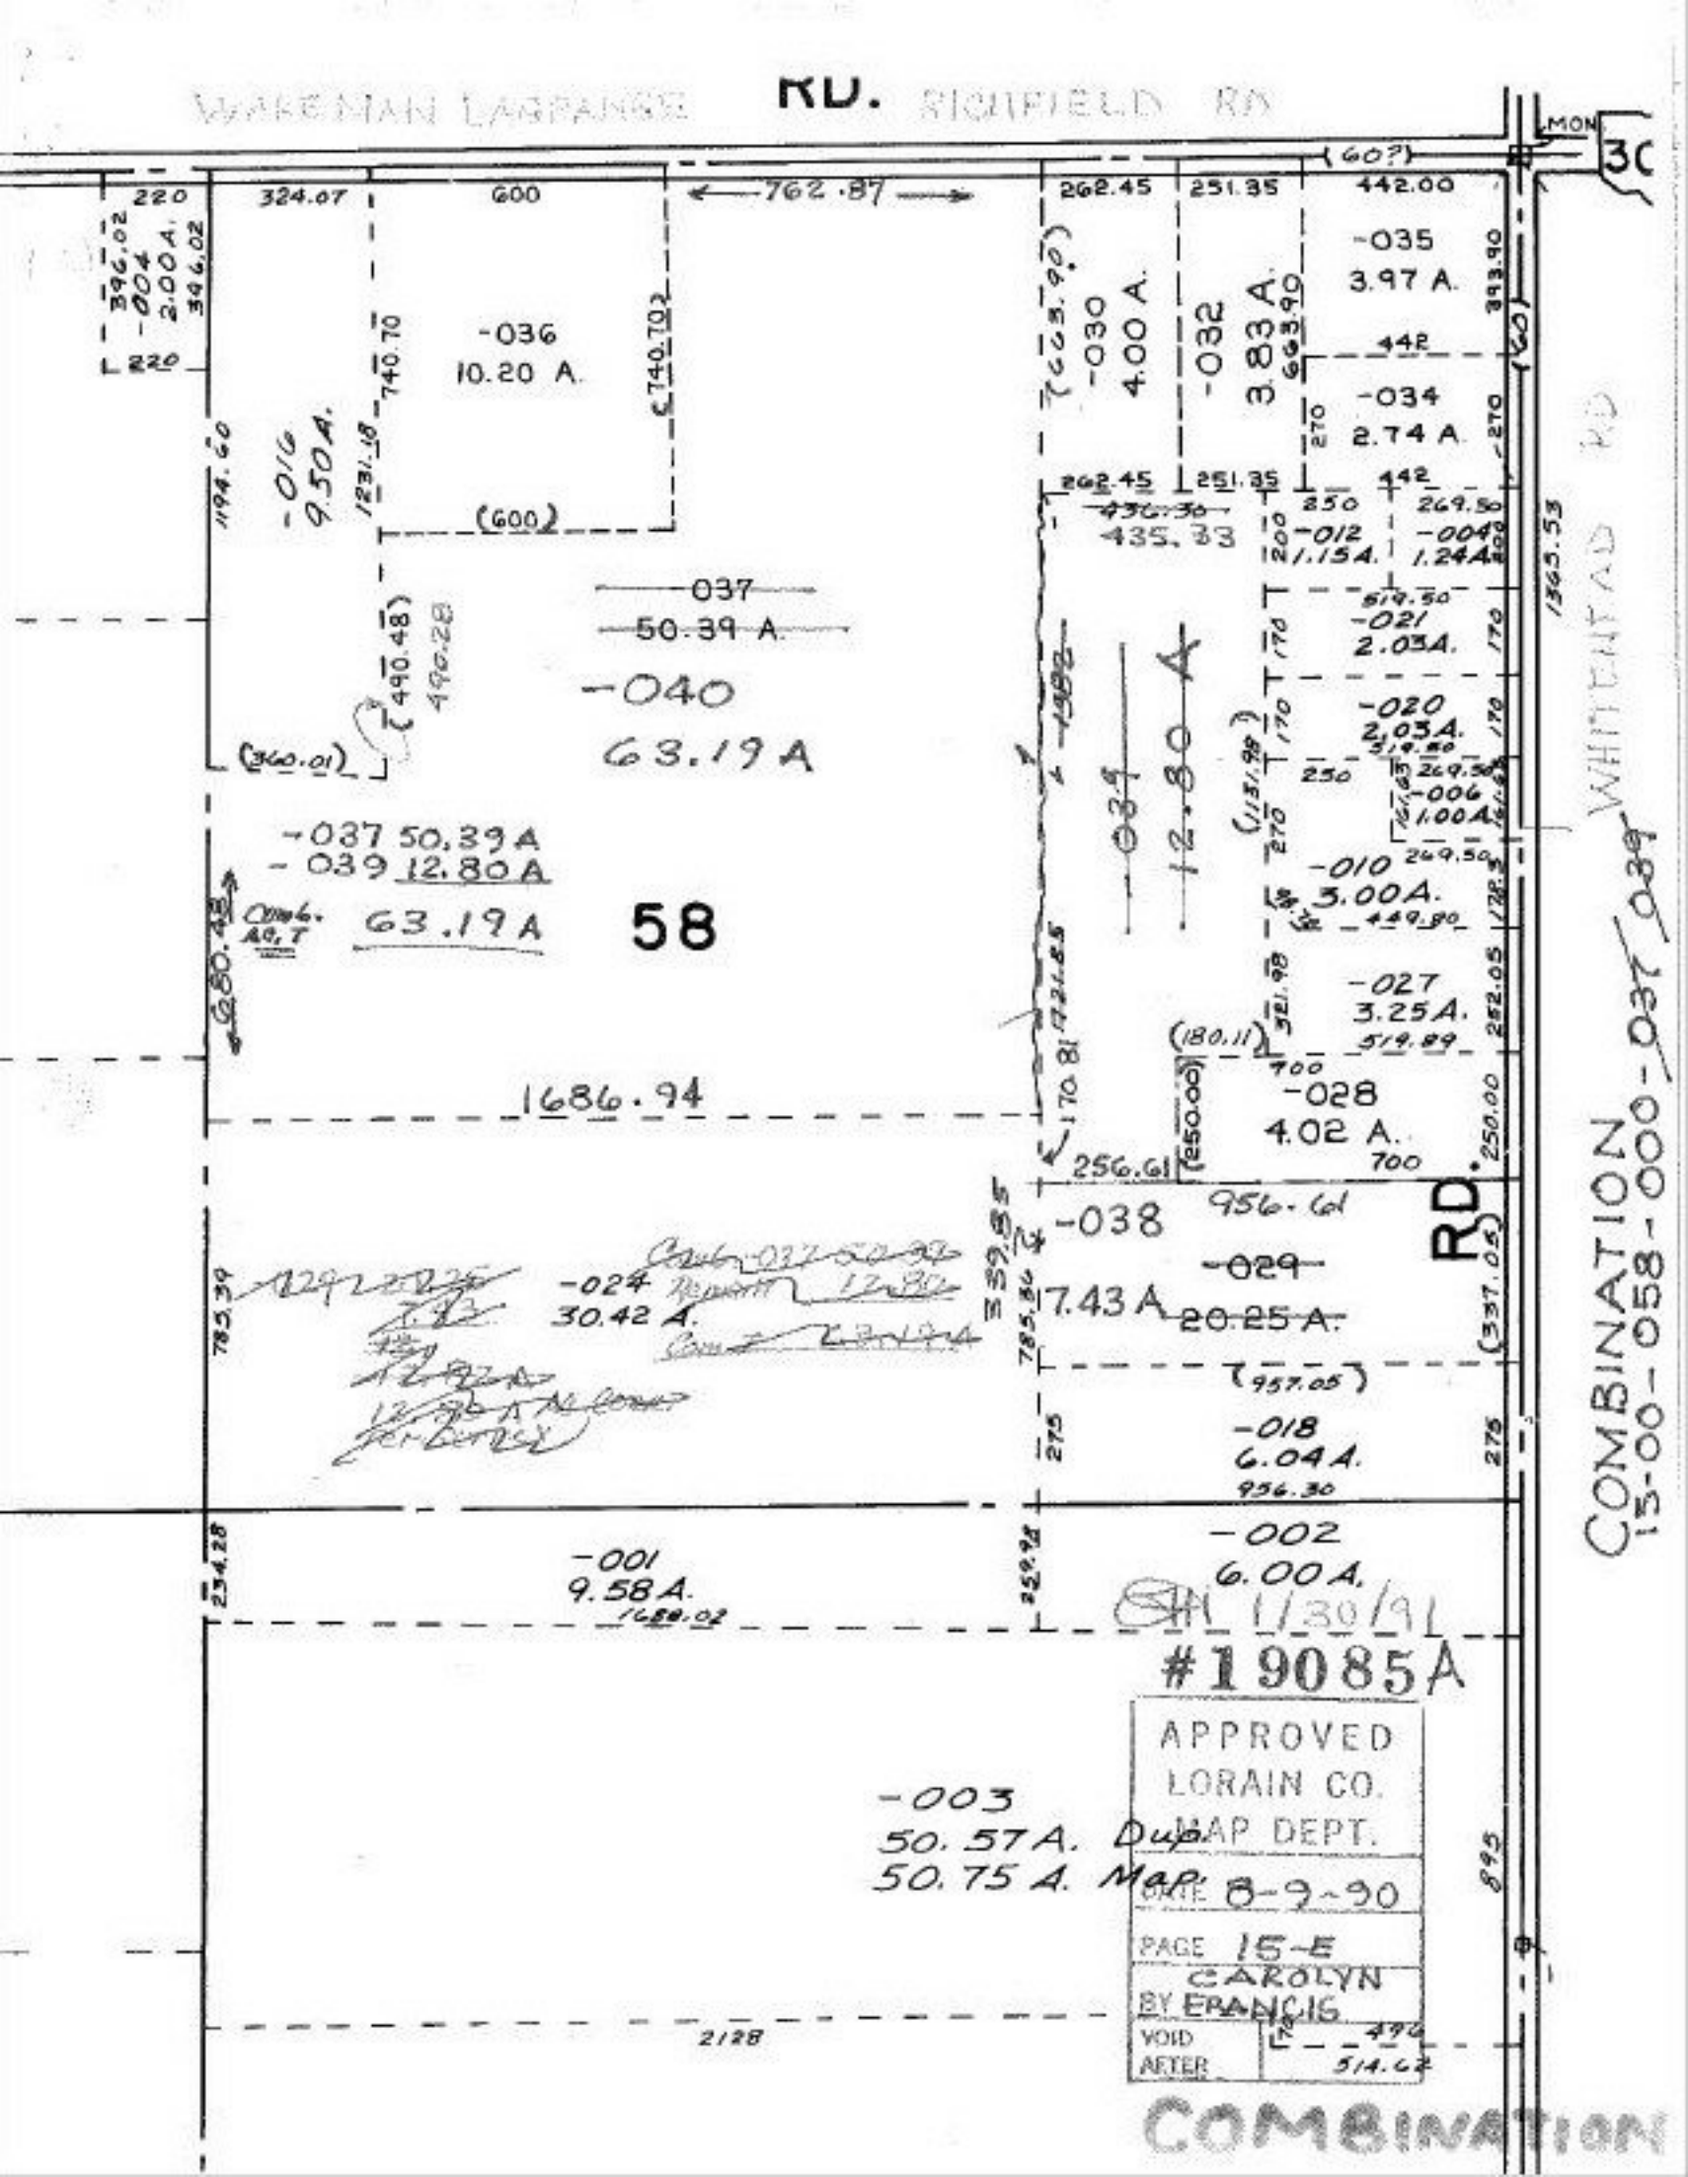
WAKEMAN LAGRANGE RD.
SIGNFIELD RD
MON
30
(60?)
220
324.07
600
762.87
262.45
251.35
442.00
-035
3.97 A.
-034
2.74 A.
-036
10.20 A.
-030
4.00 A.
-032
3.83 A.
-016
9.50 A.
740.70
1231.18
1194.60
(600)
037
50.39 A.
-040
63.19 A
(490.48)
490.28
(360.01)
-037 50.39 A
-039 12.80 A
Comb. Ag. T
63.19 A
58
680.42
1686.94
-012
1.15 A.
-004
1.24 A.
-021
2.03 A.
-020
2.03 A.
-006
1.00 A.
-010
3.00 A.
-027
3.25 A.
-028
4.02 A.
034
12.80 A
170.81
1321.85
256.61
(250.00)
(180.11)
956.61
-038
7.43 A
-029
20.25 A.
RD.
-024
30.42 A.
785.39
785.86
(957.05)
-018
6.04 A.
956.30
-001
9.58 A.
1680.02
-002
6.00 A.
234.28
252.92
#19085A
APPROVED
LORAIN CO.
MAP DEPT.
DATE 8-9-90
PAGE 15-E
CAROLYN
BY FRANCIS
VOID
AFTER
-003
50.57 A. Dup.
50.75 A. Map
2128
895
1365.53
WHITEHEAD RD
COMBINATION
15-00-058-000-037 039
COMBINATION