SEE 1-00-030-A

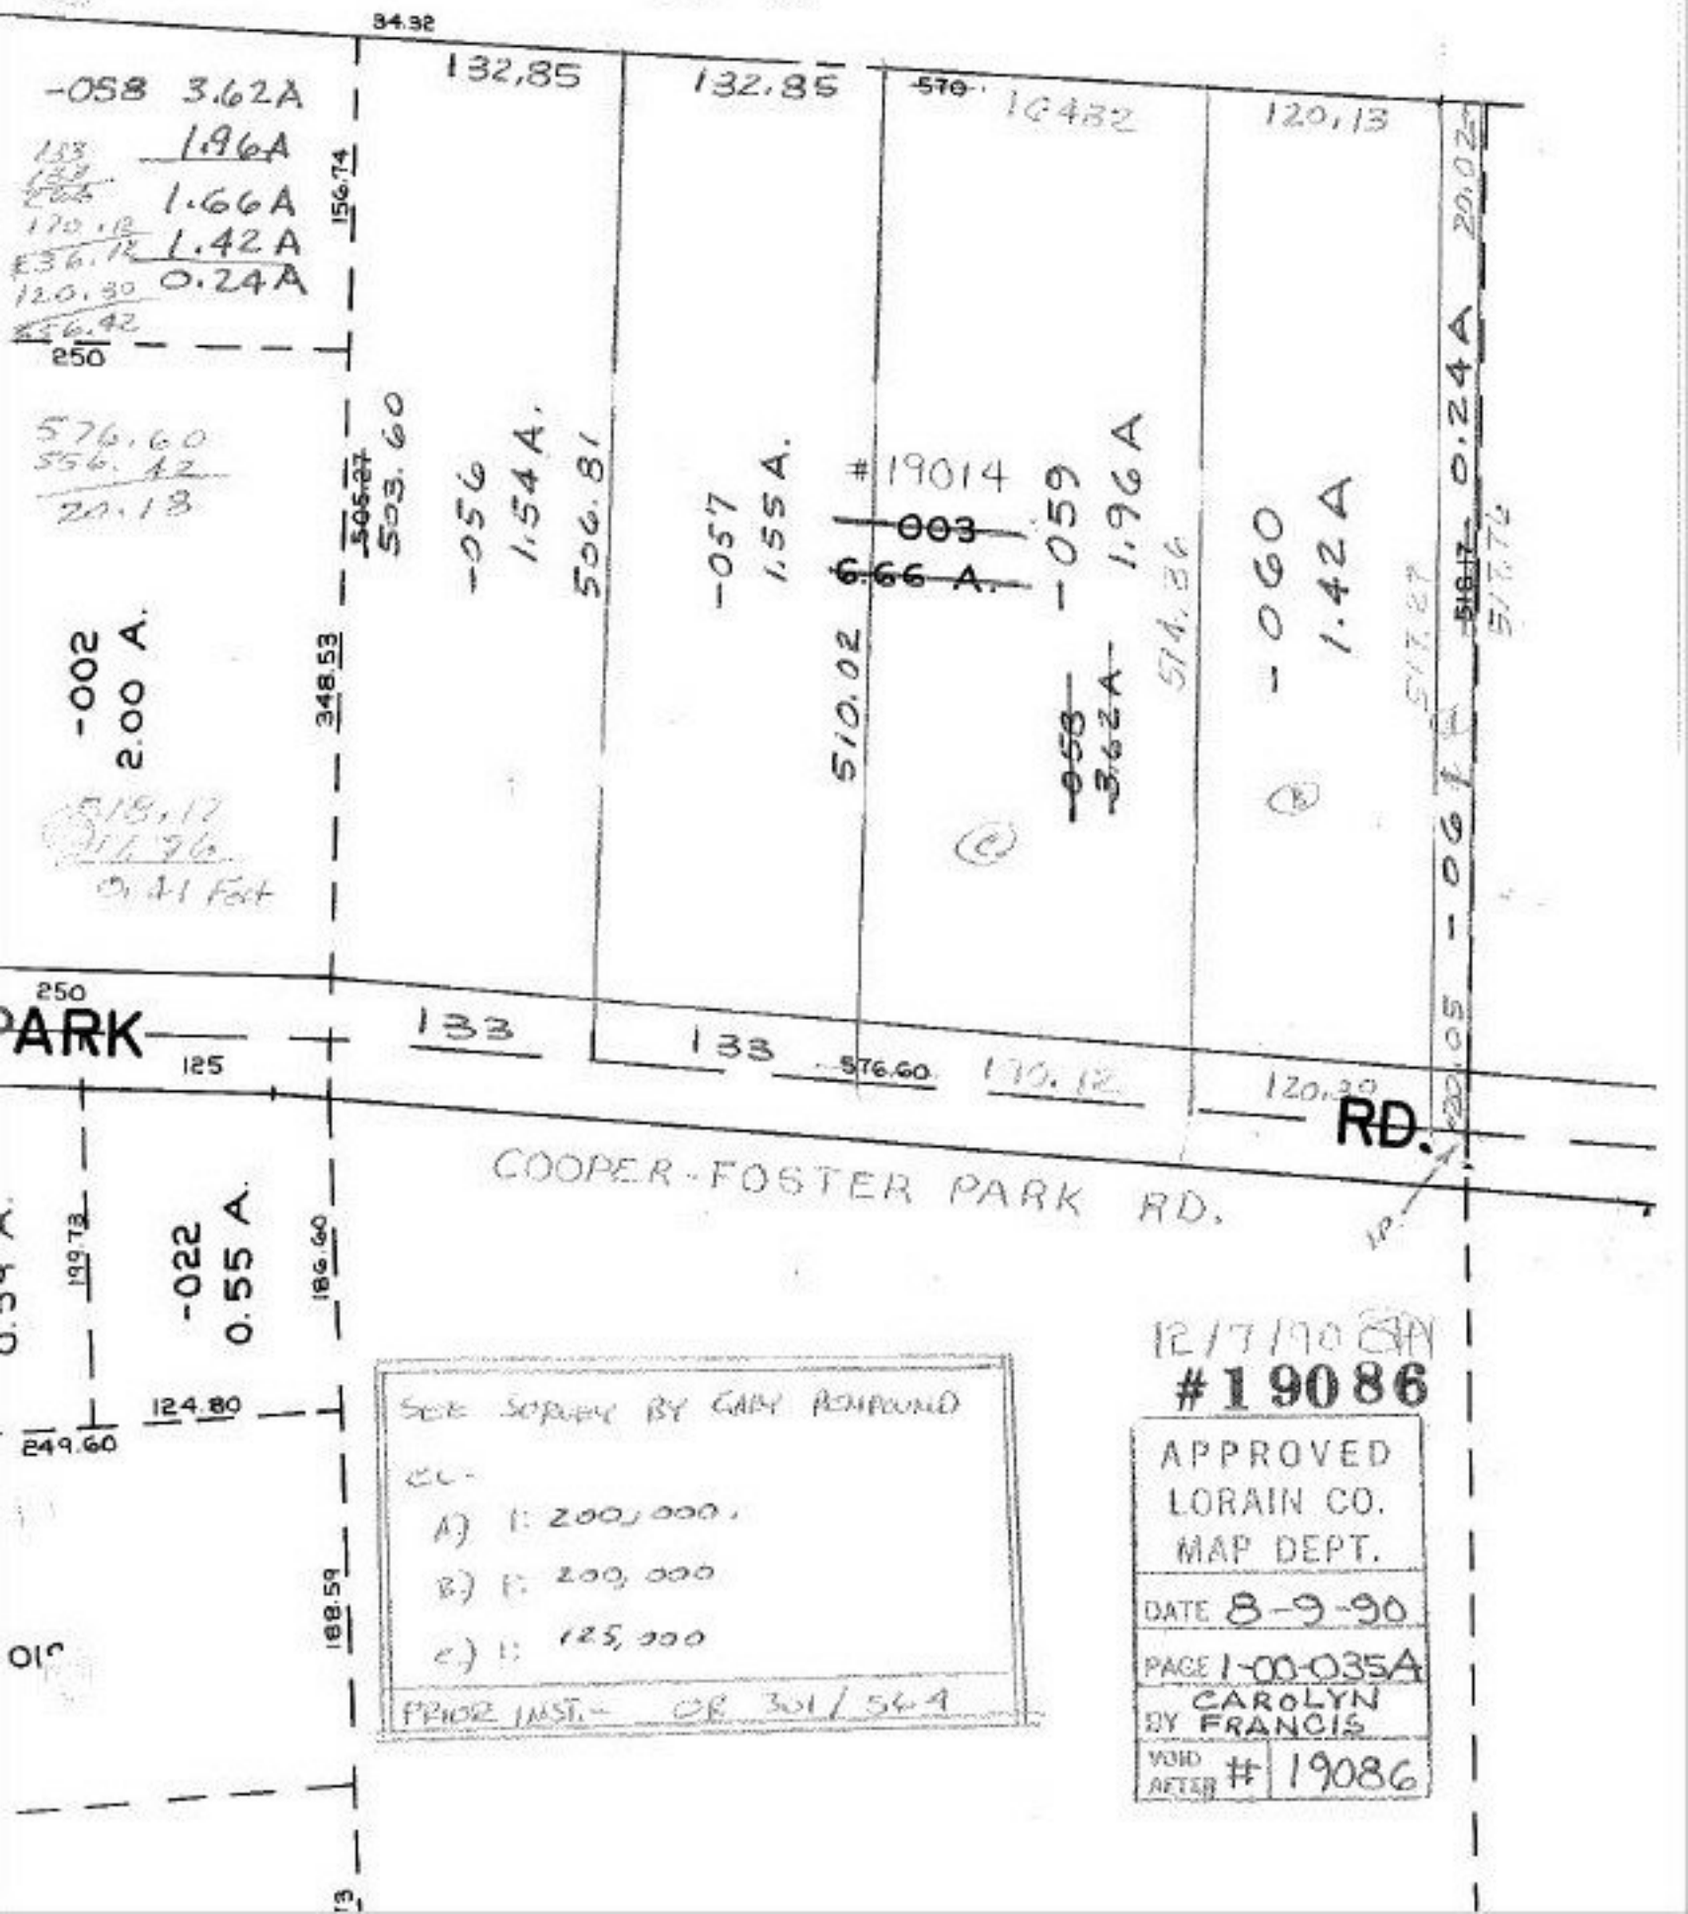
84.32
-058 3.62A
1.96A
1.66A
1.42A
0.24A
132.85
132.85
570
10432
120.13
156.74
250
576.60
556.42
20.13
505.27
503.60
-056
1.54A.
506.81
-057
1.55A.
#19014
003
6.66 A.
510.02
-059
1.96A
514.36
-058
3.62A
-060
1.42A
518.17
0.24A
20.02
-002
2.00 A.
348.53
519.12
514.36
0.41 Ext
250
PARK
125
133
133
576.60
170.12
120.30
RD.
COOPER-FOSTER PARK RD.
20.05
-066
-022
0.55 A.
199.73
186.60
124.80
249.60
188.59
SEE SURVEY BY GARY ROMBOUD
CC-
A) $ 200,000.
B) $ 200,000
C) $ 125,000
PRIOR INST.- OR 301/564
12/7/90 GRH
#19086
APPROVED
LORAIN CO.
MAP DEPT.
DATE 8-9-90
PAGE 1-00-035A
BY CAROLYN FRANCIS
VOID AFTER # 19086