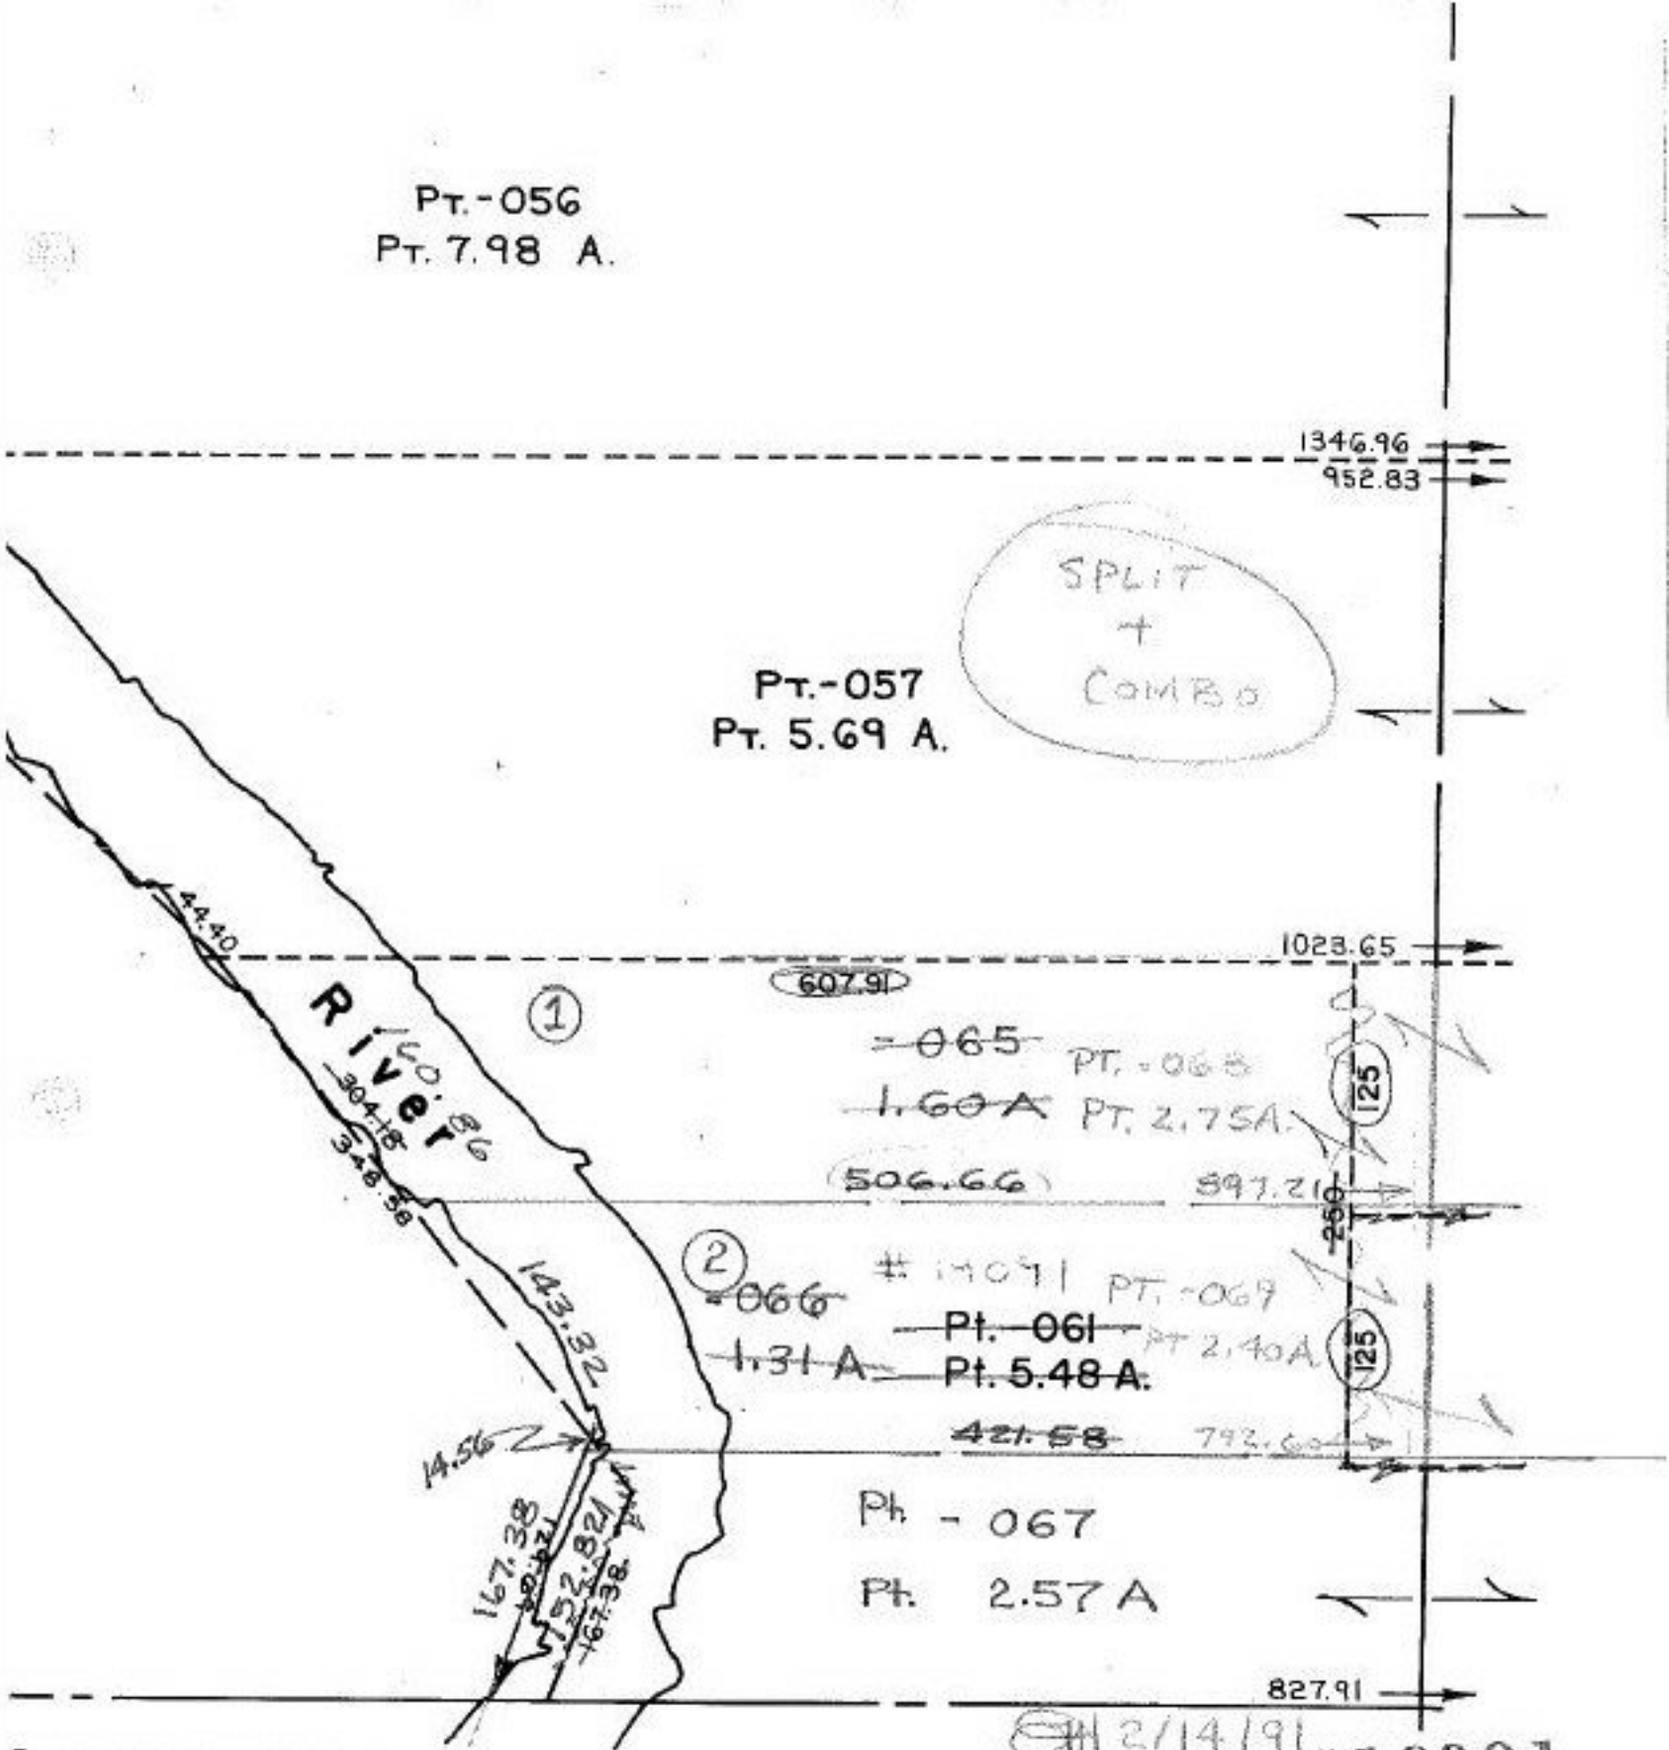

12-00-038-000- PRIOR INST. OR.291/256 C=1:1000,000 ©
SURVEYED BY: GILES NELSON REG. SURVEYOR 1: 200,000 @

APPROVED
LORAIN CO.
MAP DEPT.
DATE 8-24-90
PAGE 12-00-038 A
BY CAROLYN FRANCIS
VOID AFTER # 19091