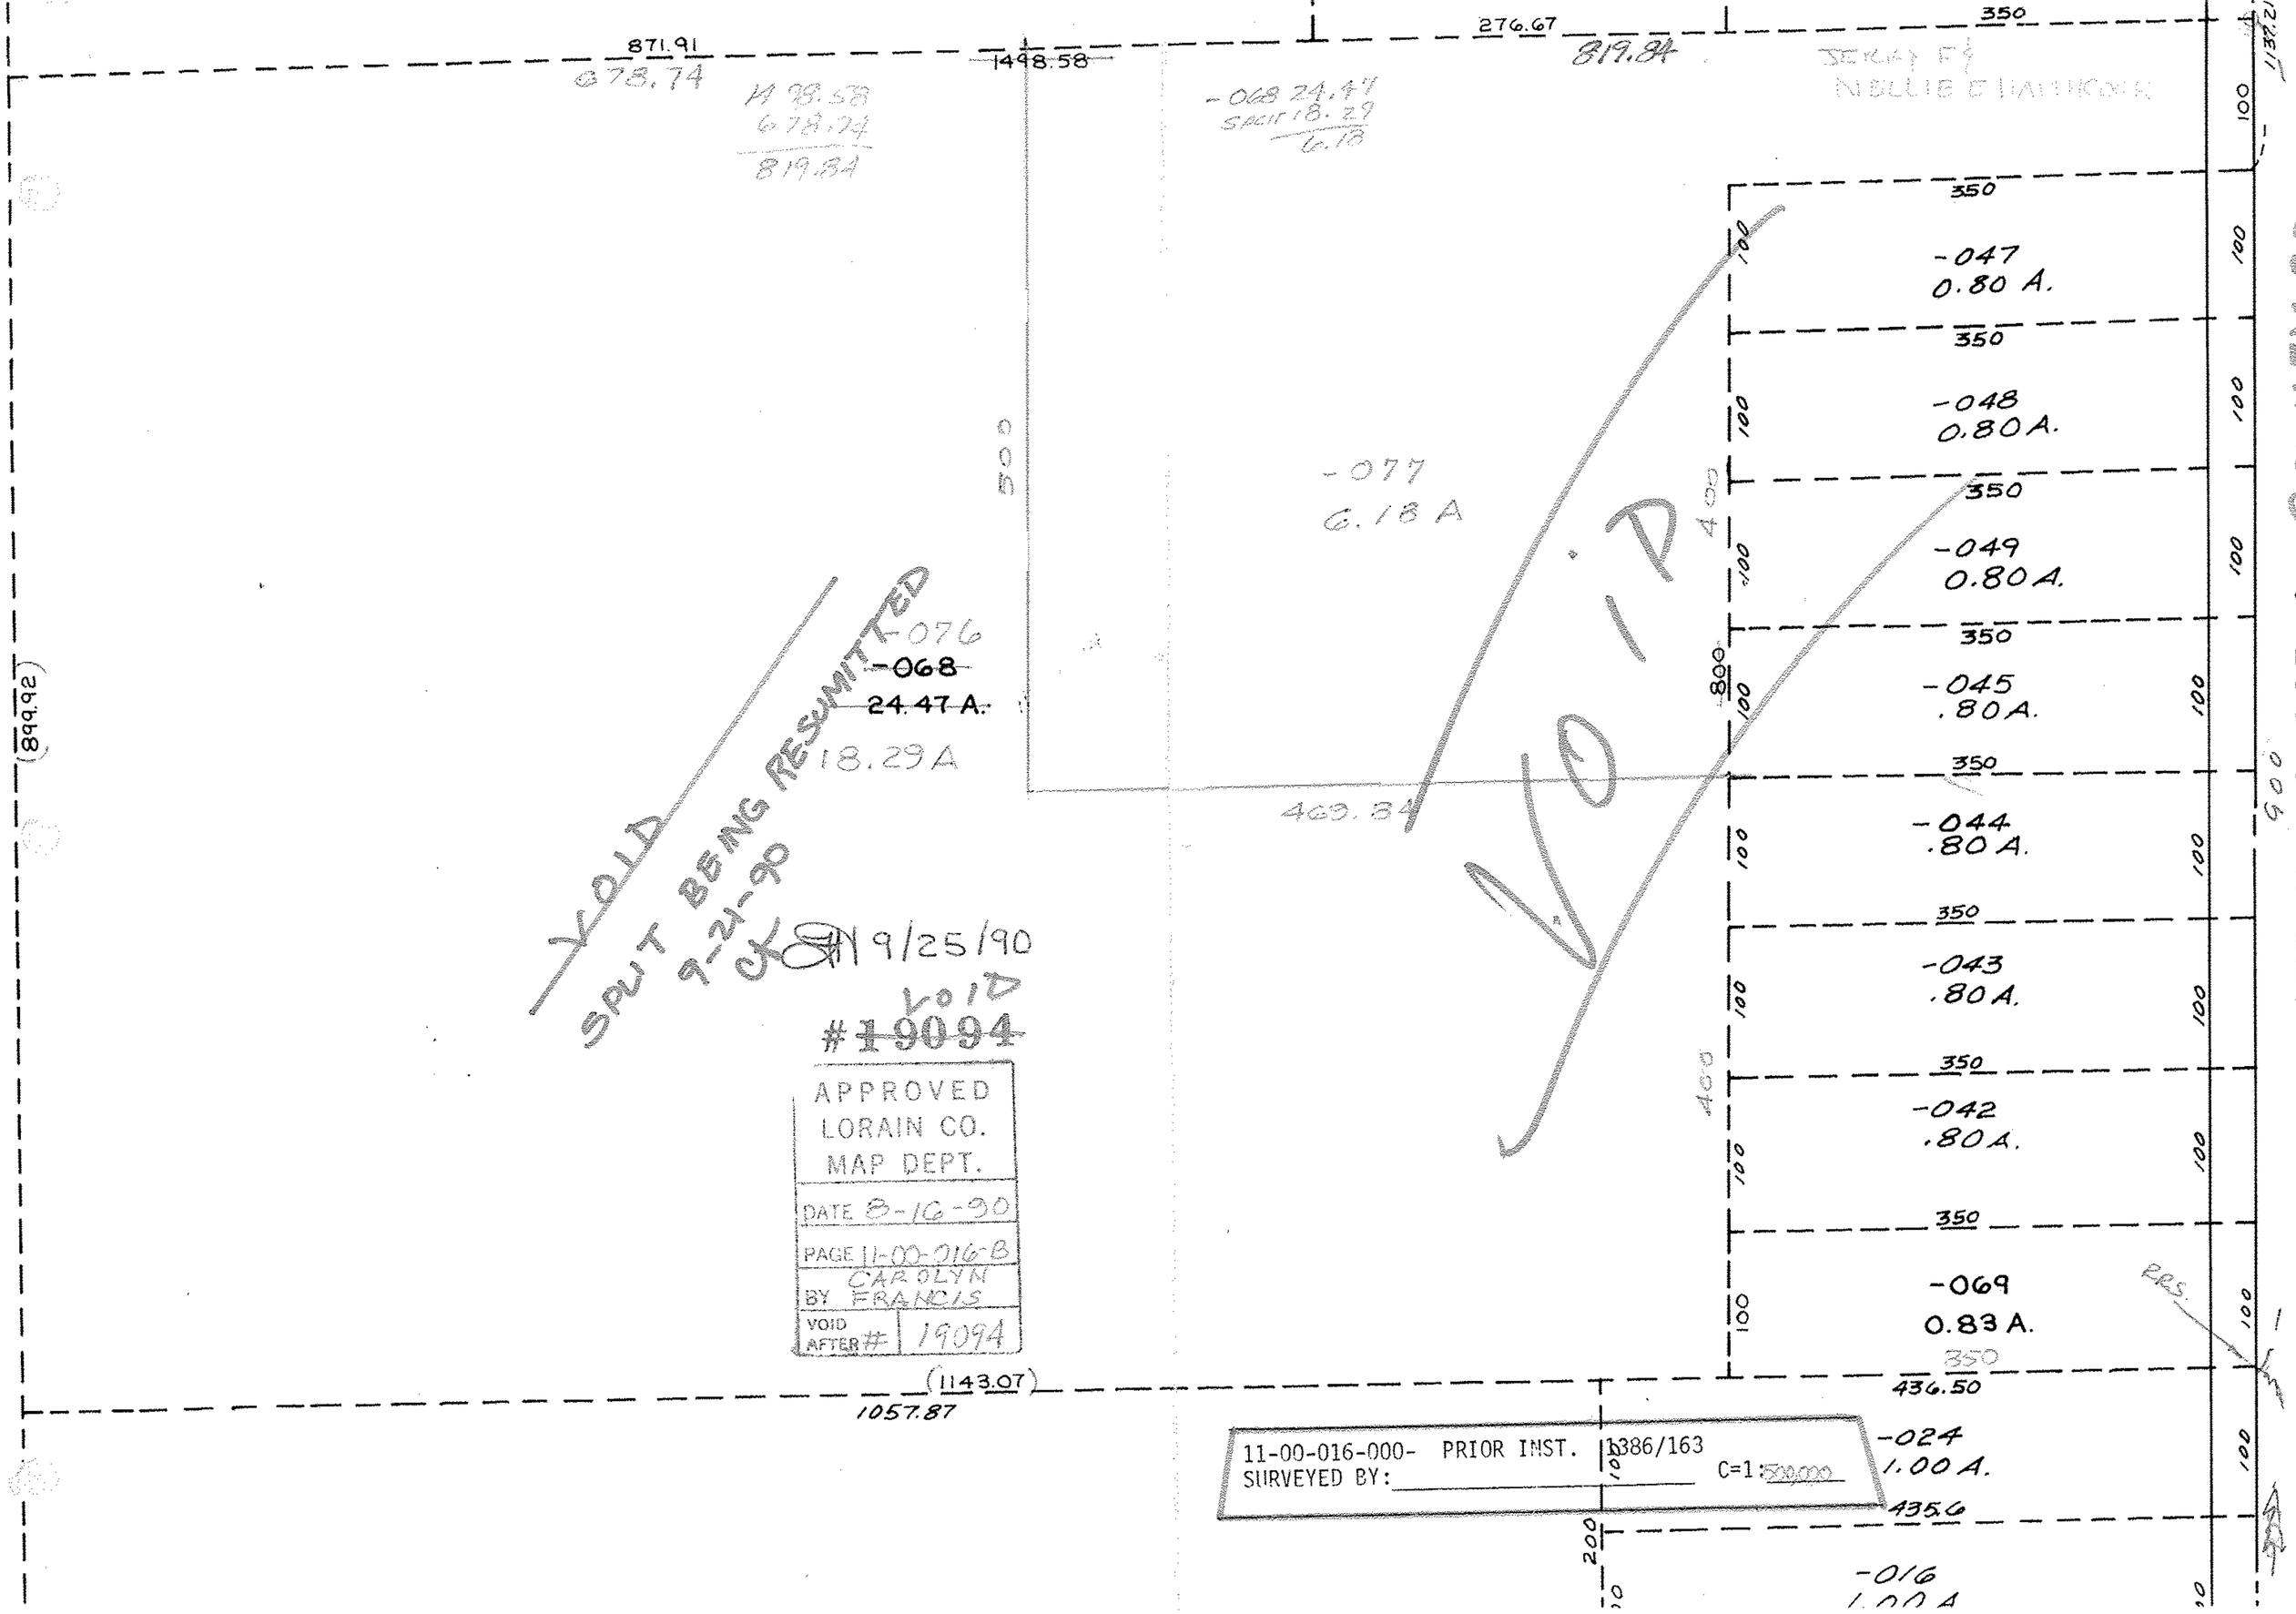

871.91
678.74
1498.58
1498.58
678.74
819.84
276.67
819.84
-068 24.47
SPLIT 18.29
6.18
-077
6.18 A
-076
-068
24.47 A.
18.29 A
469.84
VOID
SPLIT BEING RESUMITTED
9-21-90
9/25/90
VOID
#19094
APPROVED
LORAIN CO.
MAP DEPT.
DATE 8-16-90
PAGE 11-00-016-B
BY CAROLYN FRANCIS
VOID AFTER # 19094
(899.92)
(1143.07)
1057.87
-047
0.80 A.
-048
0.80 A.
-049
0.80 A.
-045
.80 A.
-044
.80 A.
-043
.80 A.
-042
.80 A.
-069
0.83 A.
436.50
-024
1.00 A.
435.6
-016
1.00 A
COWLEY RD.
SEE 11-00-005-A
11-00-016-000- PRIOR INST. 1386/163
SURVEYED BY:
C=1:500,000