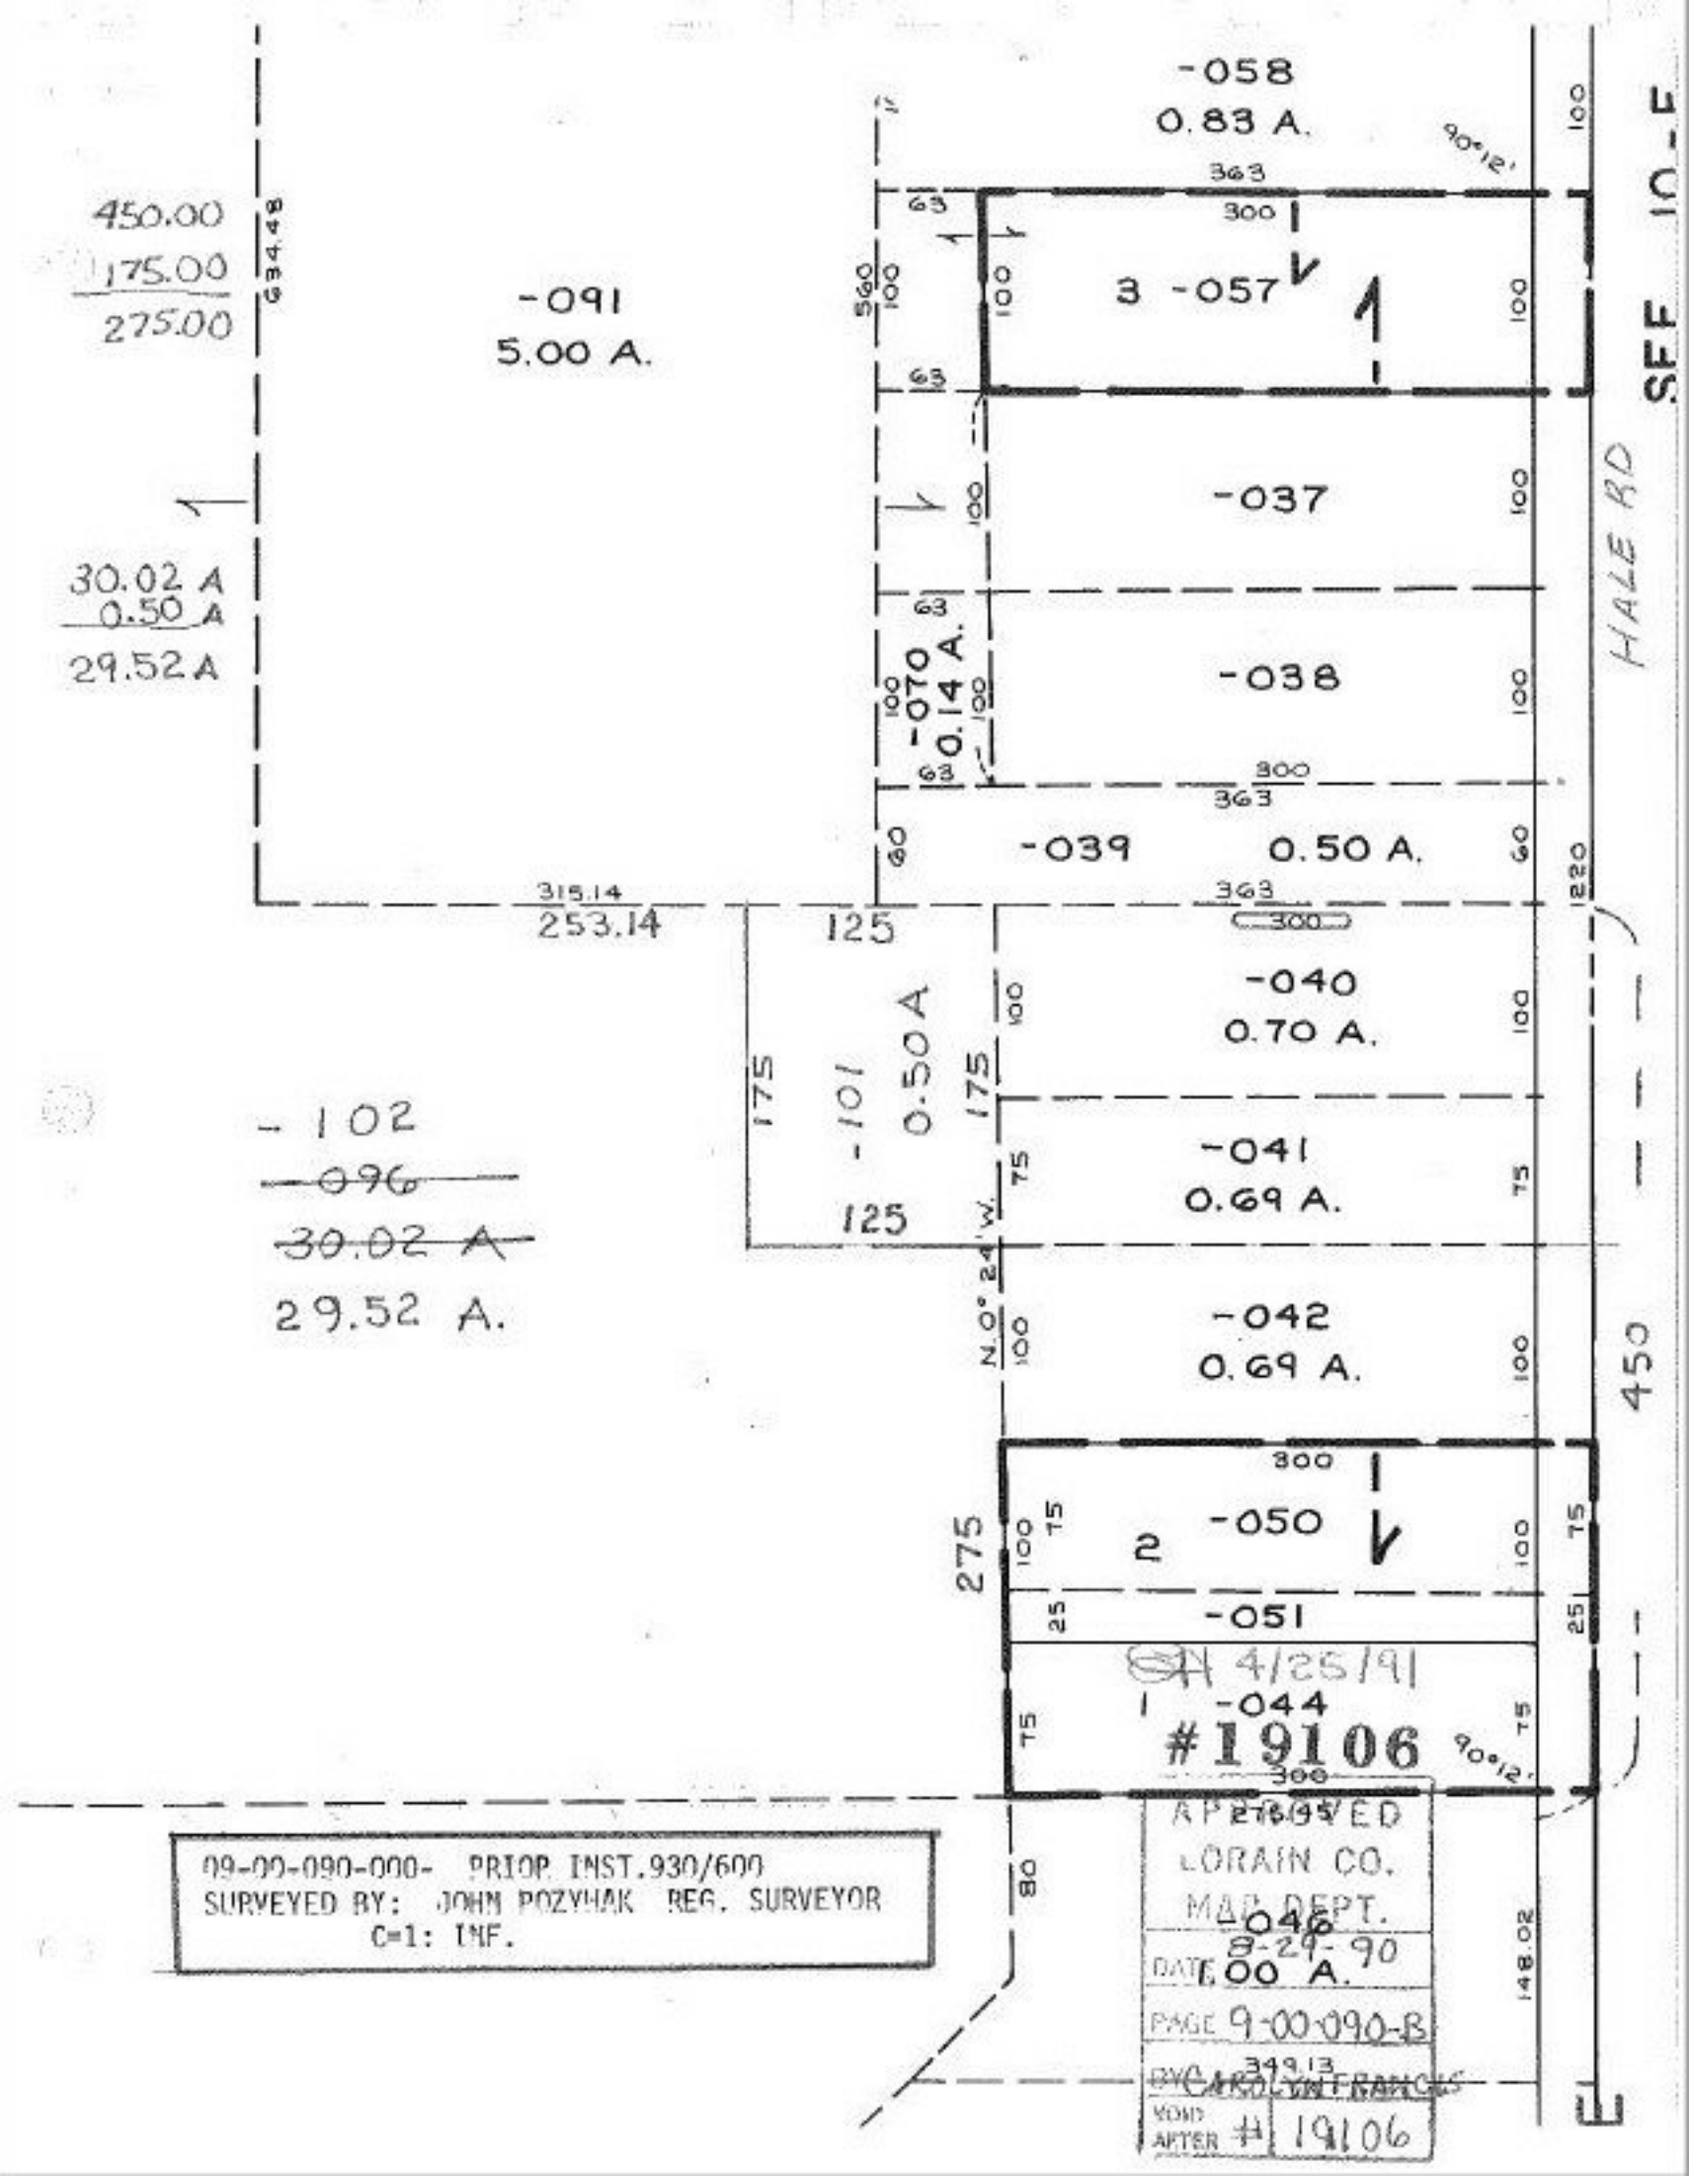
-058
0.83 A.
-091
5.00 A.
450.00
175.00
275.00
634.48
30.02 A
0.50 A
29.52 A
3 -057
-037
-038
-070
0.14 A.
-039 0.50 A.
315.14
253.14
125
-040
0.70 A.
-101
0.50 A
175
-041
0.69 A.
-102
-096
30.02 A
29.52 A.
N.0° 24' W.
-042
0.69 A.
275
-050
2
-051
-044
#19106
4/25/91
90°12'
HALE RD
SFF 10-E
450
09-00-090-000- PRIOR INST. 930/600
SURVEYED BY: JOHN POZYHAK REG. SURVEYOR
C=1: INF.
APPROVED
LORAIN CO.
MAP DEPT.
8-29-90
DATE
PAGE 9-00-090-B
BY CAROLYN FRANCIS
VOID AFTER #19106
046
00 A.
349.13
148.02
80