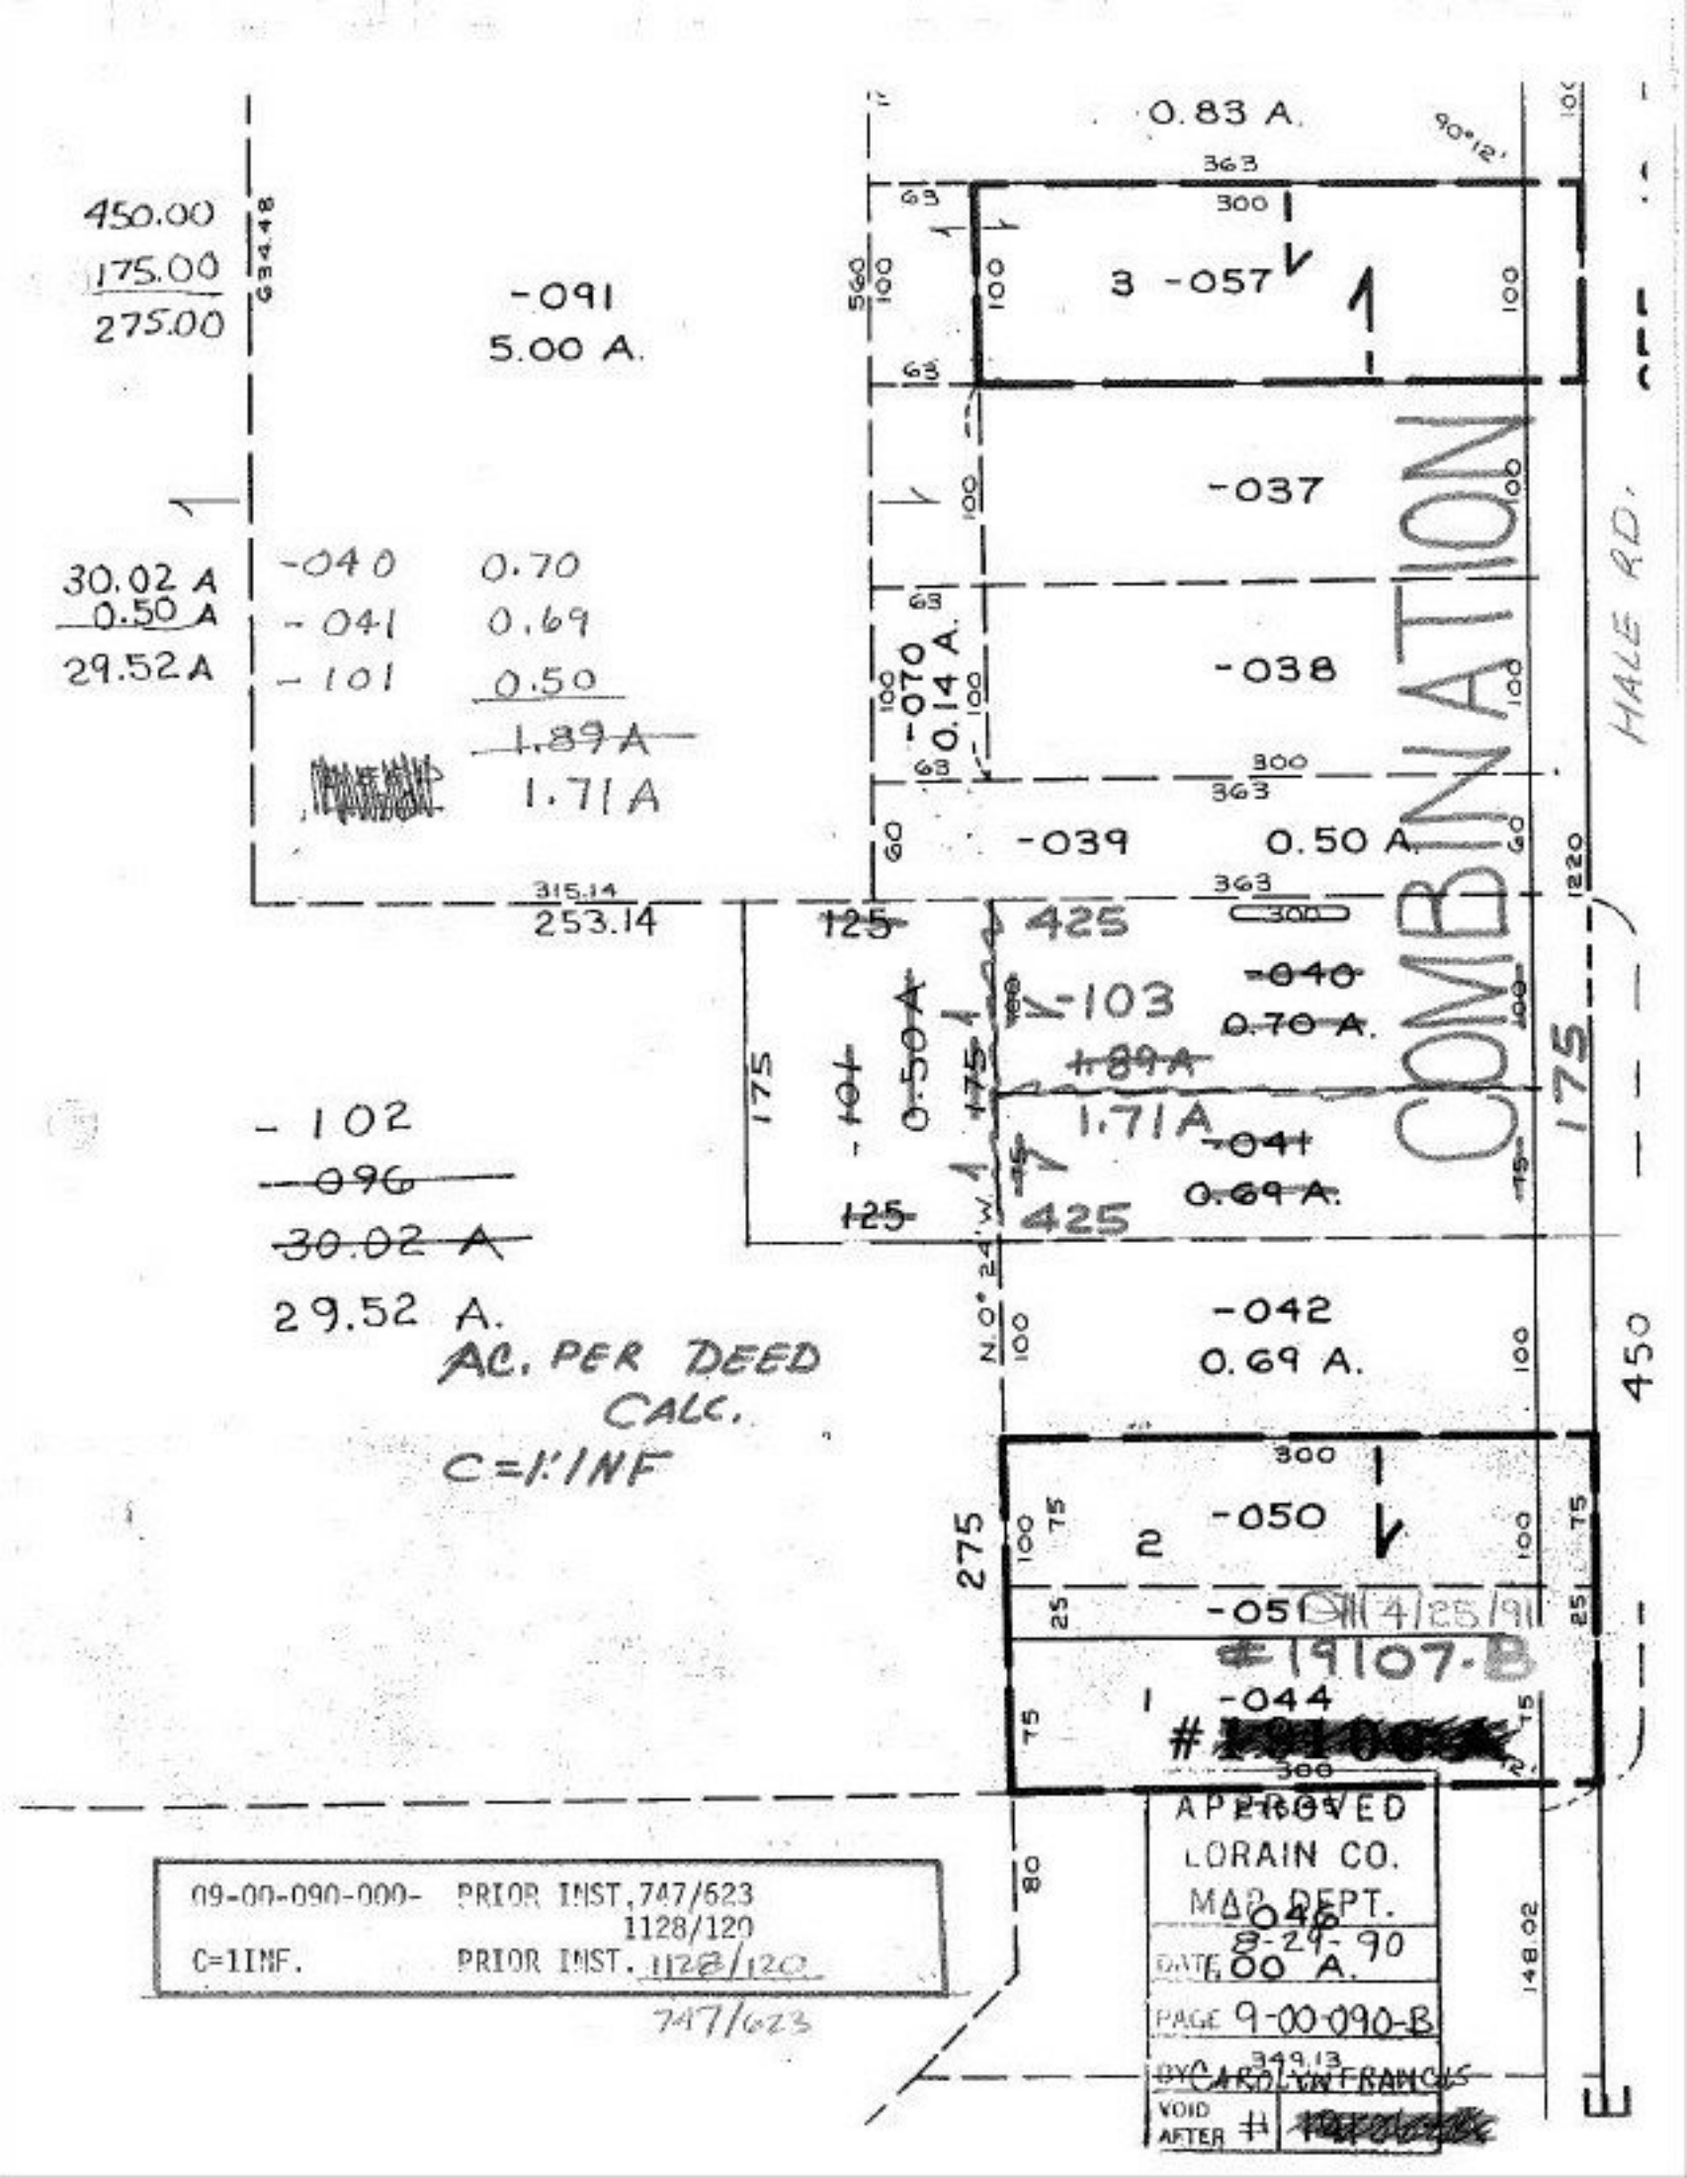
450.00
175.00
275.00
G34.48
-091
5.00 A.
30.02 A
0.50 A
29.52 A
-040 0.70
-041 0.69
-101 0.50
1.89 A
1.71 A
315.14
253.14
-102
-096
30.02 A
29.52 A.
AC. PER DEED
CALC.
C=1'INF
0.83 A.
90°12'
363
300
3 -057
-037
-038
-070 0.14 A.
-039 0.50 A.
125
425
-040
0.70 A.
-103
1.89 A
1.71 A
-041
0.69 A.
-101
0.50 A.
175
COMBINATION
HALE RD.
-042
0.69 A.
N.0° 24' W.
450
275
2
-050
-051
1
-044
#19107-B
4/25/91
APPROVED
LORAIN CO.
MAP DEPT.
8-24-90
DATE
PAGE 9-00-090-B
BY CAROLYN FRANCIS
VOID AFTER #
09-00-090-000- PRIOR INST. 747/623
1128/120
C=1INF. PRIOR INST. 1128/120
747/623
80
148.02
349.13
E