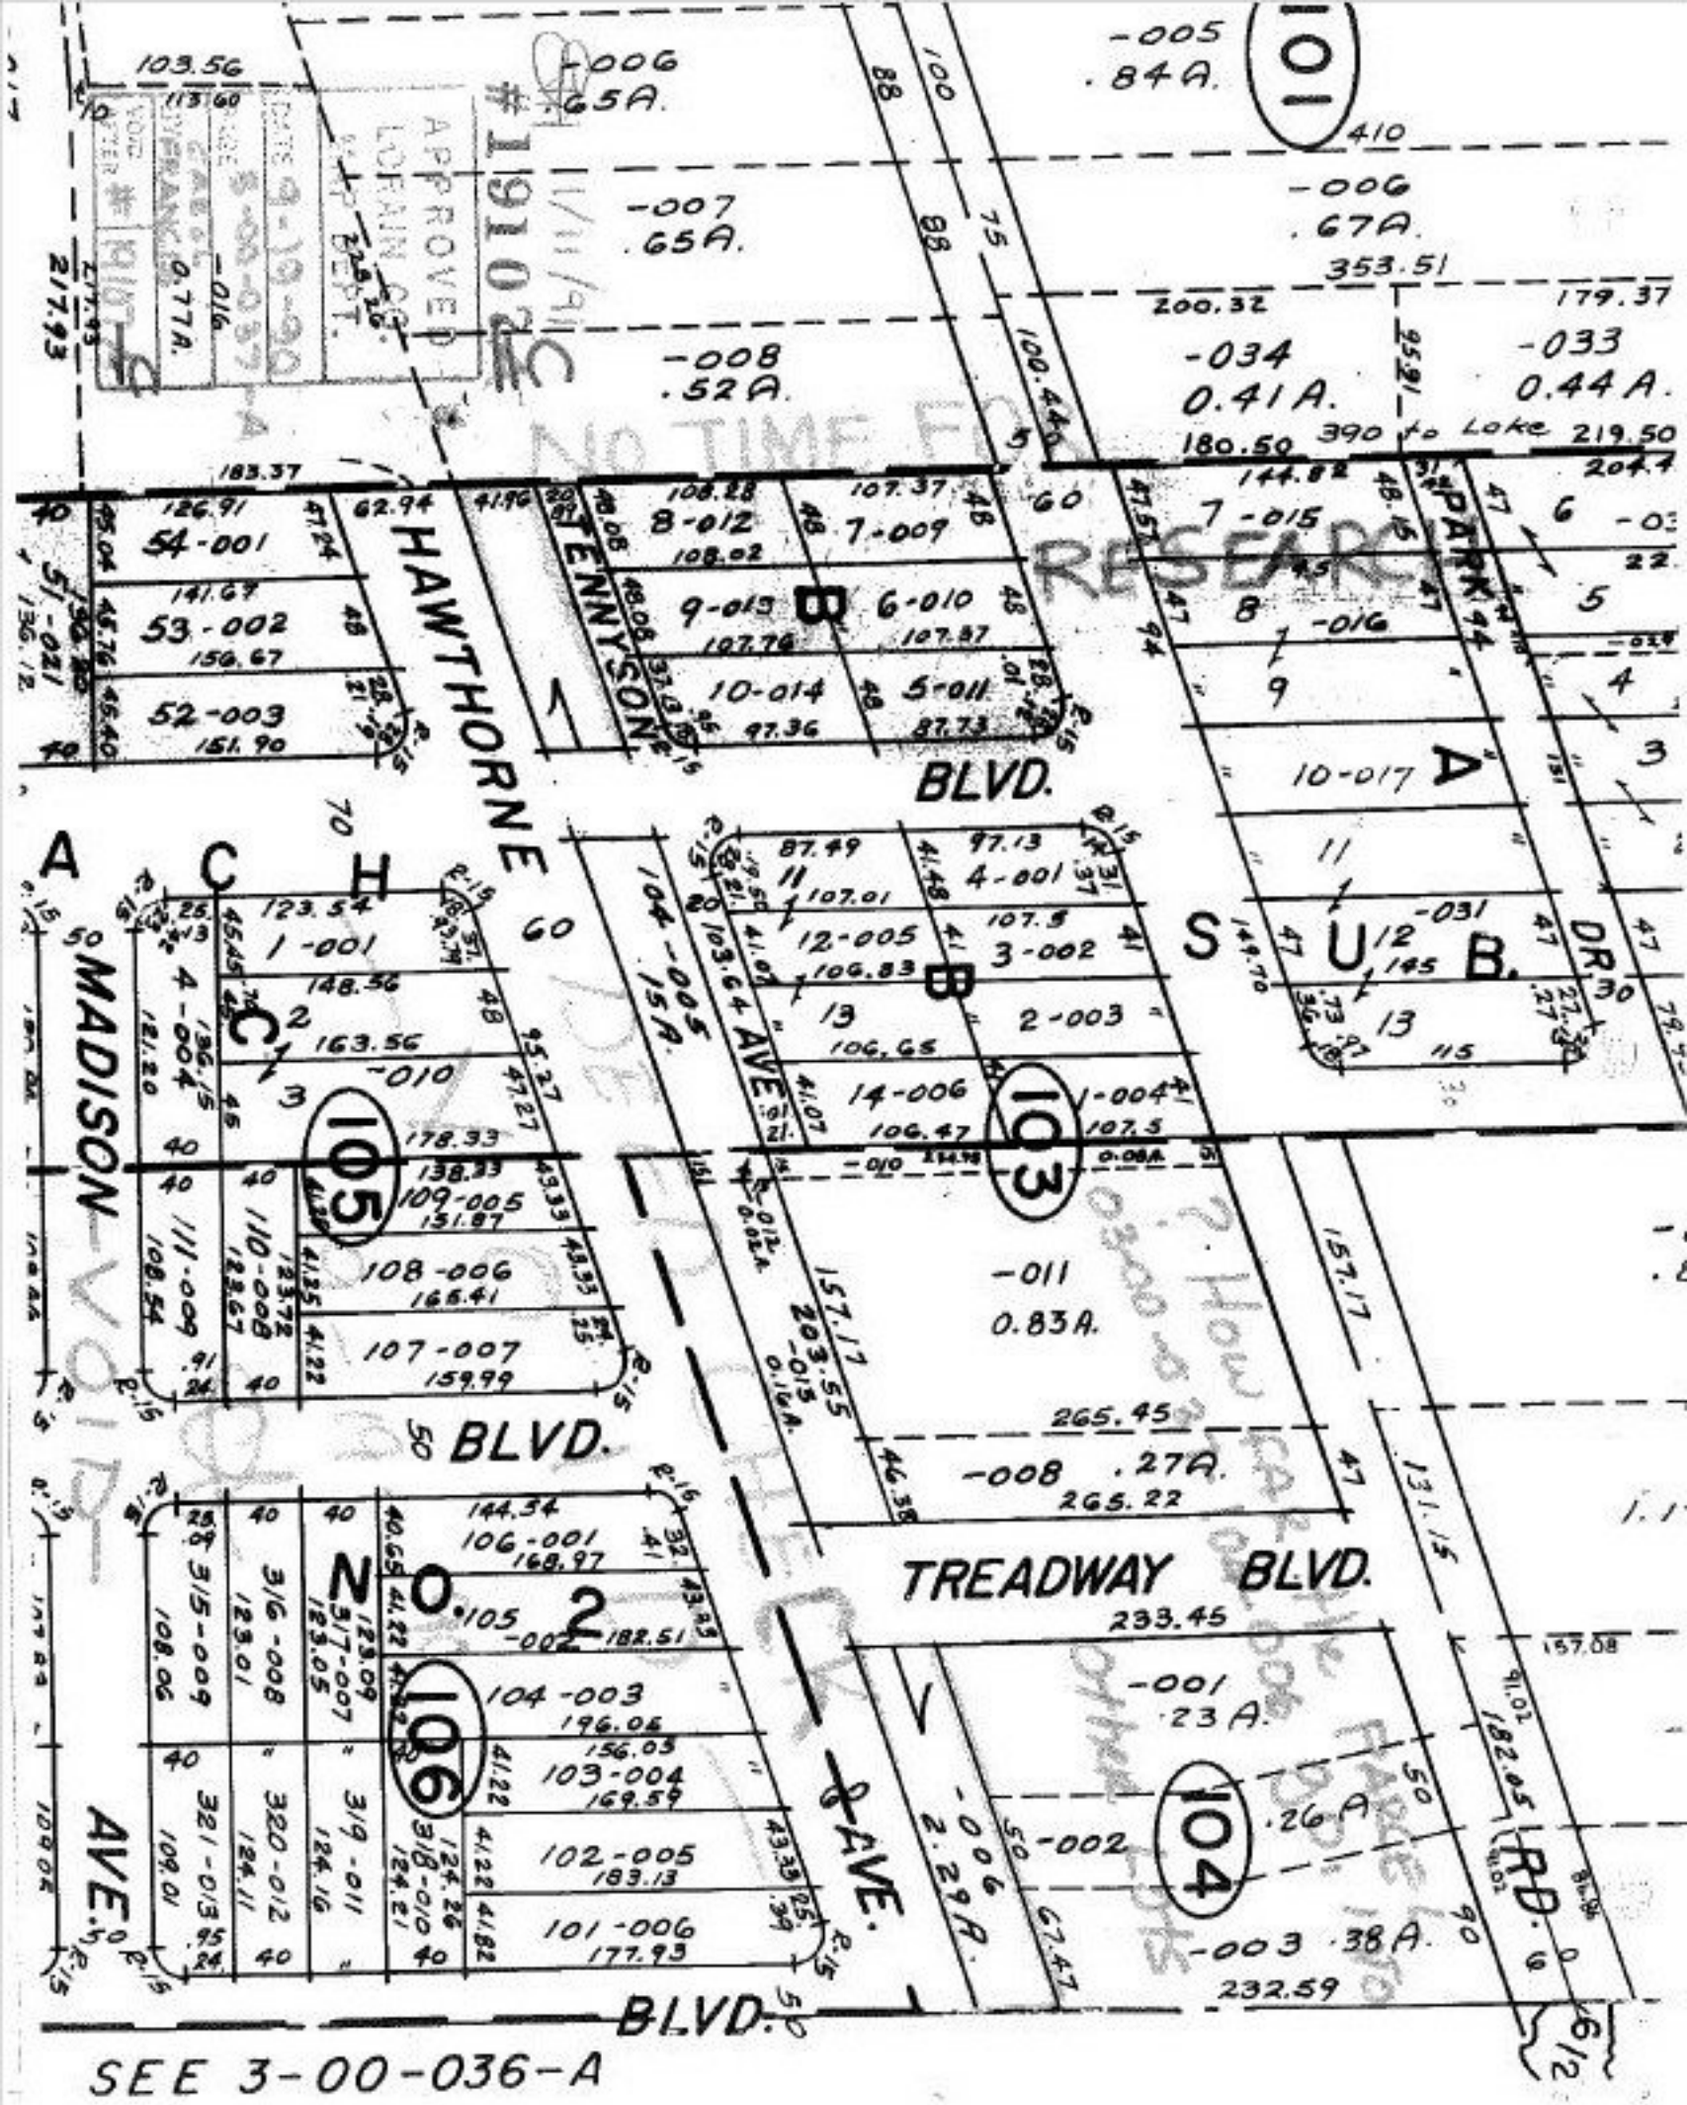

HAWTHORNE
TENNYSON
BLVD.
MADISON
AVE.
BLVD.
TREADWAY BLVD.
AVE.
BLVD.
PARK
DR.
RD.
SUB.
A
B
C
101
103
104
105
106
NO. 2
APPROVED
LORAIN CO.
MAP DEPT.
#19102
NO TIME FOR
RESEARCH

SEE 3-00-036-A