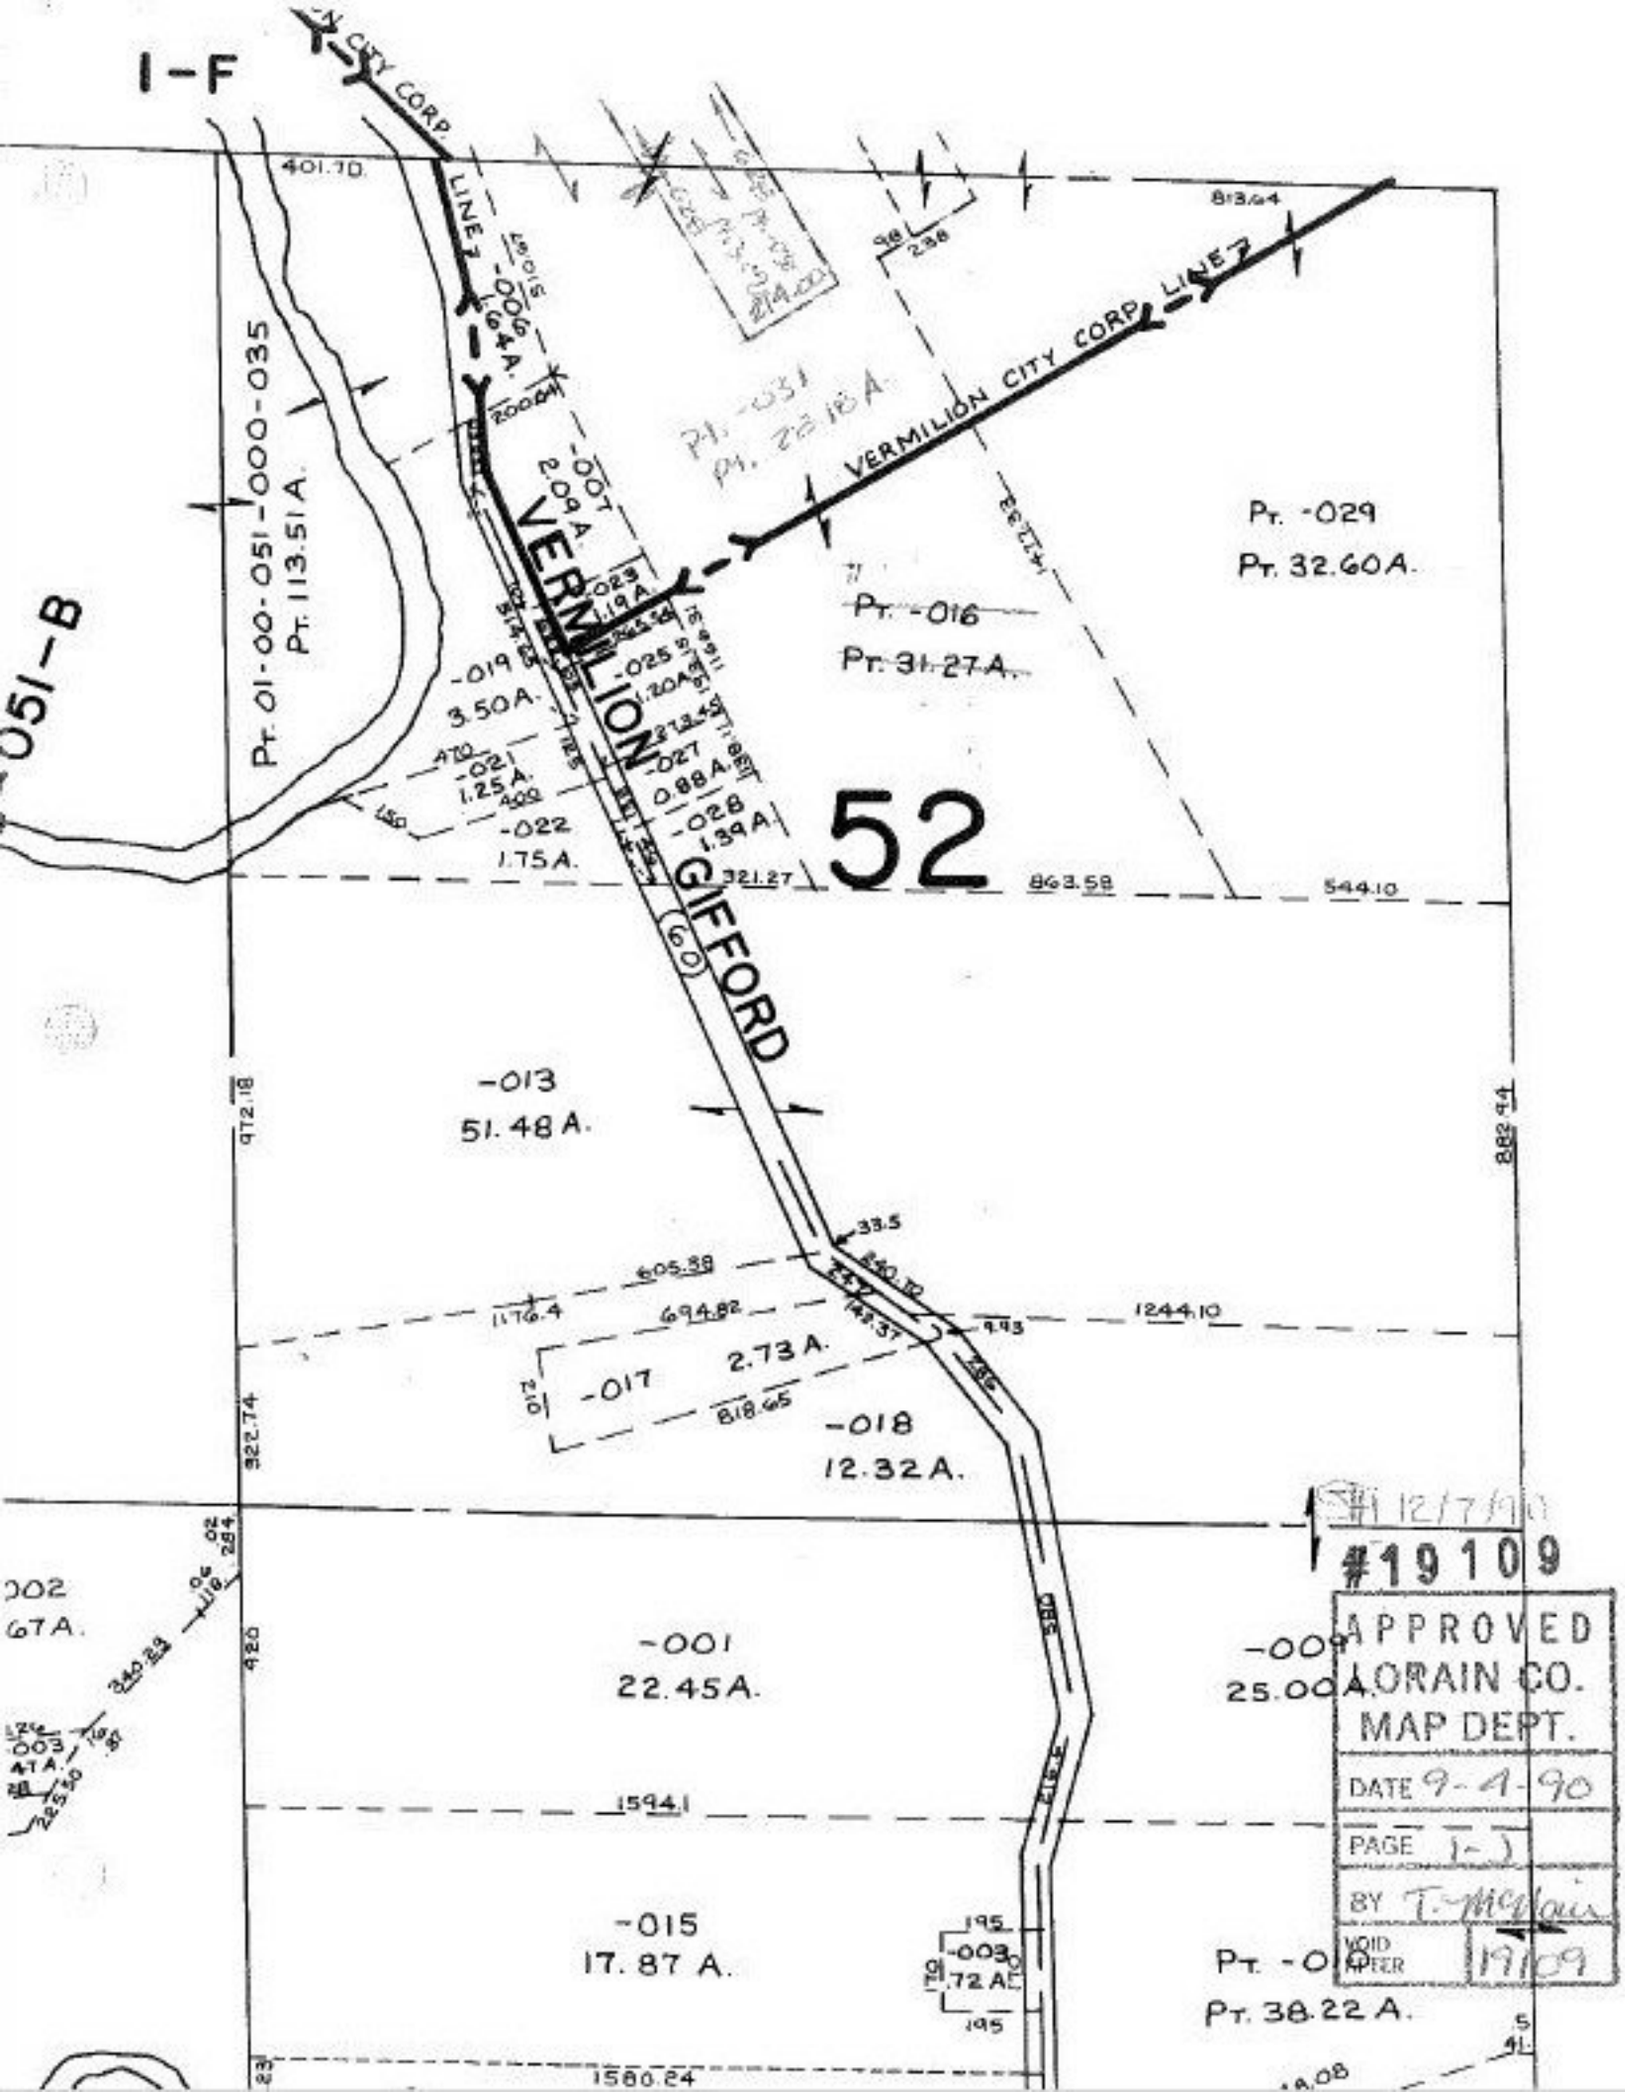
I-F
CITY CORP
LINE Z
401.70
818.64
VERMILION CITY CORP
LINE Z
VERMILION
GIFFORD
60
Pt. 01-00-051-000-035
Pt. 113.51 A.
051-B
Pt. -031
Pt. 22.18 A.
Pt. -029
Pt. 32.60 A.
Pt. -016
Pt. 31.27 A.
-019
3.50 A.
-021
1.25 A.
-022
1.75 A.
-023
1.19 A.
-025
1.20 A.
-027
0.88 A.
-028
1.39 A.
52
321.27
863.58
544.10
-013
51.48 A.
972.18
882.94
605.38
694.82
1176.4
1244.10
-017
2.73 A.
818.65
-018
12.32 A.
322.74
-001
22.45 A.
-009
25.00 A.
1594.1
-015
17.87 A.
-003
1.72 AC.
Pt. -01
Pt. 38.22 A.
1580.24
#1 12/7/90
#19109
APPROVED
LORAIN CO.
MAP DEPT.
DATE 9-4-90
PAGE 1-1
BY T. McClain
VOID PAPER 19109