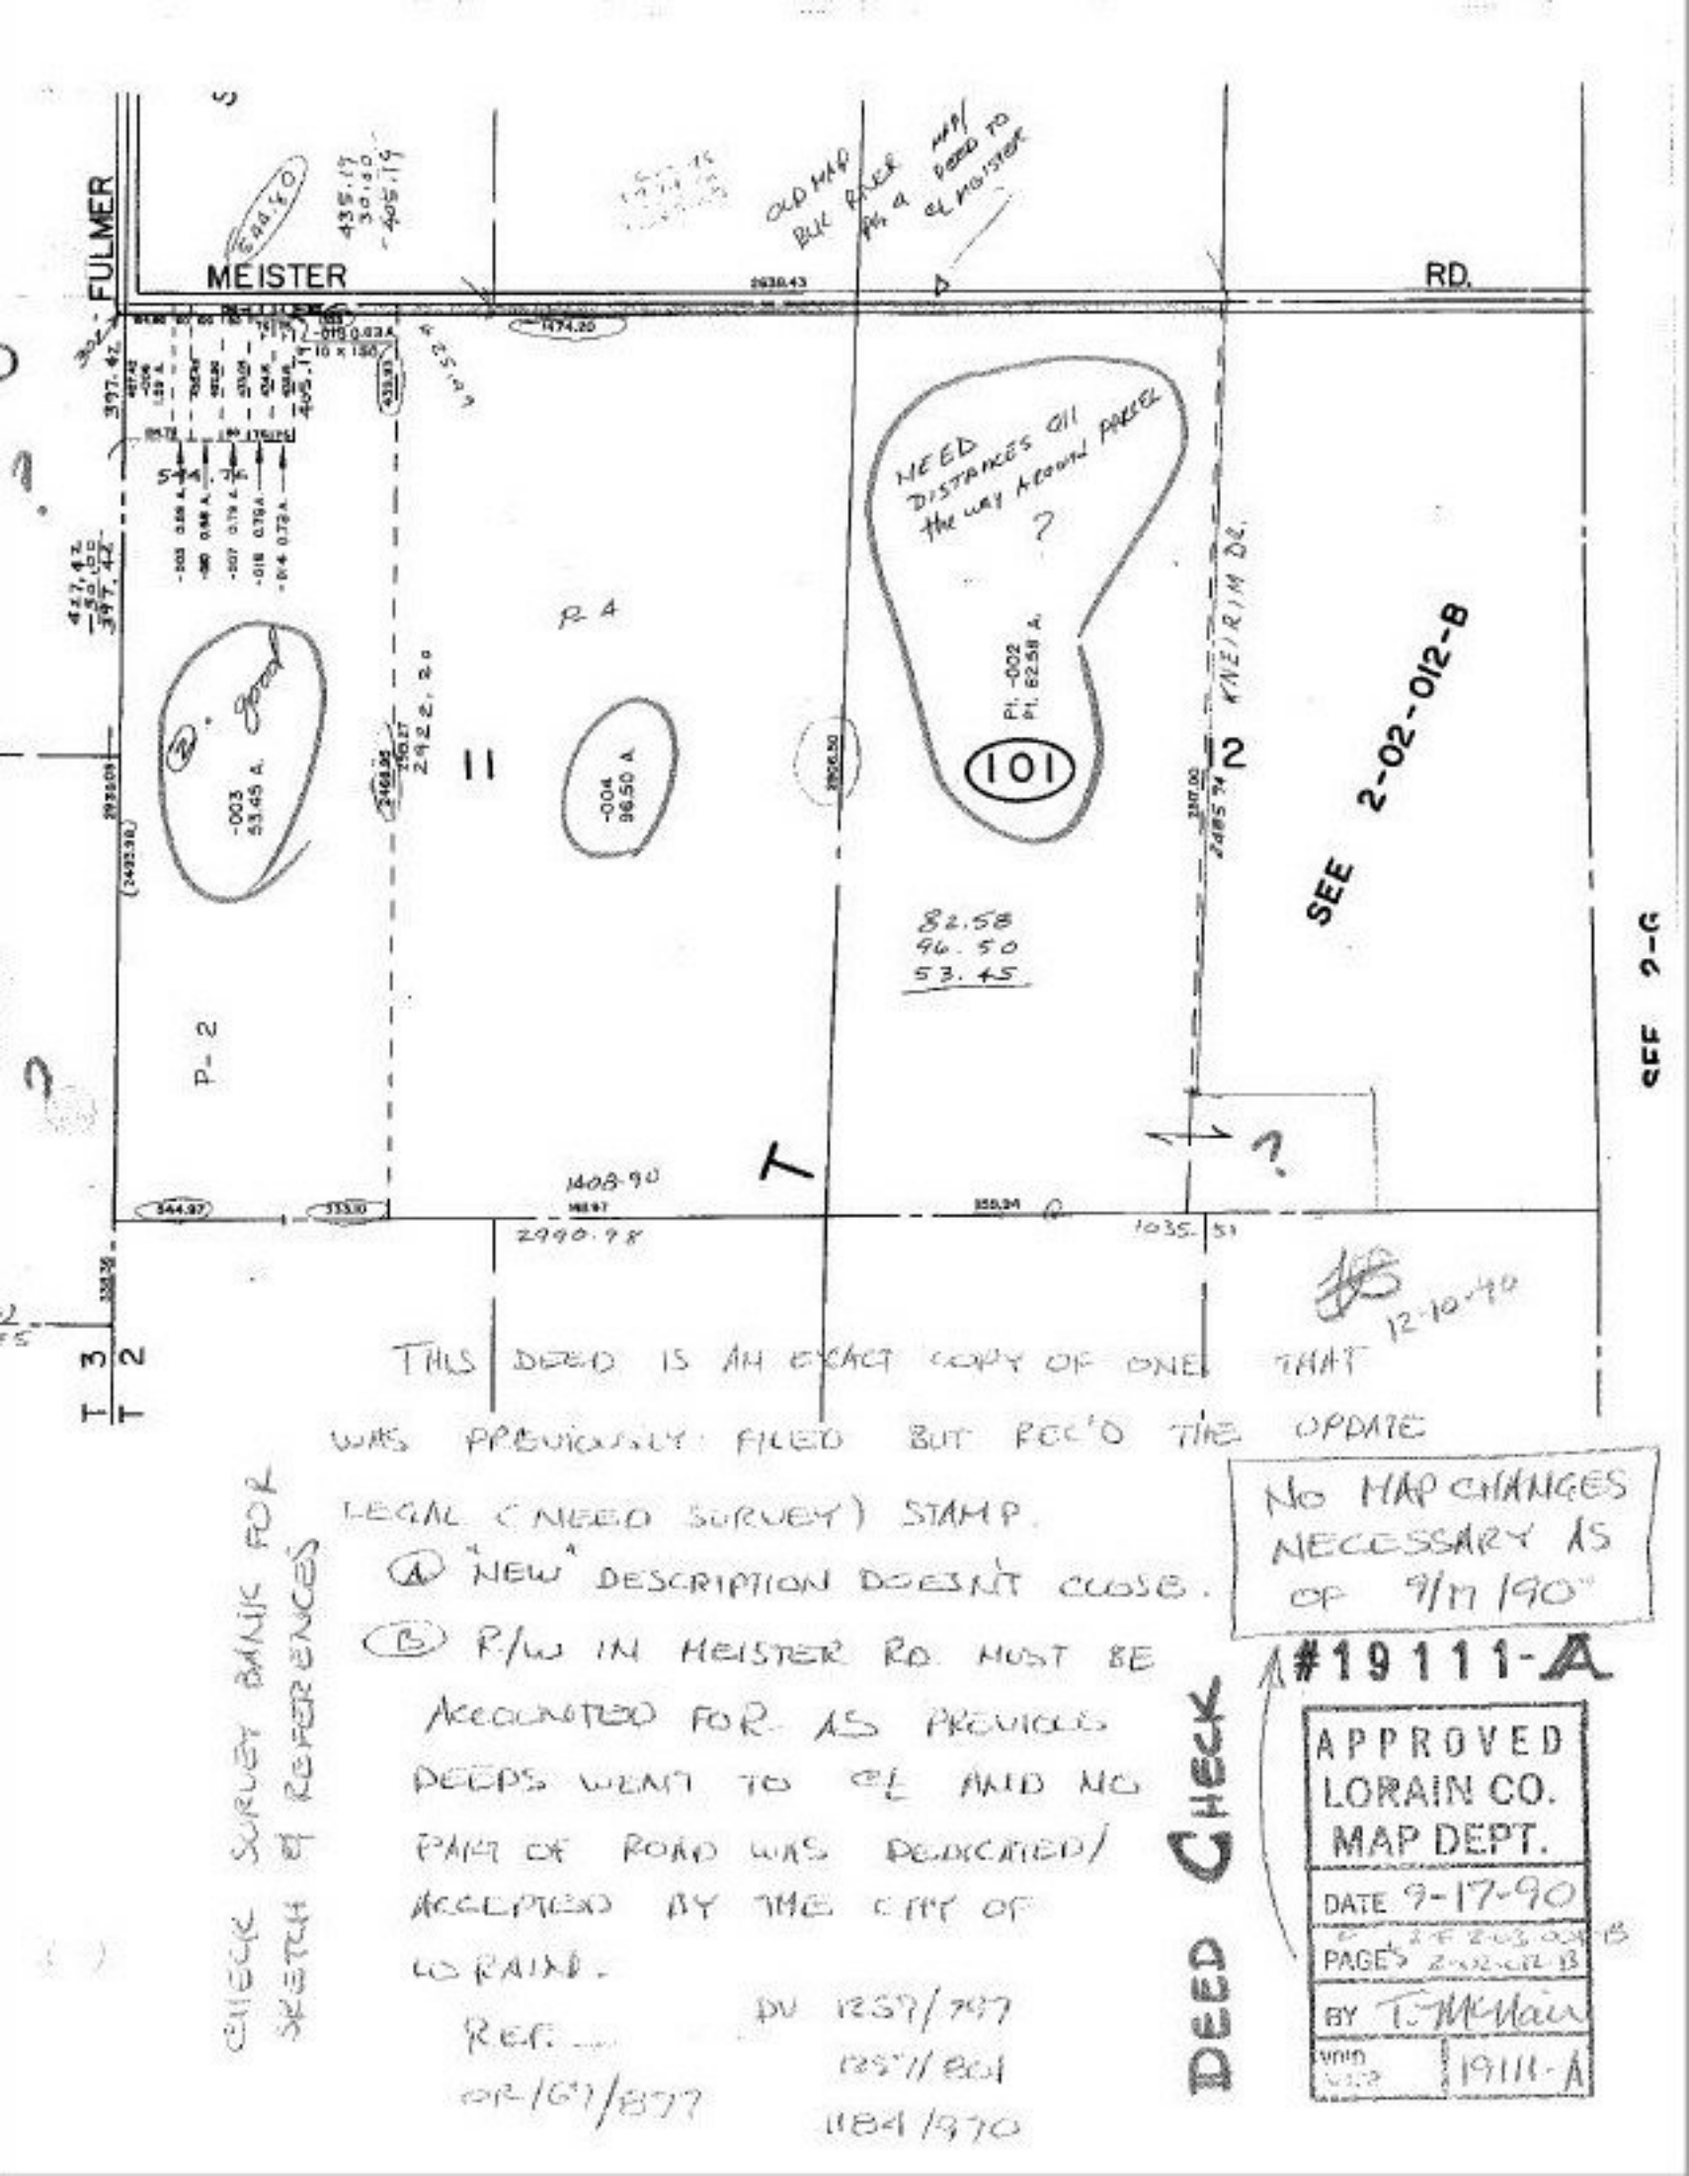


THIS DEED IS AN EXACT COPY OF ONE THAT WAS PREVIOUSLY FILED BUT REC'D THE UPDATE LEGAL (NEED SURVEY) STAMP.

12-10-90

(A) "NEW" DESCRIPTION DOESN'T CLOSE.

(B) R/W IN MEISTER RD. MUST BE ACCOUNTED FOR AS PREVIOUS DEEDS WENT TO ℄ AND NO PART OF ROAD WAS DEDICATED/ ACCEPTED BY THE CITY OF LORAIN.

REF.... DV 1257/797
1257/801
OR 1671/877
1184/970

CHECK SURVEY BANK FOR SKETCH OF REFERENCES

DEED CHECK

No MAP CHANGES NECESSARY AS OF 9/17/90"

#19111-A

APPROVED
LORAIN CO.
MAP DEPT.
DATE 9-17-90
PAGE 2-02-012-B
BY T. McClain
VOID 19111-A