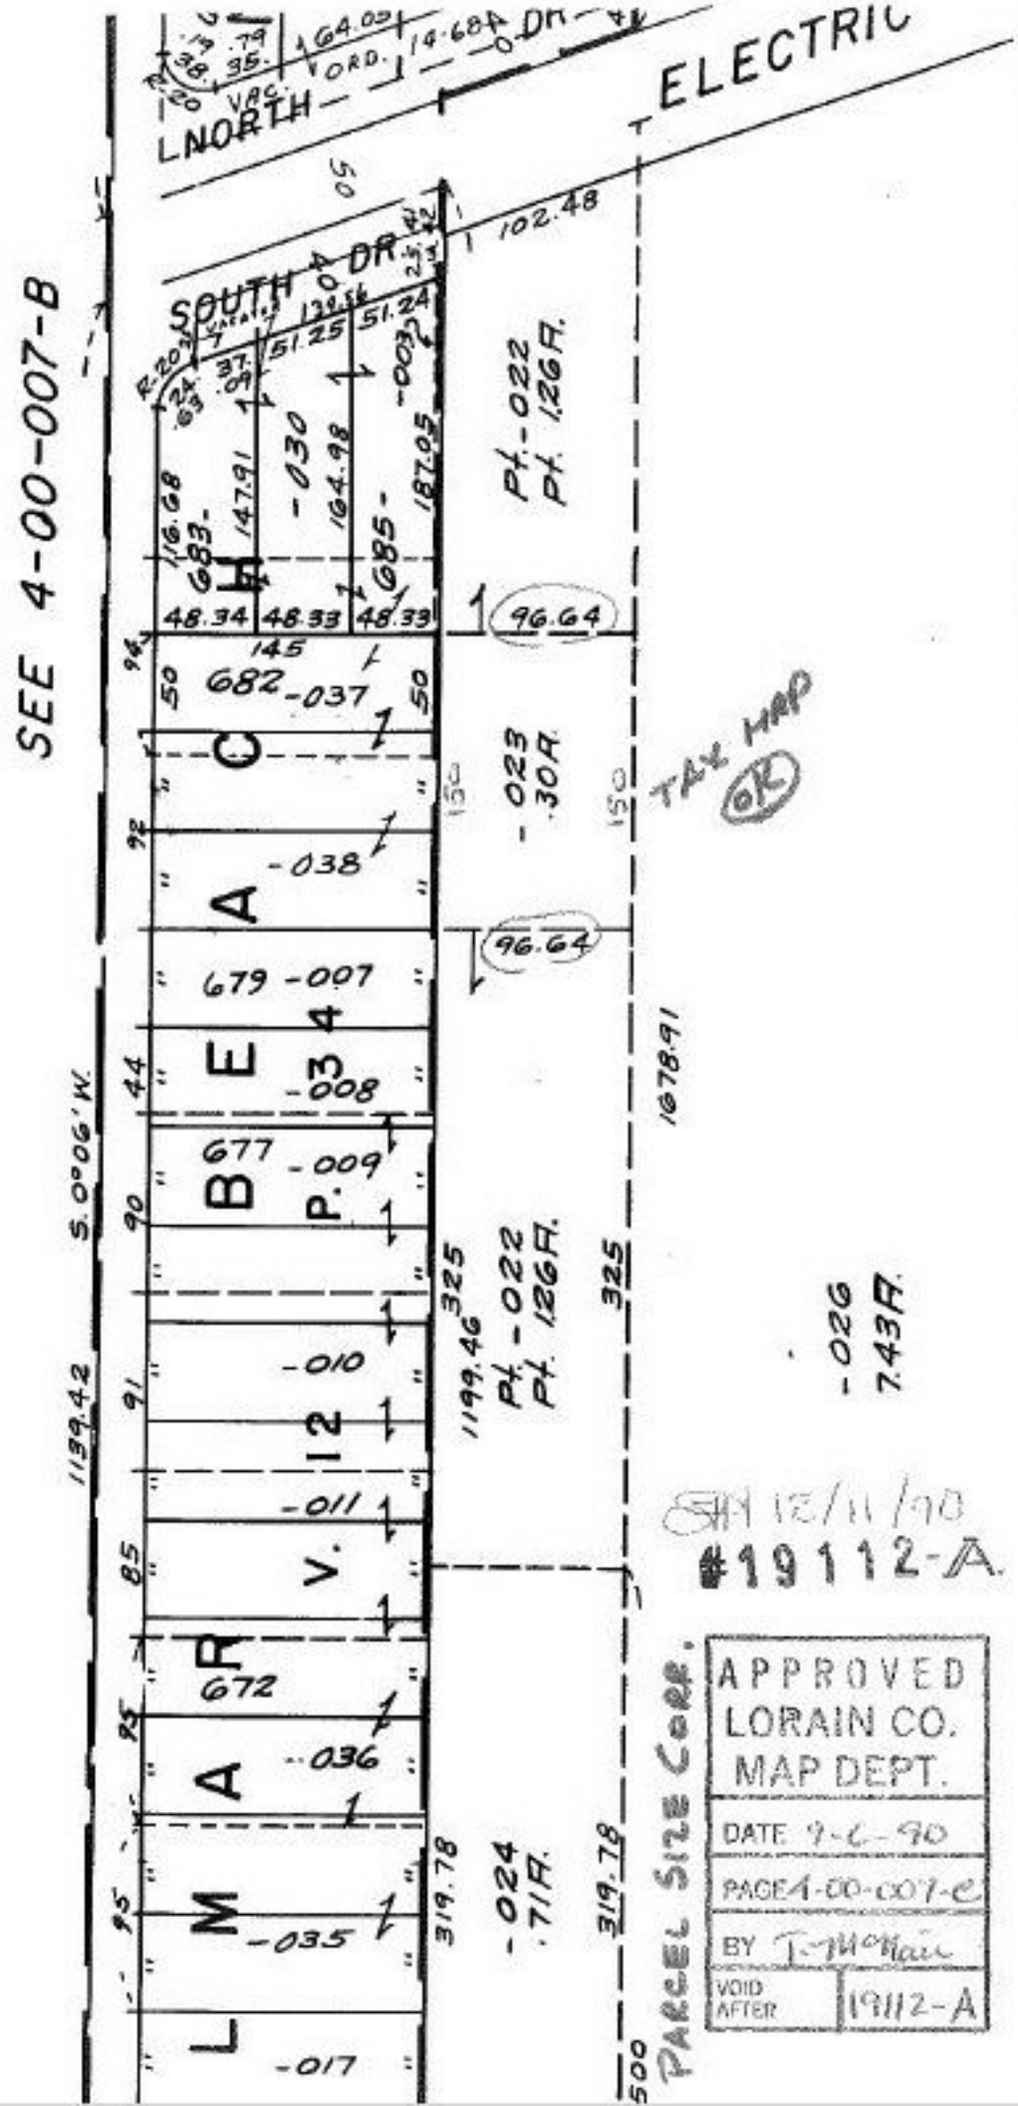

ELECTRIC
NORTH
SOUTH
SEE 4-00-007-B
LMARV. 12 P. 34 BEACH
Pt. -022
Pt. 1.26A.
-023
.30A.
-024
.71A.
-026
7.43A.
TAX MAP
OK
PARCEL SIZE CORR.
#19112-A.
APPROVED
LORAIN CO.
MAP DEPT.
DATE 9-6-90
PAGE 4-00-007-C
BY T. McNair
VOID AFTER 19112-A