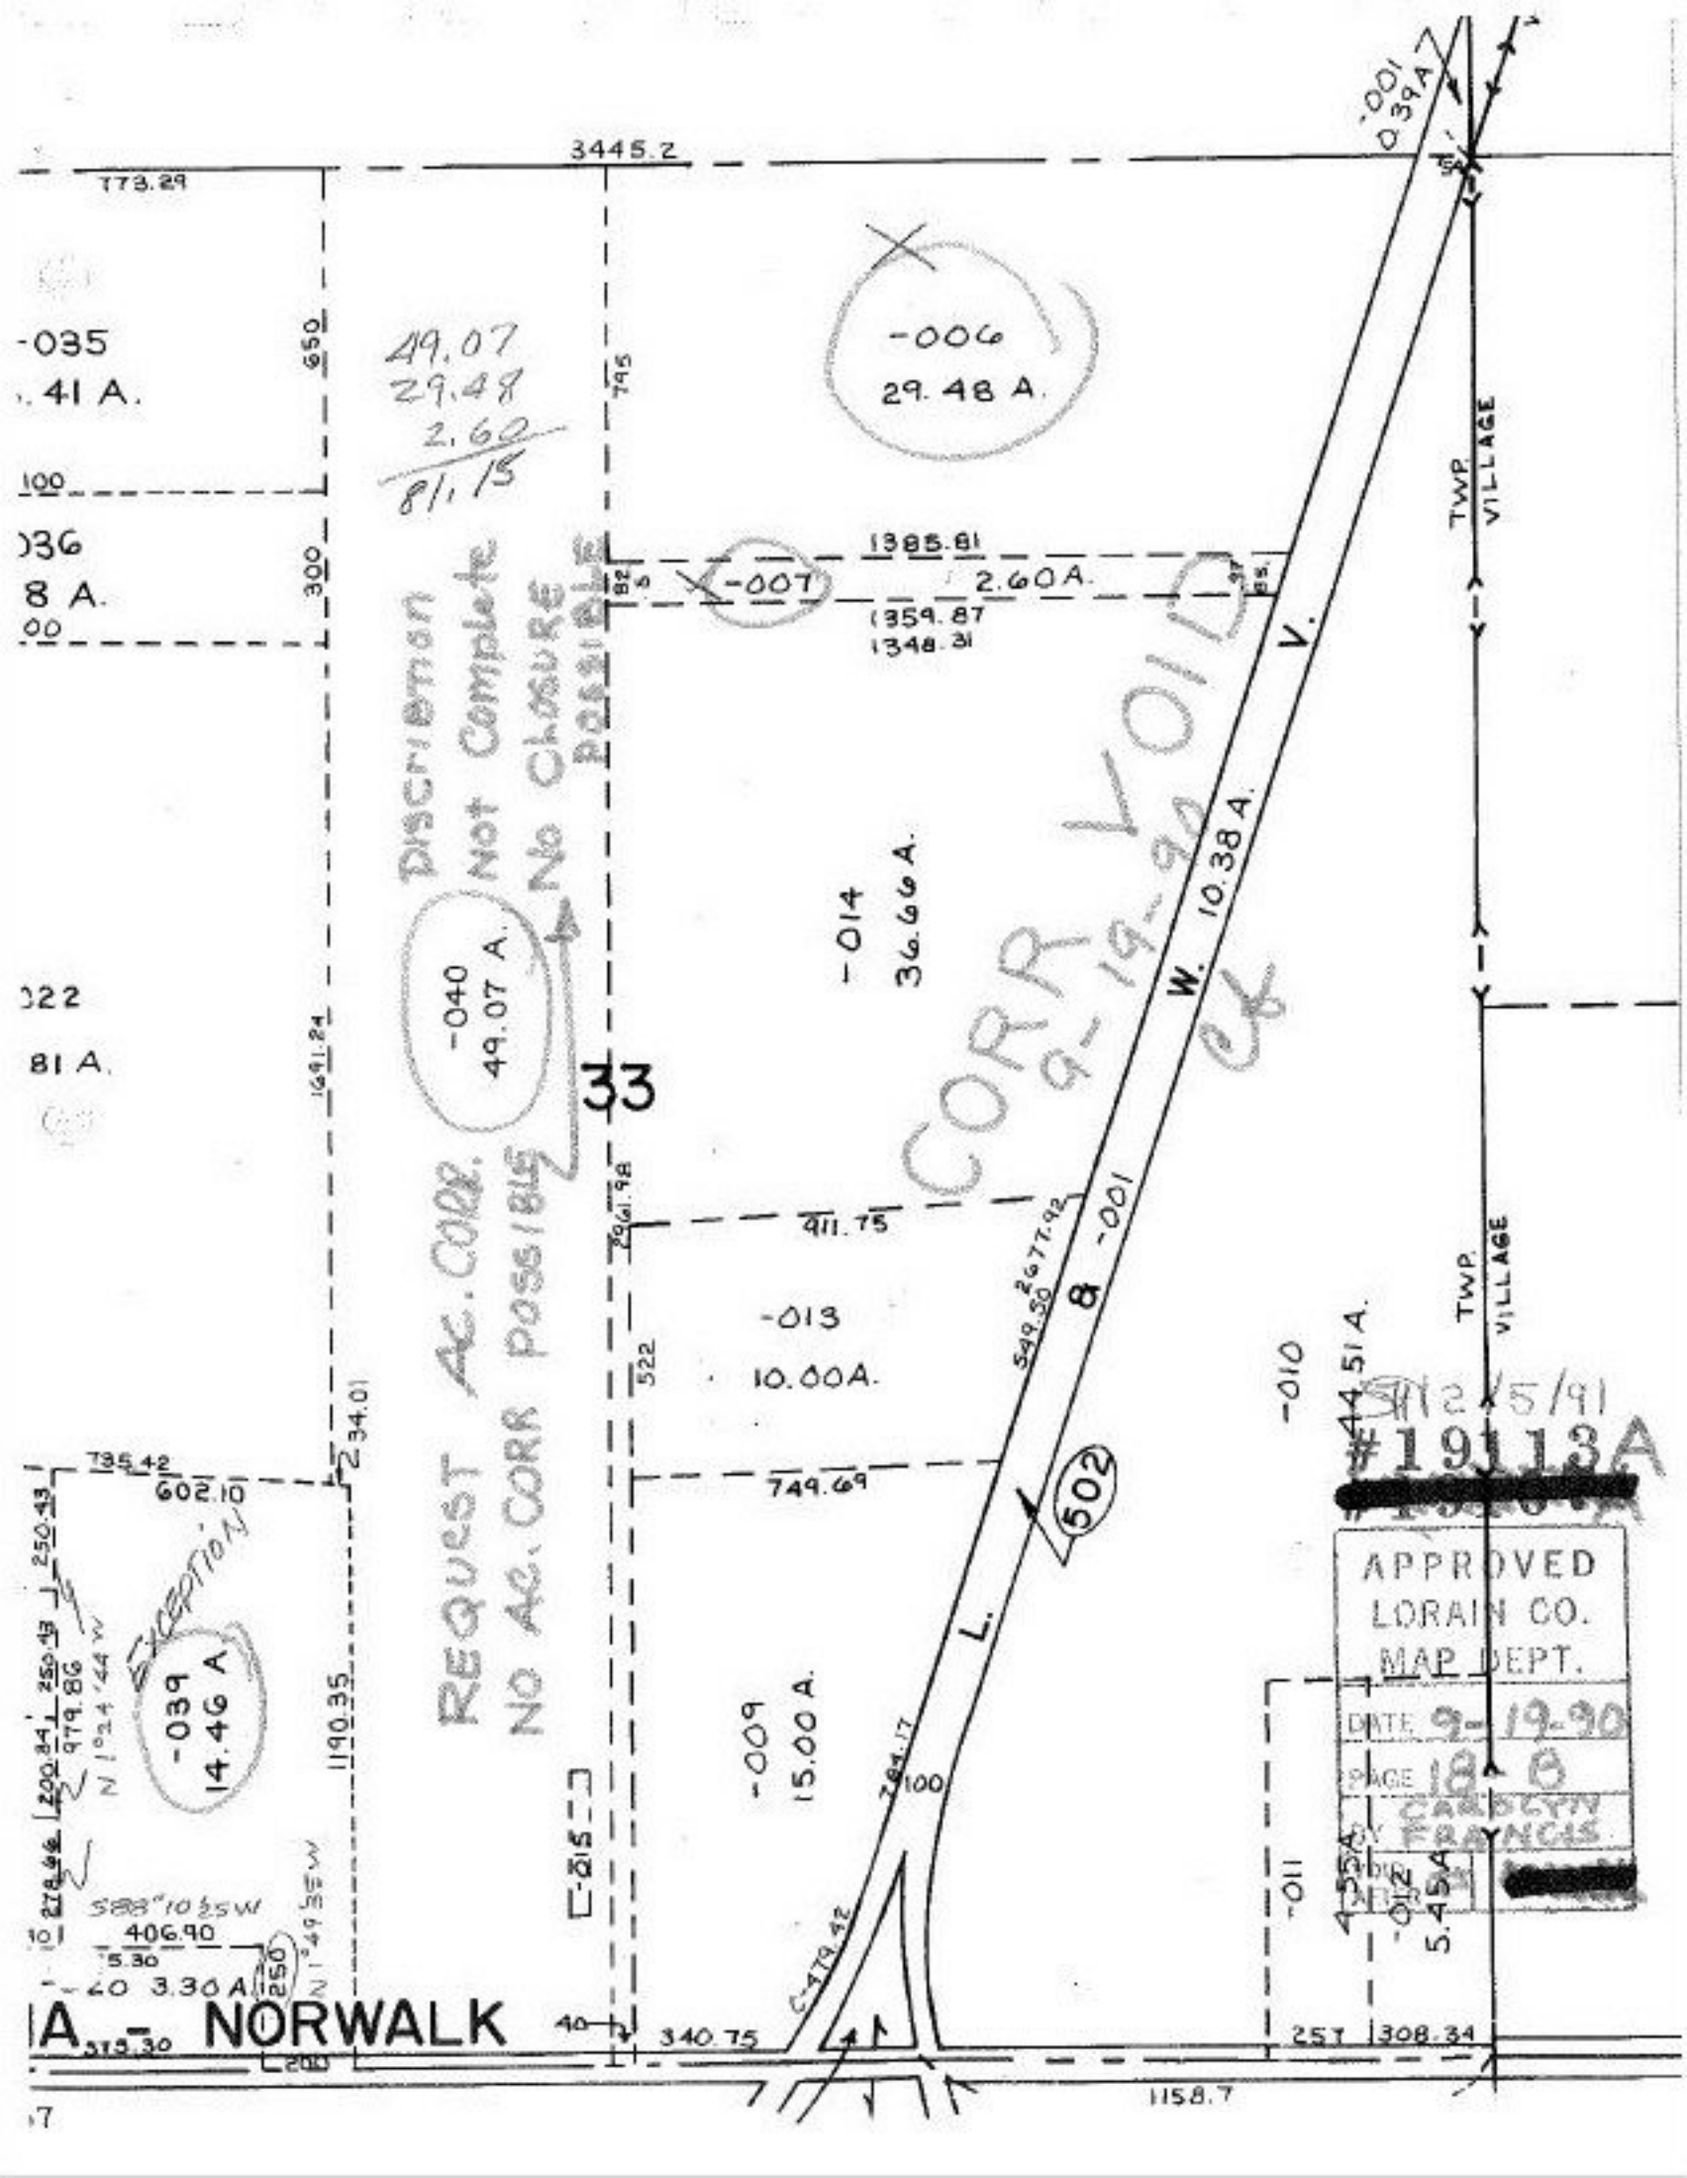

#19113A

APPROVED
LORAIN CO.
MAP DEPT.
DATE 9-19-90
PAGE 18-B
BY CAROLYN FRANCIS