SEE 4-L

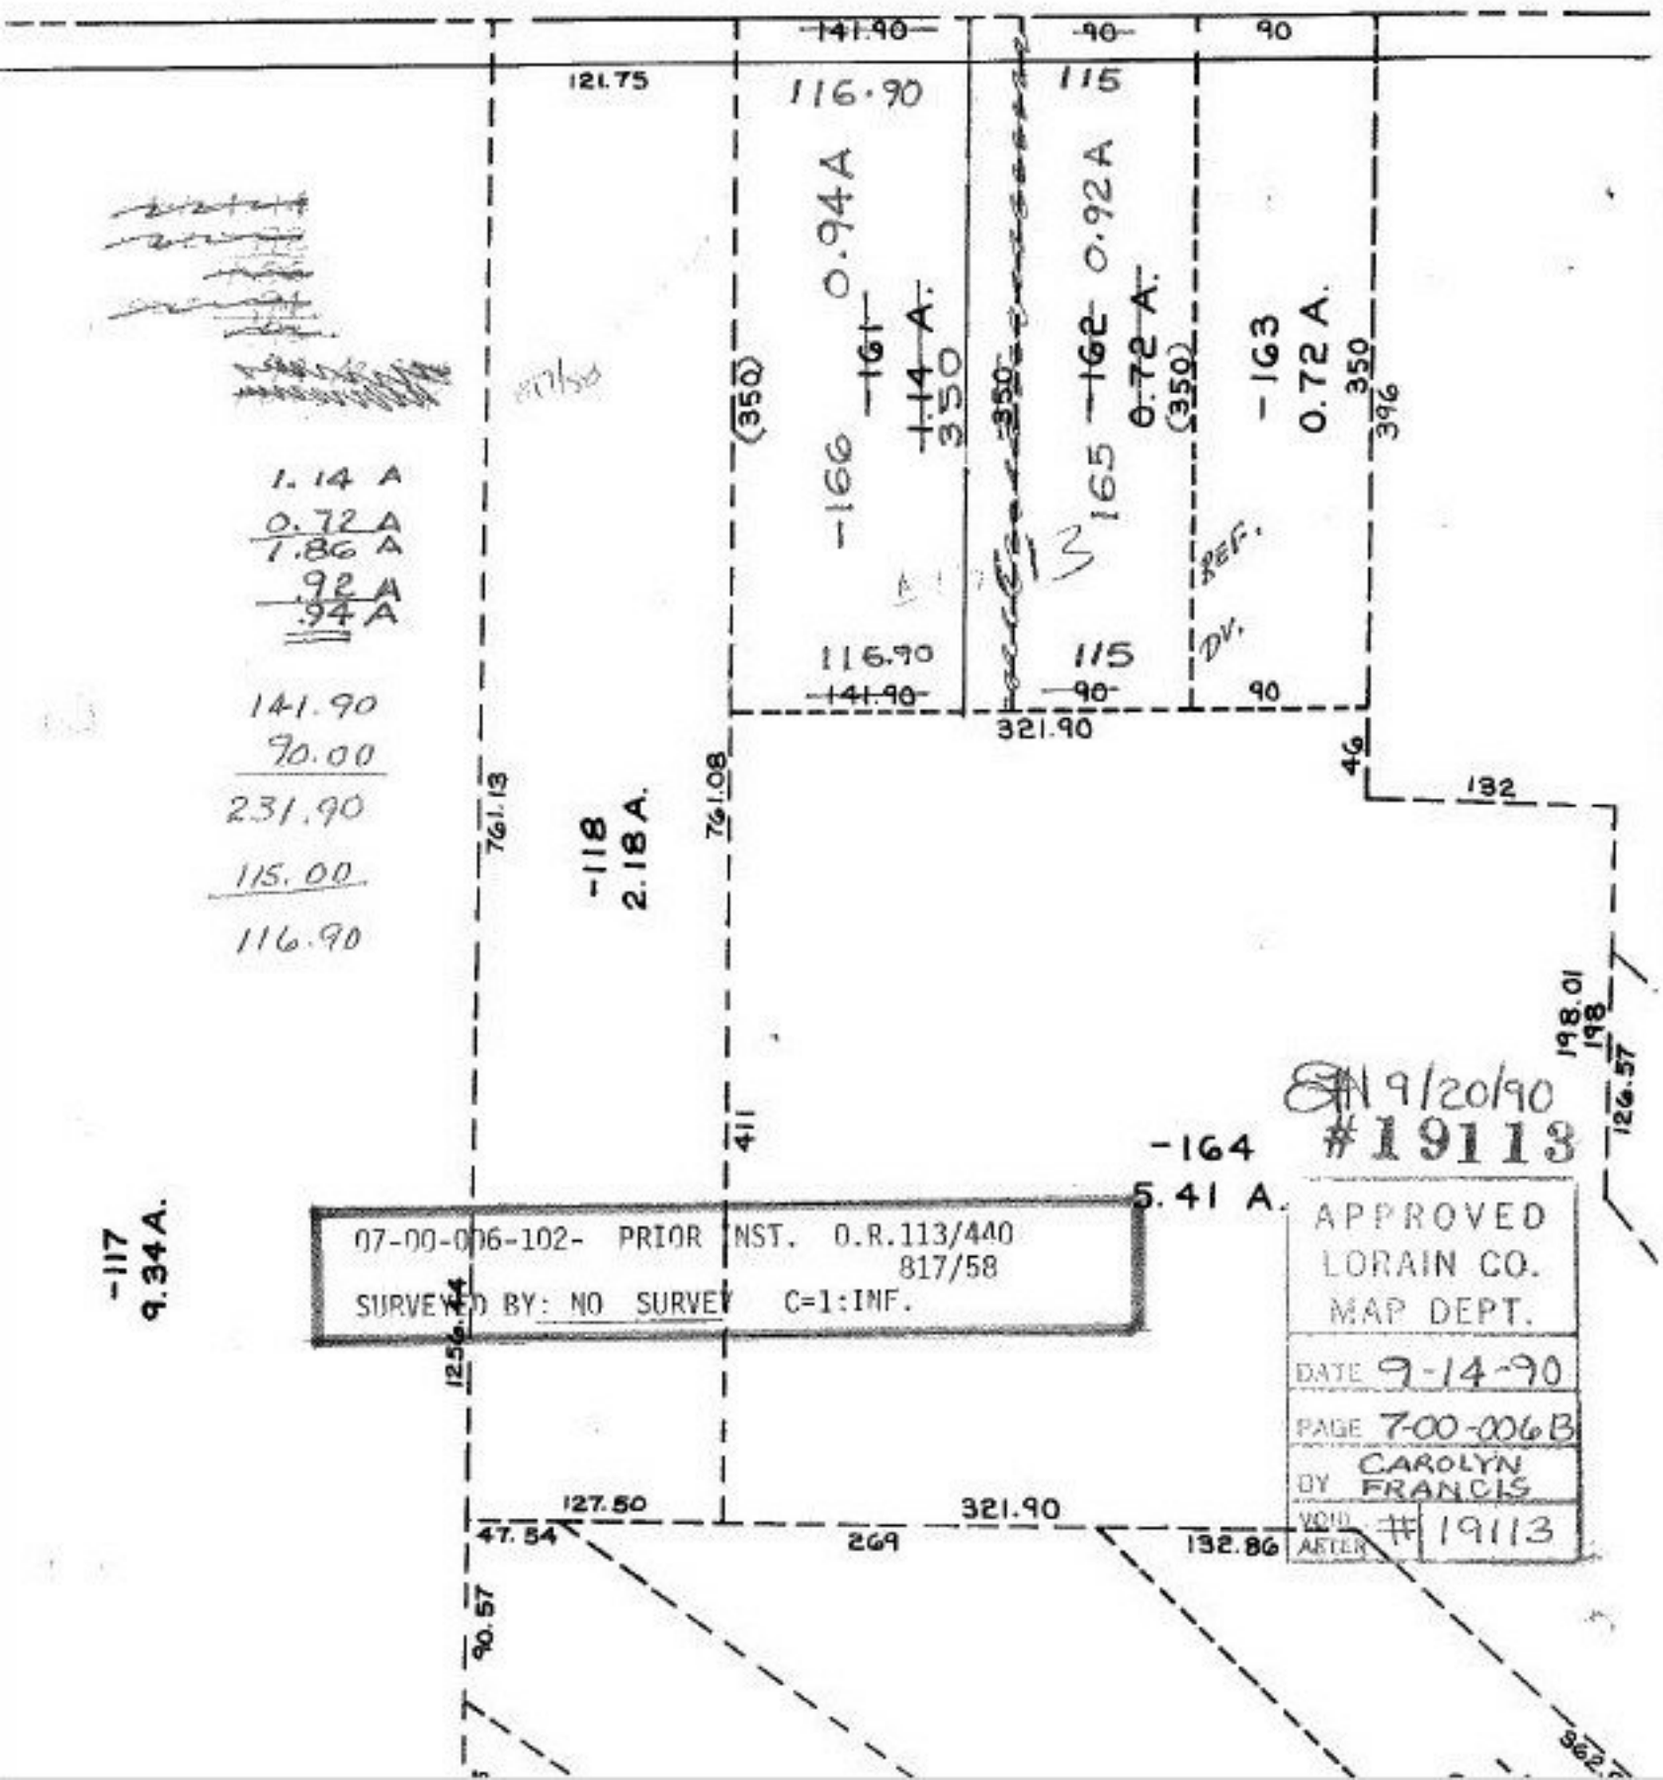
141.90
90
90
121.75
116.90
115
0.94A
0.92A
-166
-161
1.14 A.
350
-165
-162
0.72 A.
(350)
-163
0.72 A.
350
396
1.14 A
0.72 A
1.86 A
.92 A
.94 A
141.90
90.00
231.90
115.00
116.90
116.90
141.90
115
90
90
321.90
761.13
761.08
-118
2.18 A.
46
132
198.01
198
126.57
411
-164
5.41 A.
-117
9.34 A.
07-00-006-102- PRIOR INST. O.R.113/440
817/58
SURVEYED BY: NO SURVEY C=1:INF.
125.44
127.50
47.54
269
321.90
132.86
90.57
APPROVED
LORAIN CO.
MAP DEPT.
DATE 9-14-90
PAGE 7-00-006B
BY CAROLYN FRANCIS
VOID AFTER # 19113
9/20/90
#19113