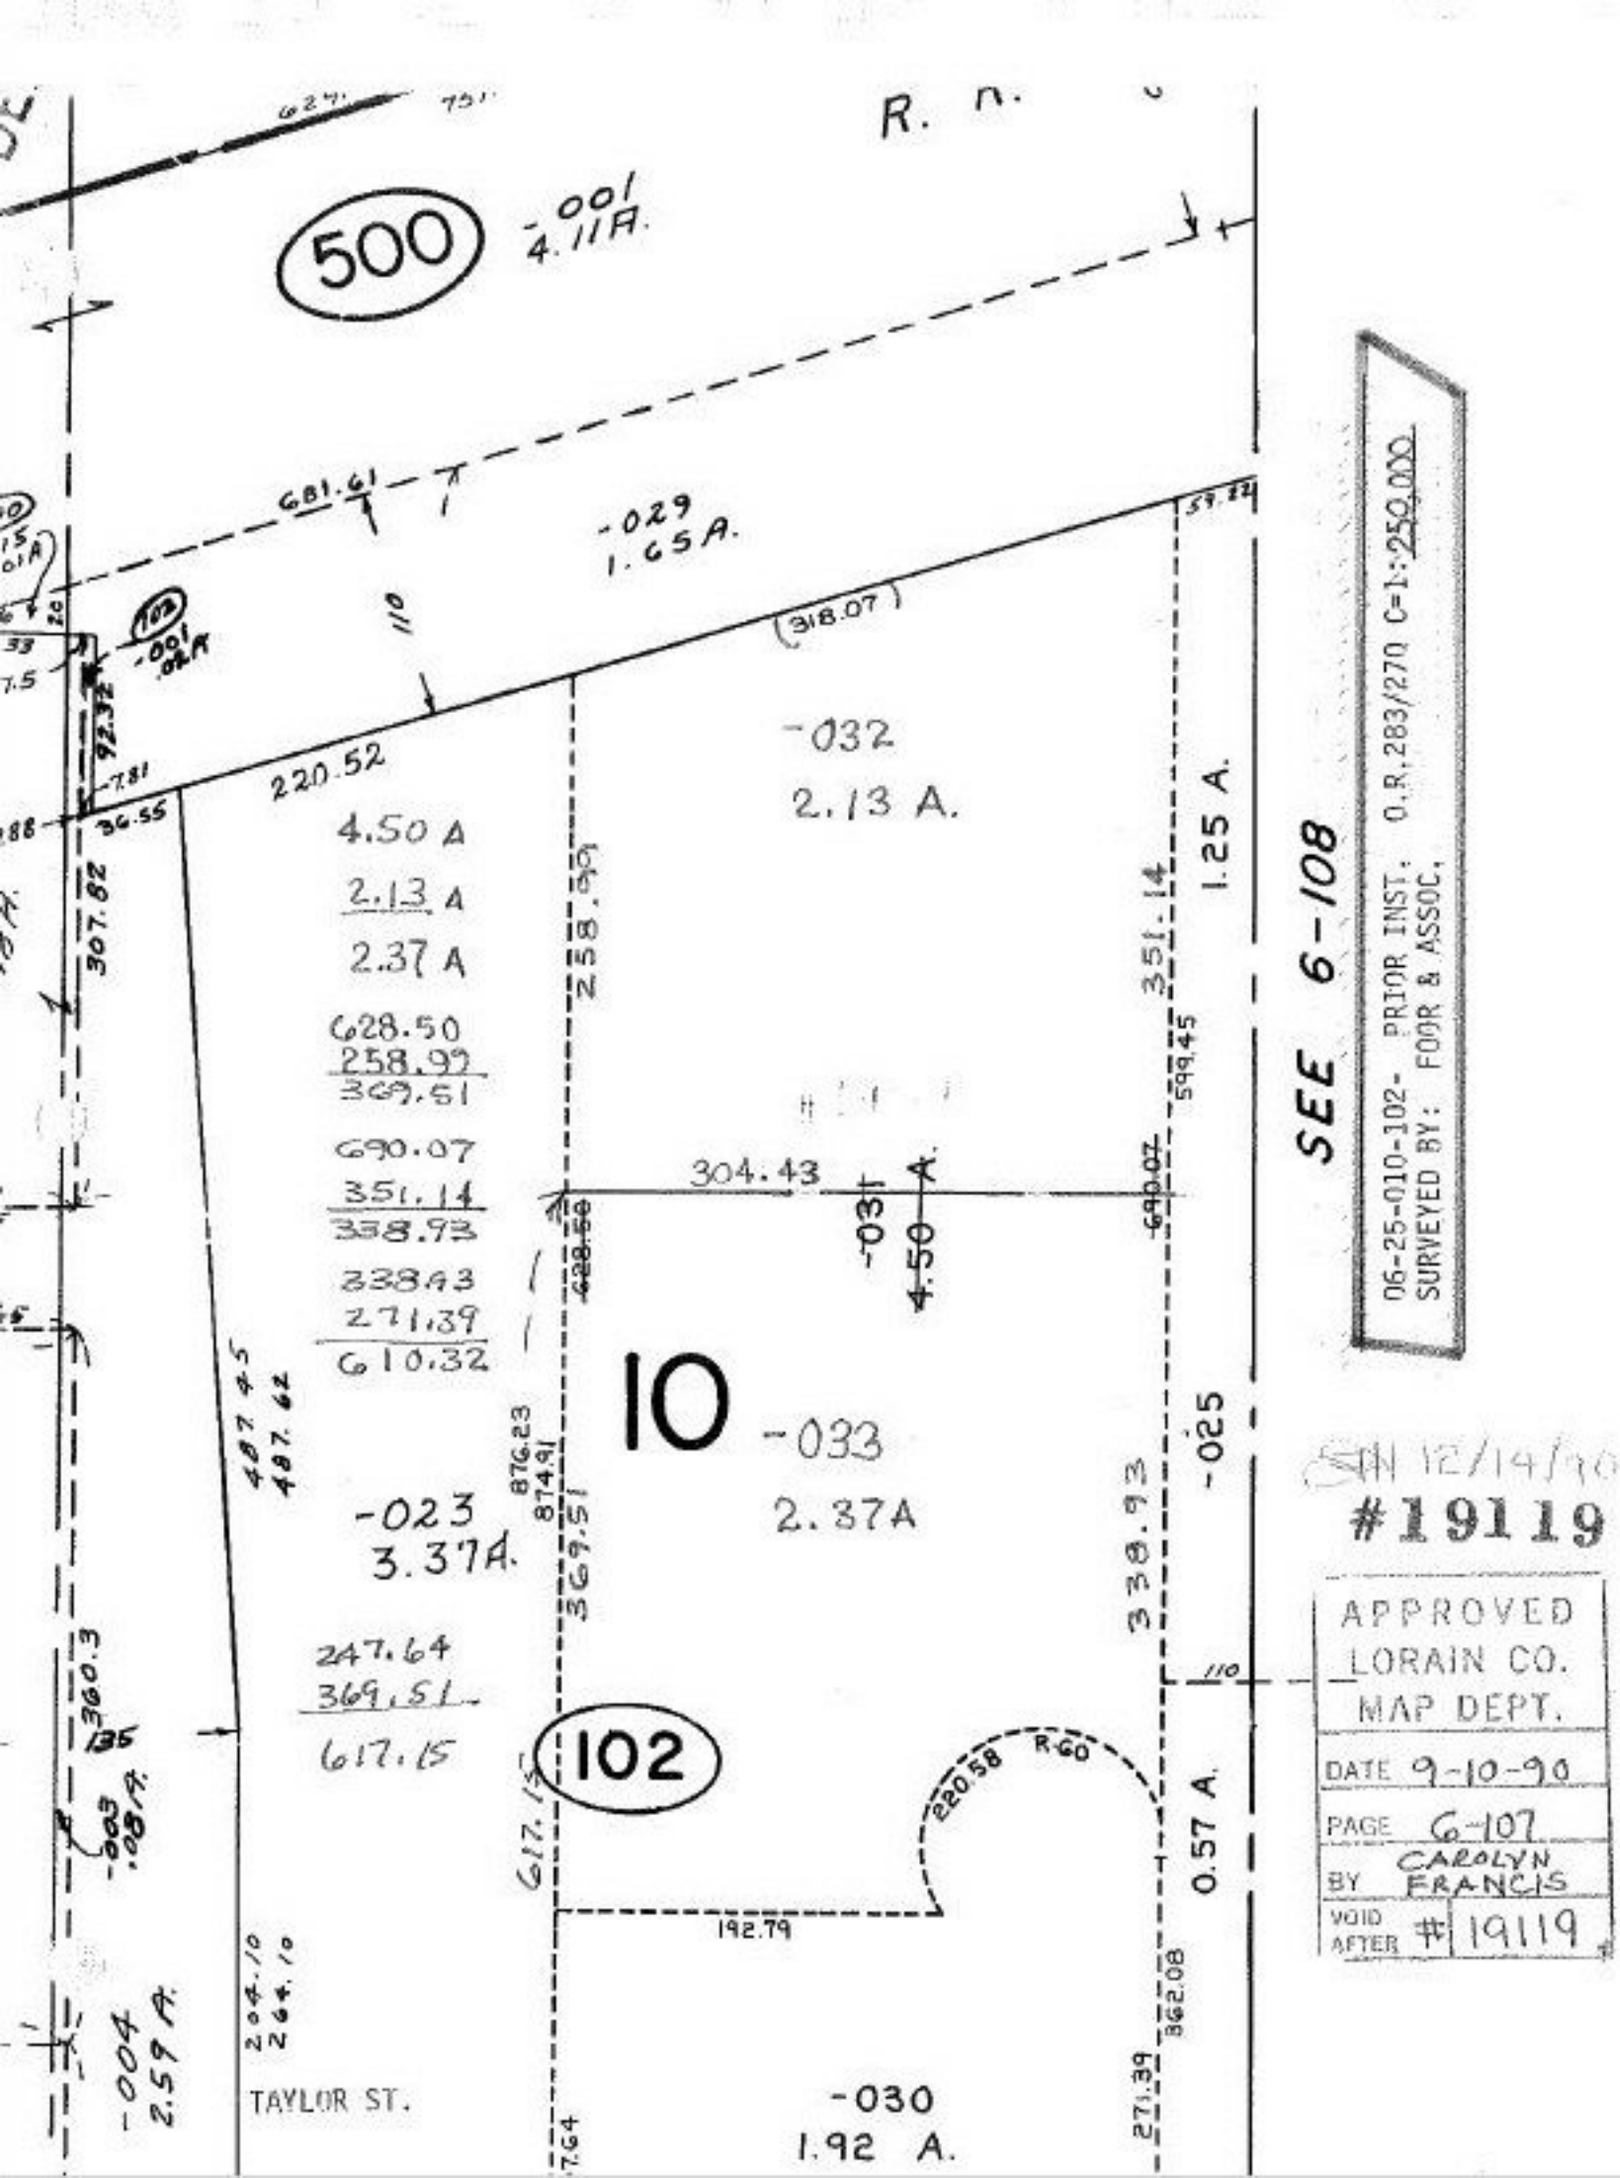

R. R.
500
-001
4.11A.
681.61
-029
1.65A.
(318.07)
220.52
-032
2.13 A.
4.50 A
2.13 A
2.37 A
628.50
258.99
369.51
690.07
351.14
338.93
338.93
271.39
610.32
258.99
351.14
1.25 A.
599.45
304.43
-031
4.50 A.
690.07
628.50
10
-033
2.37A
-023
3.37A.
876.23
874.91
369.51
338.93
-025
247.64
369.51
617.15
102
617.15
220.58
R-60
192.79
0.57 A.
362.08
271.39
204.10
264.10
TAYLOR ST.
-030
1.92 A.
-004
2.59 A.
307.82
92.32
36.55
7.81
487.45
487.62
360.3
135
-003
.08A.
SEE 6-108
06-25-010-102- PRIOR INST. O.R.283/270 C=1:250,000
SURVEYED BY: FOOR & ASSOC.
SIN 12/14/90
#19119
APPROVED
LORAIN CO.
MAP DEPT.
DATE 9-10-90
PAGE 6-107
BY CAROLYN FRANCIS
VOID AFTER # 19119