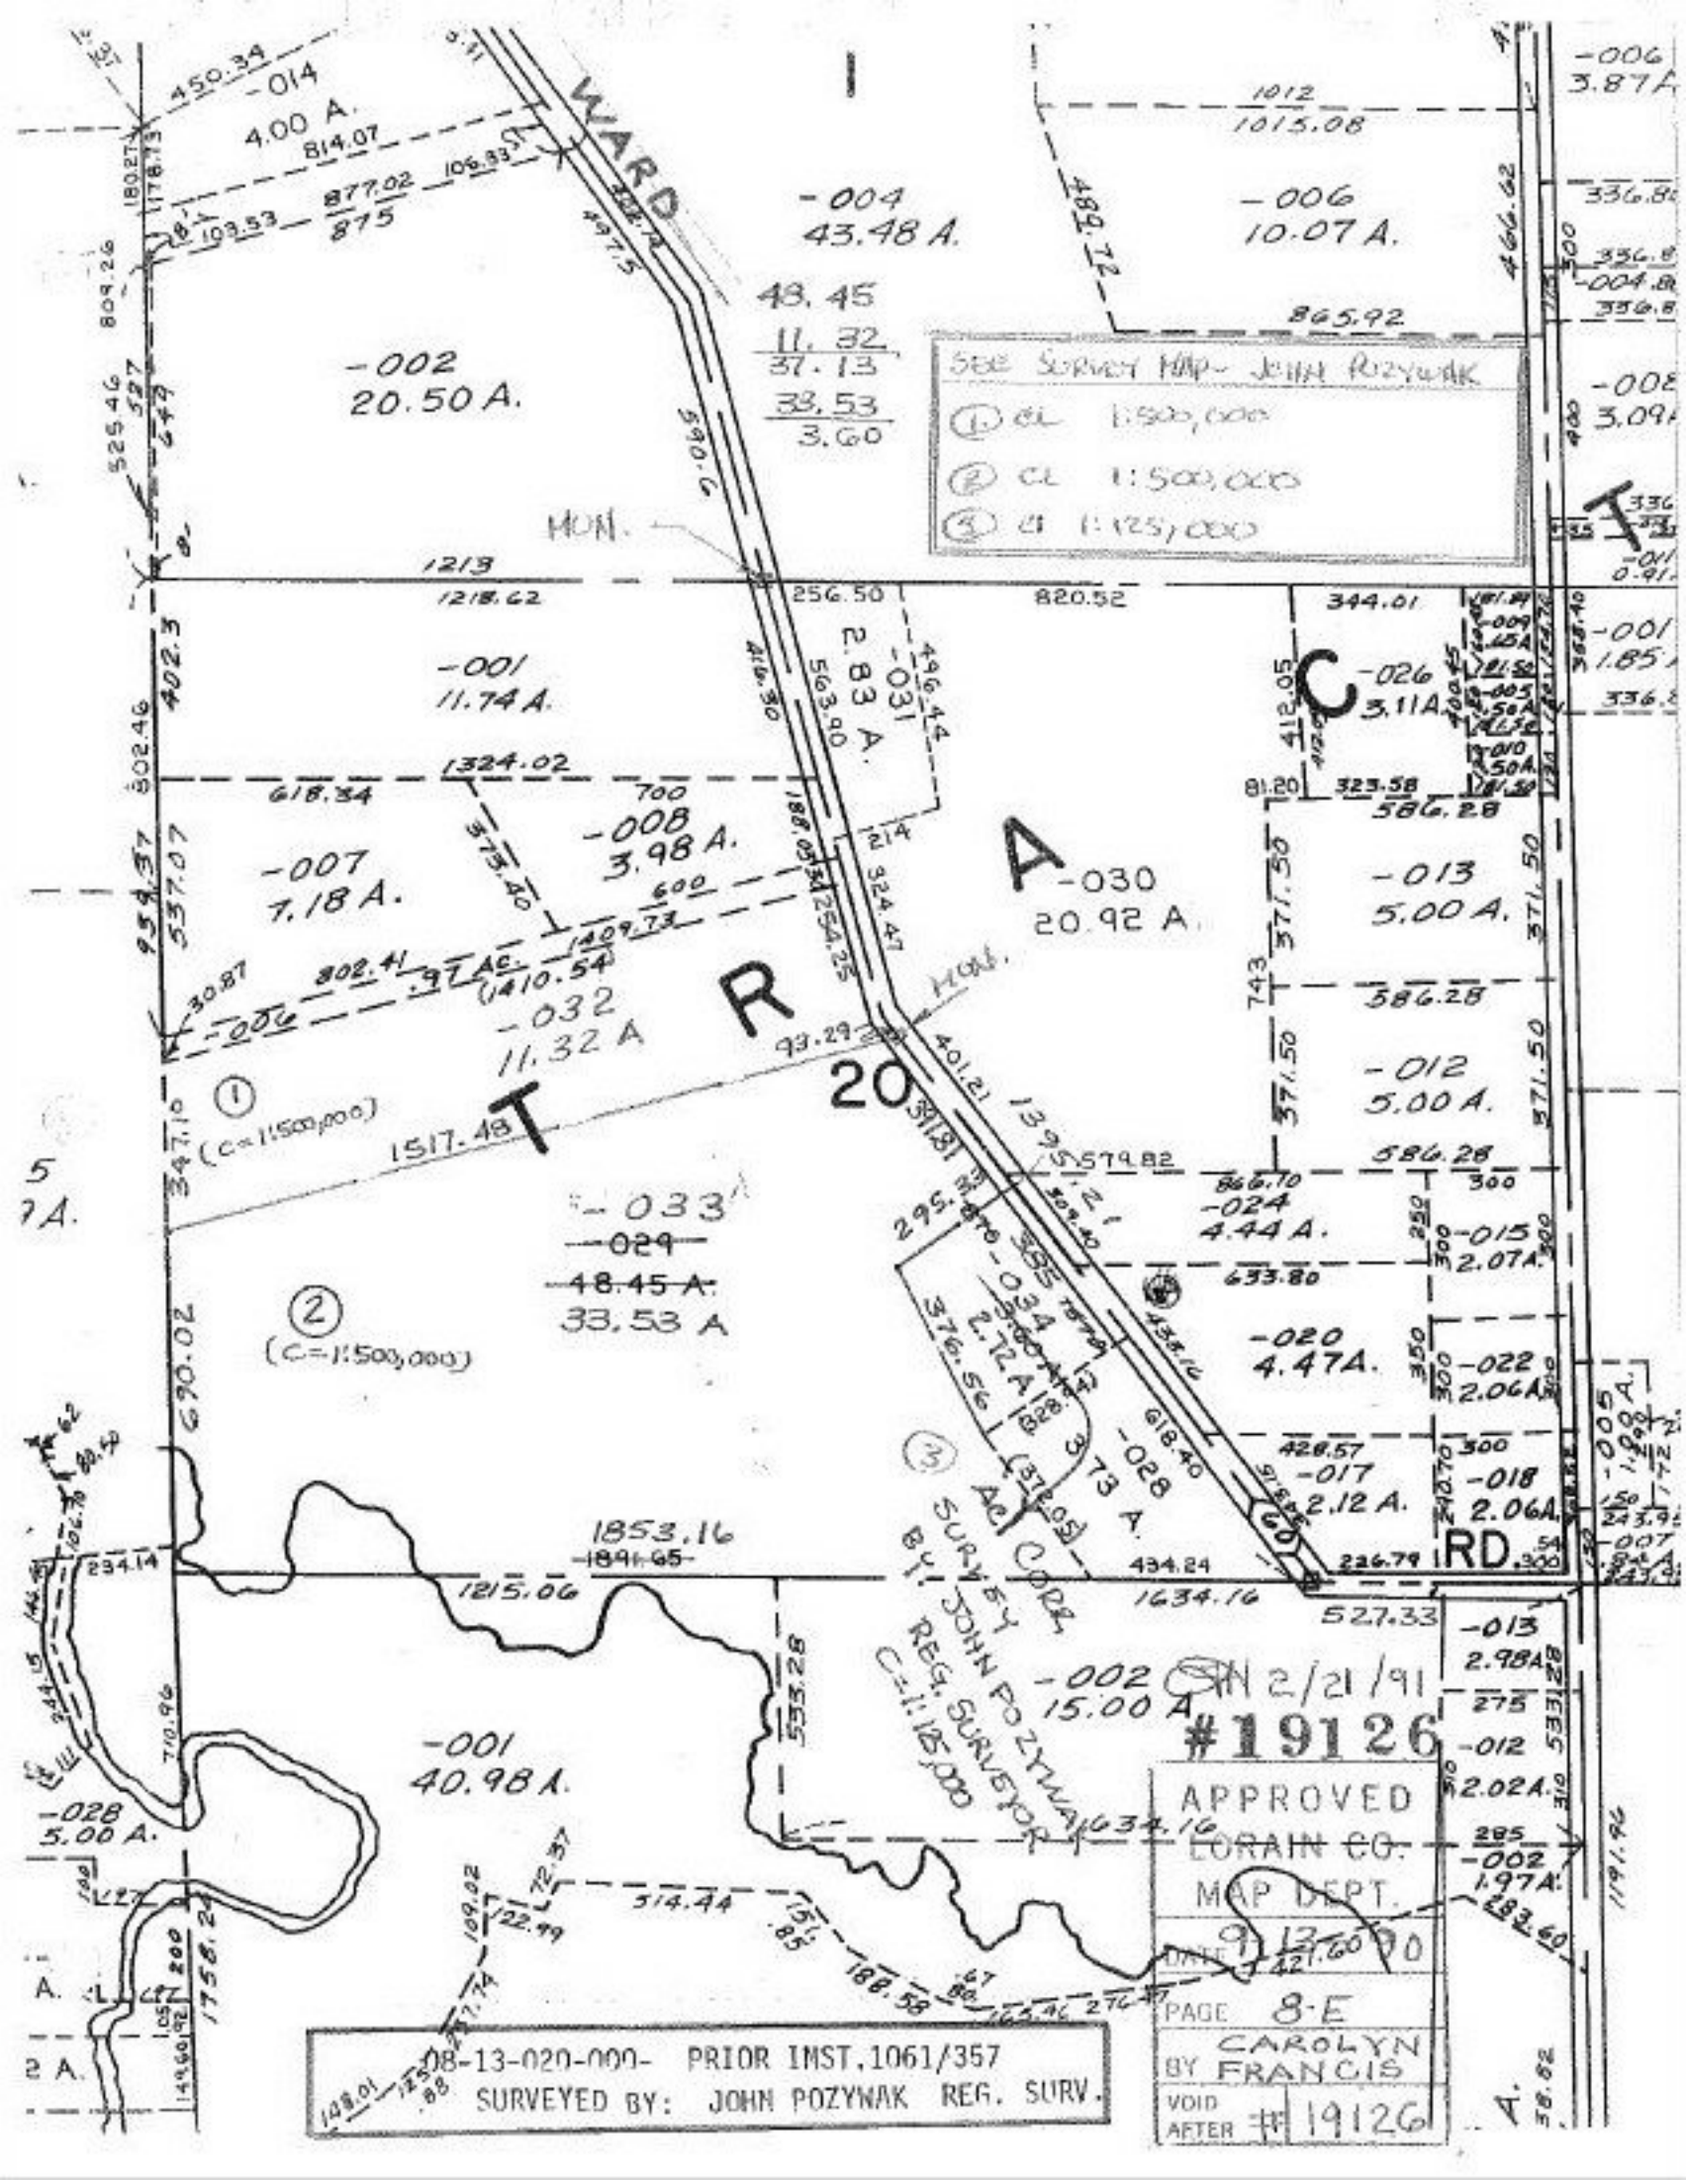

WARD
TRACT
20
RD.
SEE SURVEY MAP - JOHN POZYWAK
① CL 1:500,000
② CL 1:500,000
③ CL 1:125,000
-014 4.00 A.
-004 43.48 A.
-006 10.07 A.
-002 20.50 A.
-001 11.74 A.
-008 3.98 A.
-007 7.18 A.
-030 20.92 A.
-013 5.00 A.
-012 5.00 A.
-032 11.32 A
-033 -029 48.45 A. 33.53 A
-024 4.44 A.
-015 2.07 A.
-020 4.47 A.
-022 2.06 A.
-017 2.12 A.
-018 2.06 A.
-002 15.00 A
-001 40.98 A.
-028 5.00 A.
-026 3.11 A.
-031 2.83 A.
-034 2.72 A.
-028 3.73 A.
-013 2.98 A.
-012 2.02 A.
-002 1.97 A.
-006 3.87 A.
-008 3.09 A.
-001 1.85 A.
MON.
AC CORP.
SURVEY BY: JOHN POZYWAK REG. SURVEYOR C=1:125,000
(C=1:500,000)
(C=1:500,000)
08-13-020-000- PRIOR INST.1061/357
SURVEYED BY: JOHN POZYWAK REG. SURV.
SN 2/21/91
#19126
APPROVED
LORAIN CO.
MAP DEPT.
DATE 9-13-90
PAGE 8-E
BY CAROLYN FRANCIS
VOID AFTER # 19126