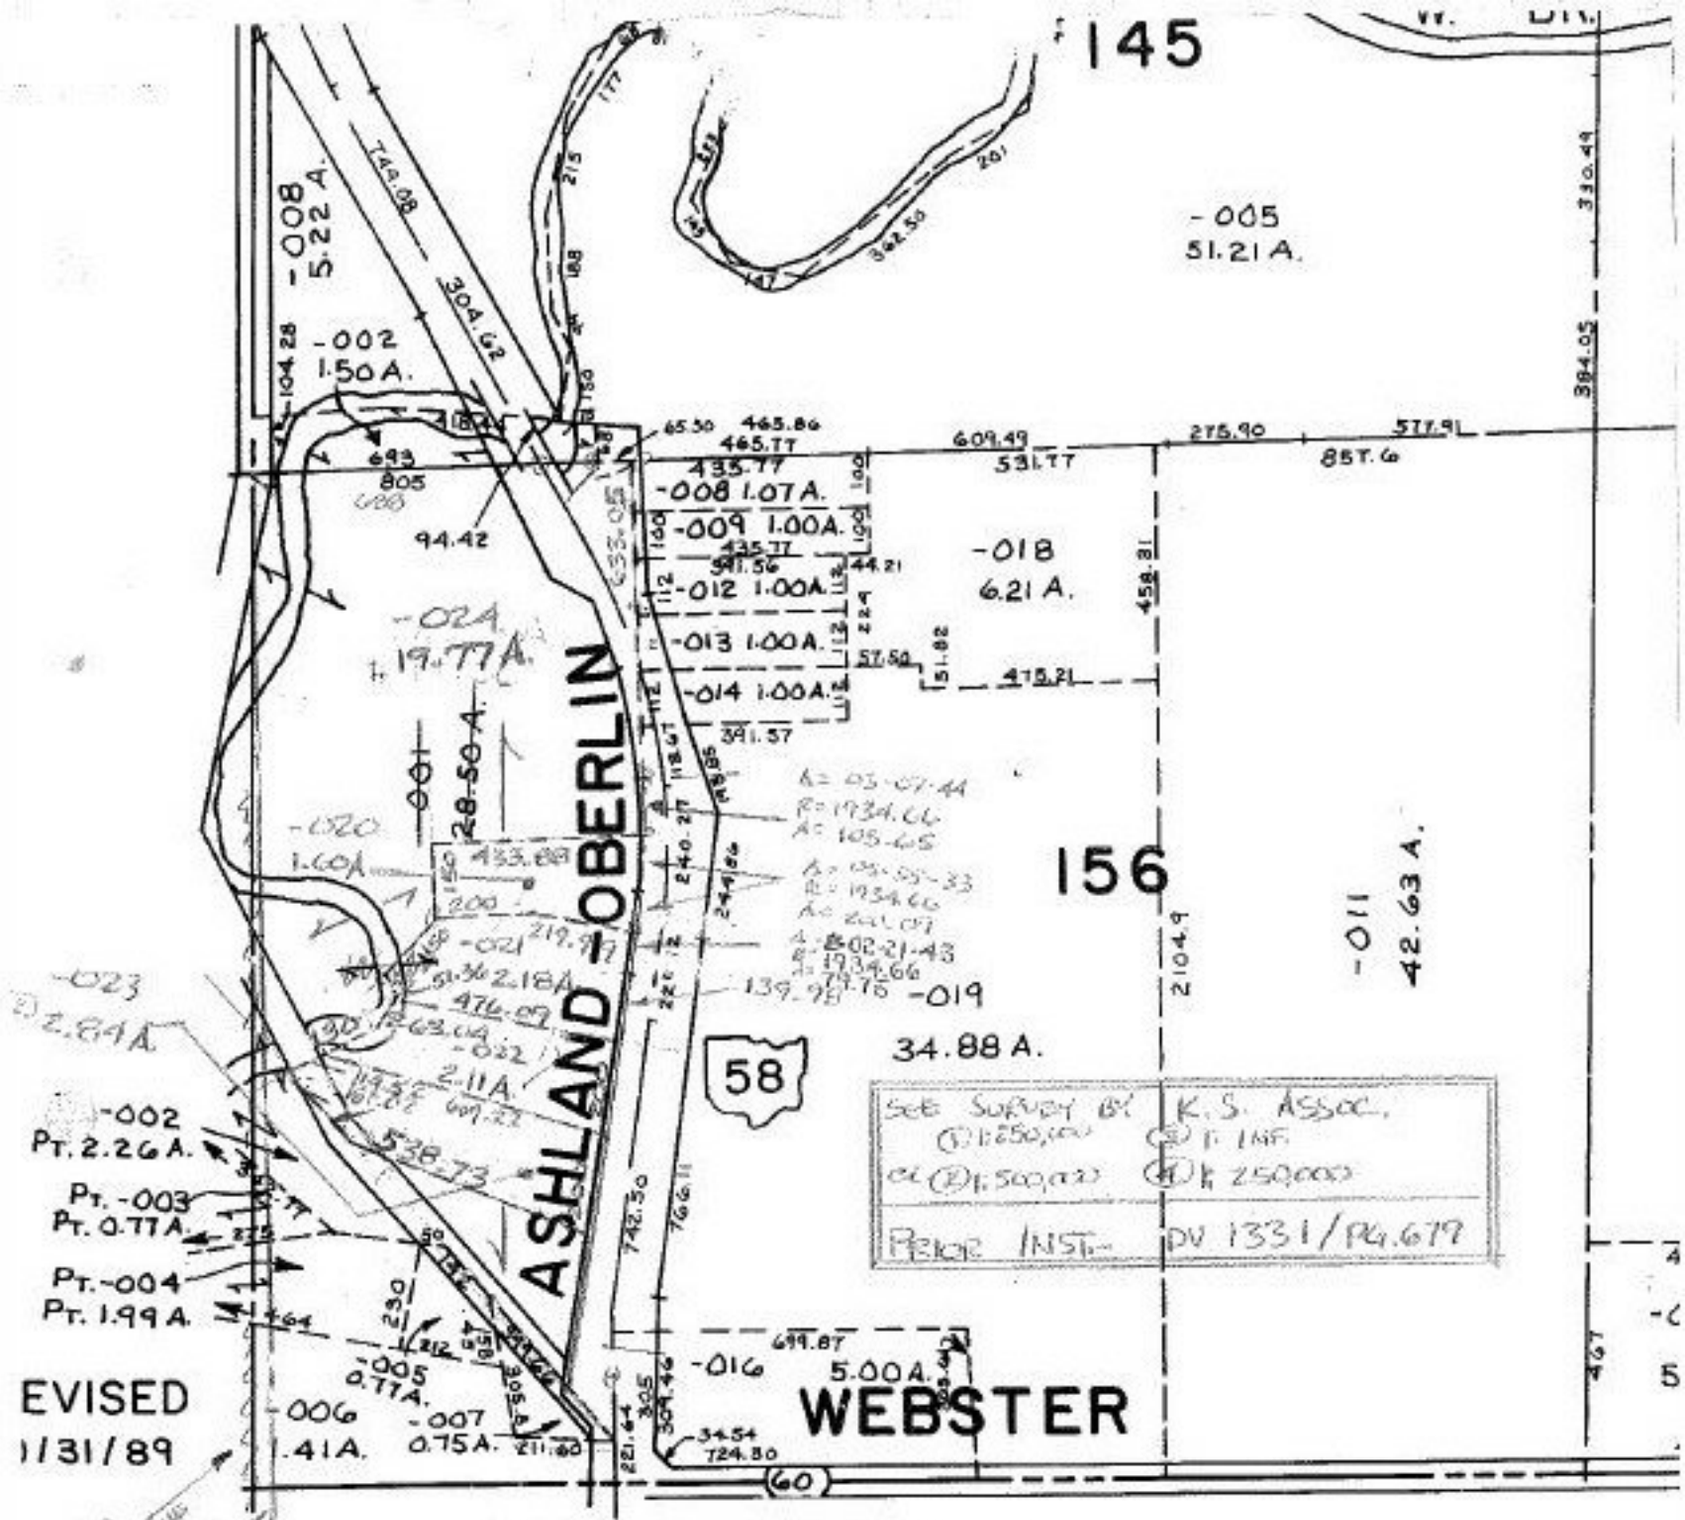
145
-005
51.21 A.
-008
5.22 A.
-002
1.50 A.
-018
6.21 A.
-009 1.00A.
-012 1.00A.
-013 1.00A.
-014 1.00A.
-008 1.07A.
-02A
19.77A.
28.50 A.
001
-020
1.60A
-021
2.18A
-022
2.11A
-023
2.64A.
-019
34.88 A.
156
-011
42.63 A.
58
ASHLAND-OBERLIN
WEBSTER
-016
5.00A.
-002
Pt. 2.26 A.
Pt. -003
Pt. 0.77A.
Pt. -004
Pt. 1.99 A.
-005
0.77A.
-006
1.41A.
-007
0.75A.
See Survey By
K.S. Assoc.
Prior Inst.-
DV 1331/Pg. 679
EVISED
1/31/89
OLD C.L. LINES
LOCATION OF RECORDED C.L. LINES
PITTSFIELD TWP.
14-G
SCALE 1" = 400'
2/19/91
#19132
APPROVED
LORAIN CO.
MAP DEPT.
DATE 9-24-90
PAGE 14-G
BY T. McClain
VOID AFTER 19132