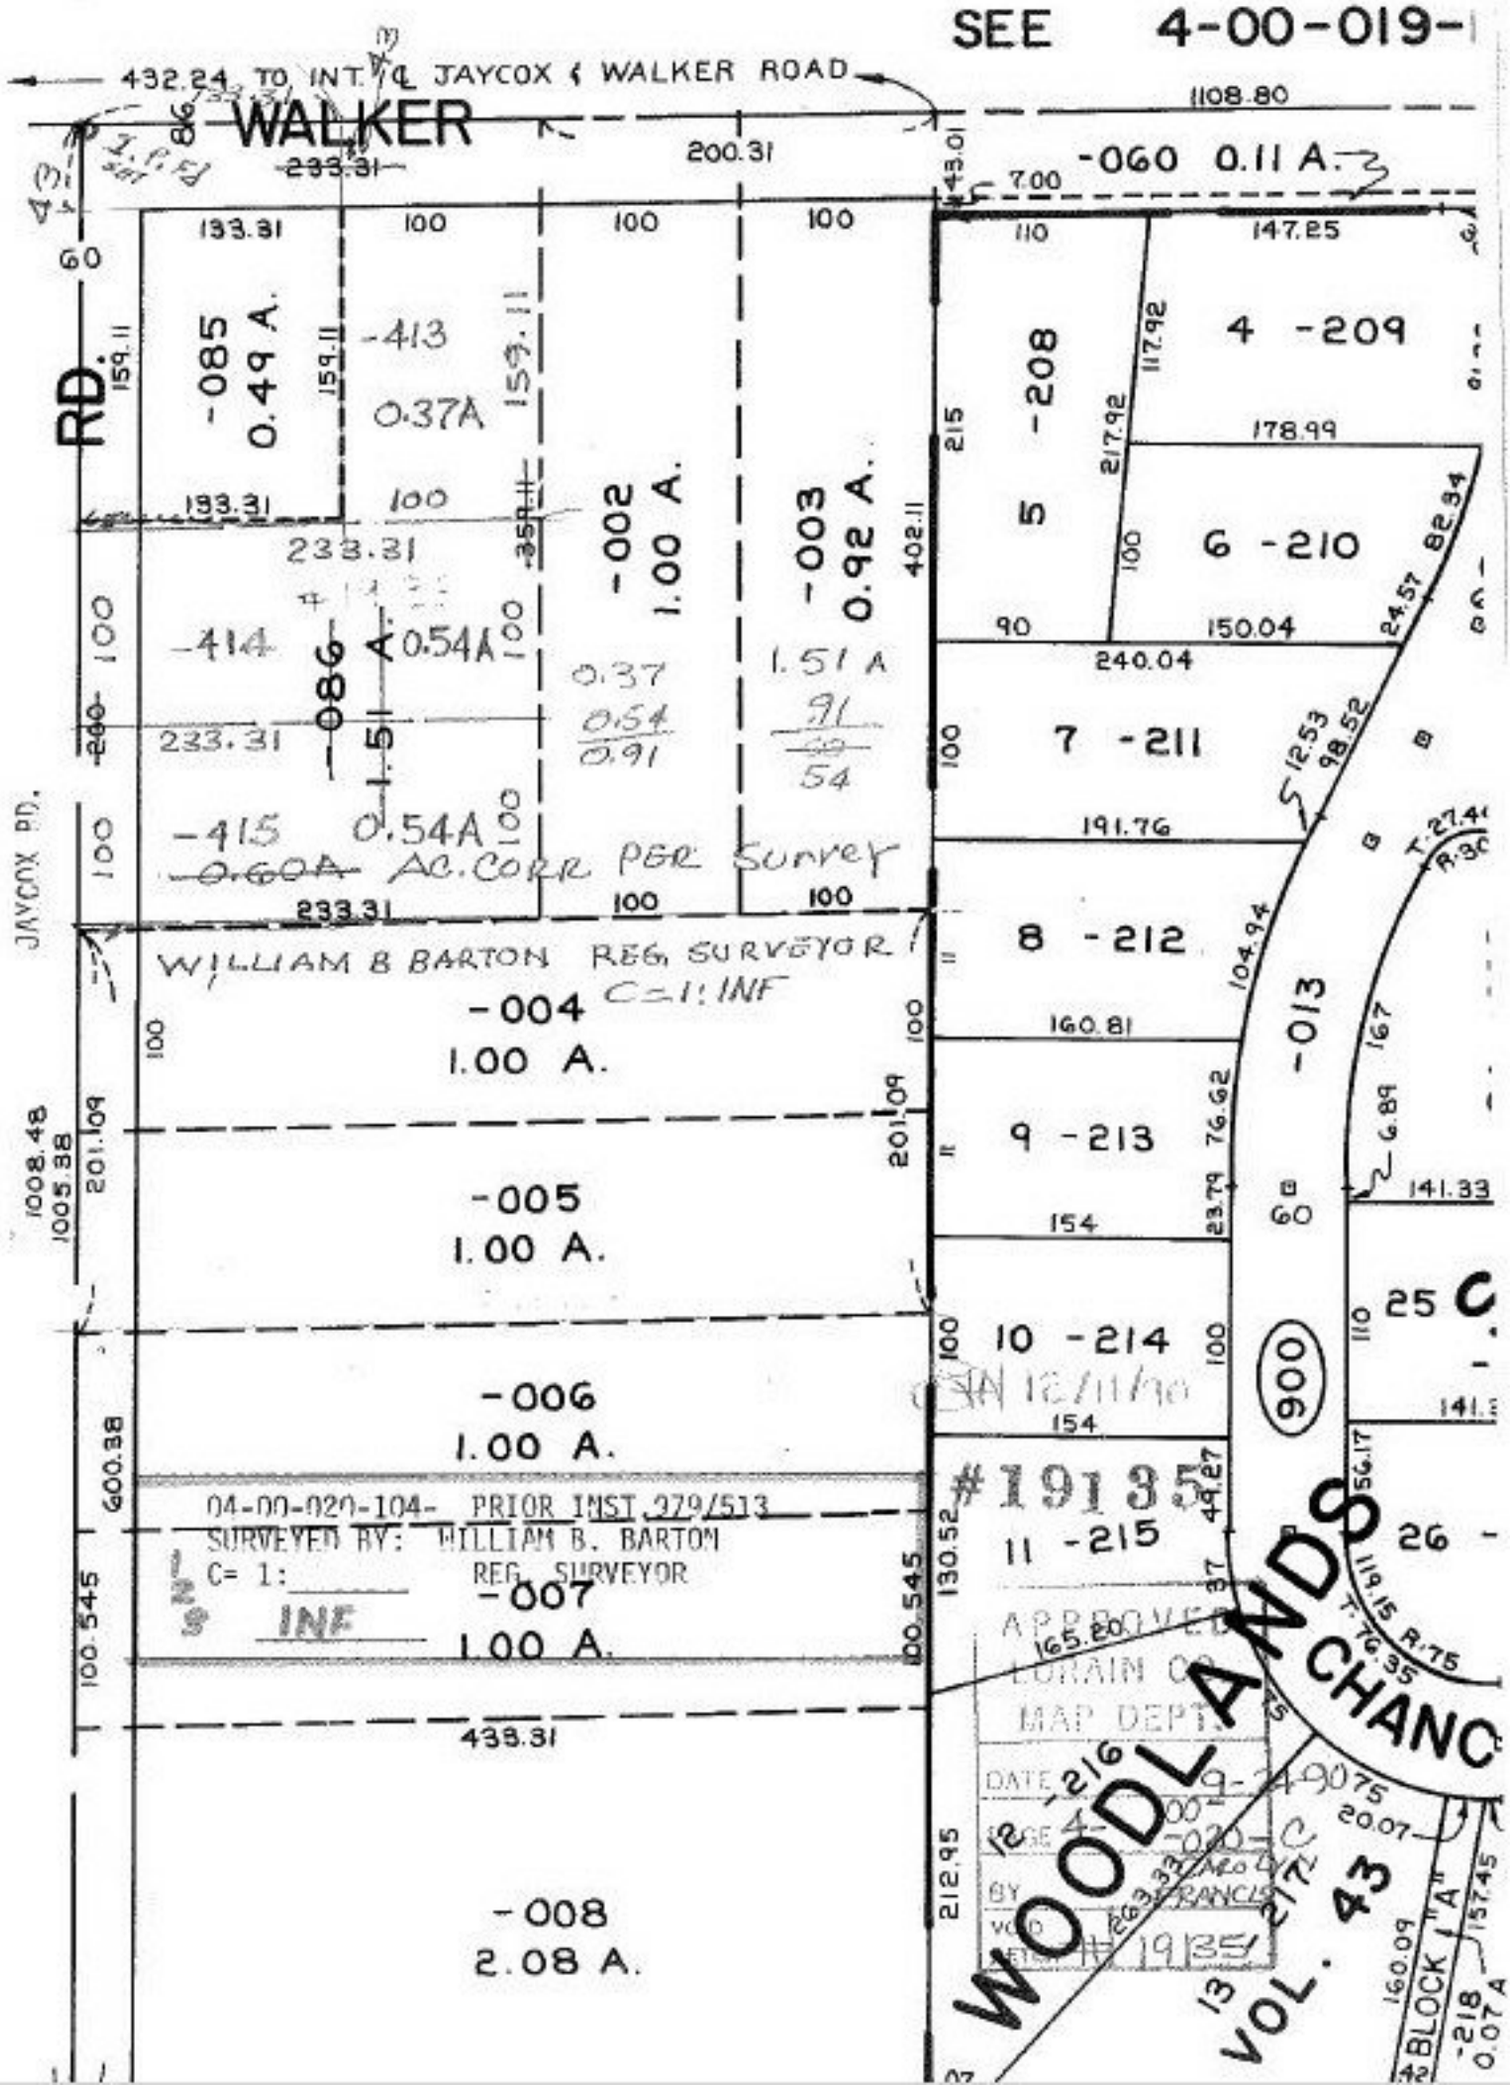
SEE 4-00-019-
432.24 TO INT. ℄ JAYCOX & WALKER ROAD
WALKER
RD.
JAYCOX RD.
-060 0.11 A.
-085 0.49 A.
-413 0.37A
-002 1.00 A.
-003 0.92 A.
-414 0.54A
-086 1.51 A.
-415 0.54A
0.60A AC. CORR PER SURVEY
WILLIAM B BARTON REG. SURVEYOR
C=1: INF
-004 1.00 A.
-005 1.00 A.
-006 1.00 A.
-007 1.00 A.
-008 2.08 A.
04-00-020-104- PRIOR INST. 979/513
SURVEYED BY: WILLIAM B. BARTON
C= 1: REG. SURVEYOR
INF
4 -209
5 -208
6 -210
7 -211
8 -212
9 -213
10 -214
11 -215
-013
900
25
26
#19135
APPROVED
LORAIN CO.
MAP DEPT.
DATE 9-24-90
PAGE 4-00-020-C
BY
VOID
DETACH #19135
WOODLANDS CHANC
VOL. 43
BLOCK "A"
-218 0.07 A