05-00-024-103-007 BOSS, THOMAS V 8/19/77
5-00-024-B
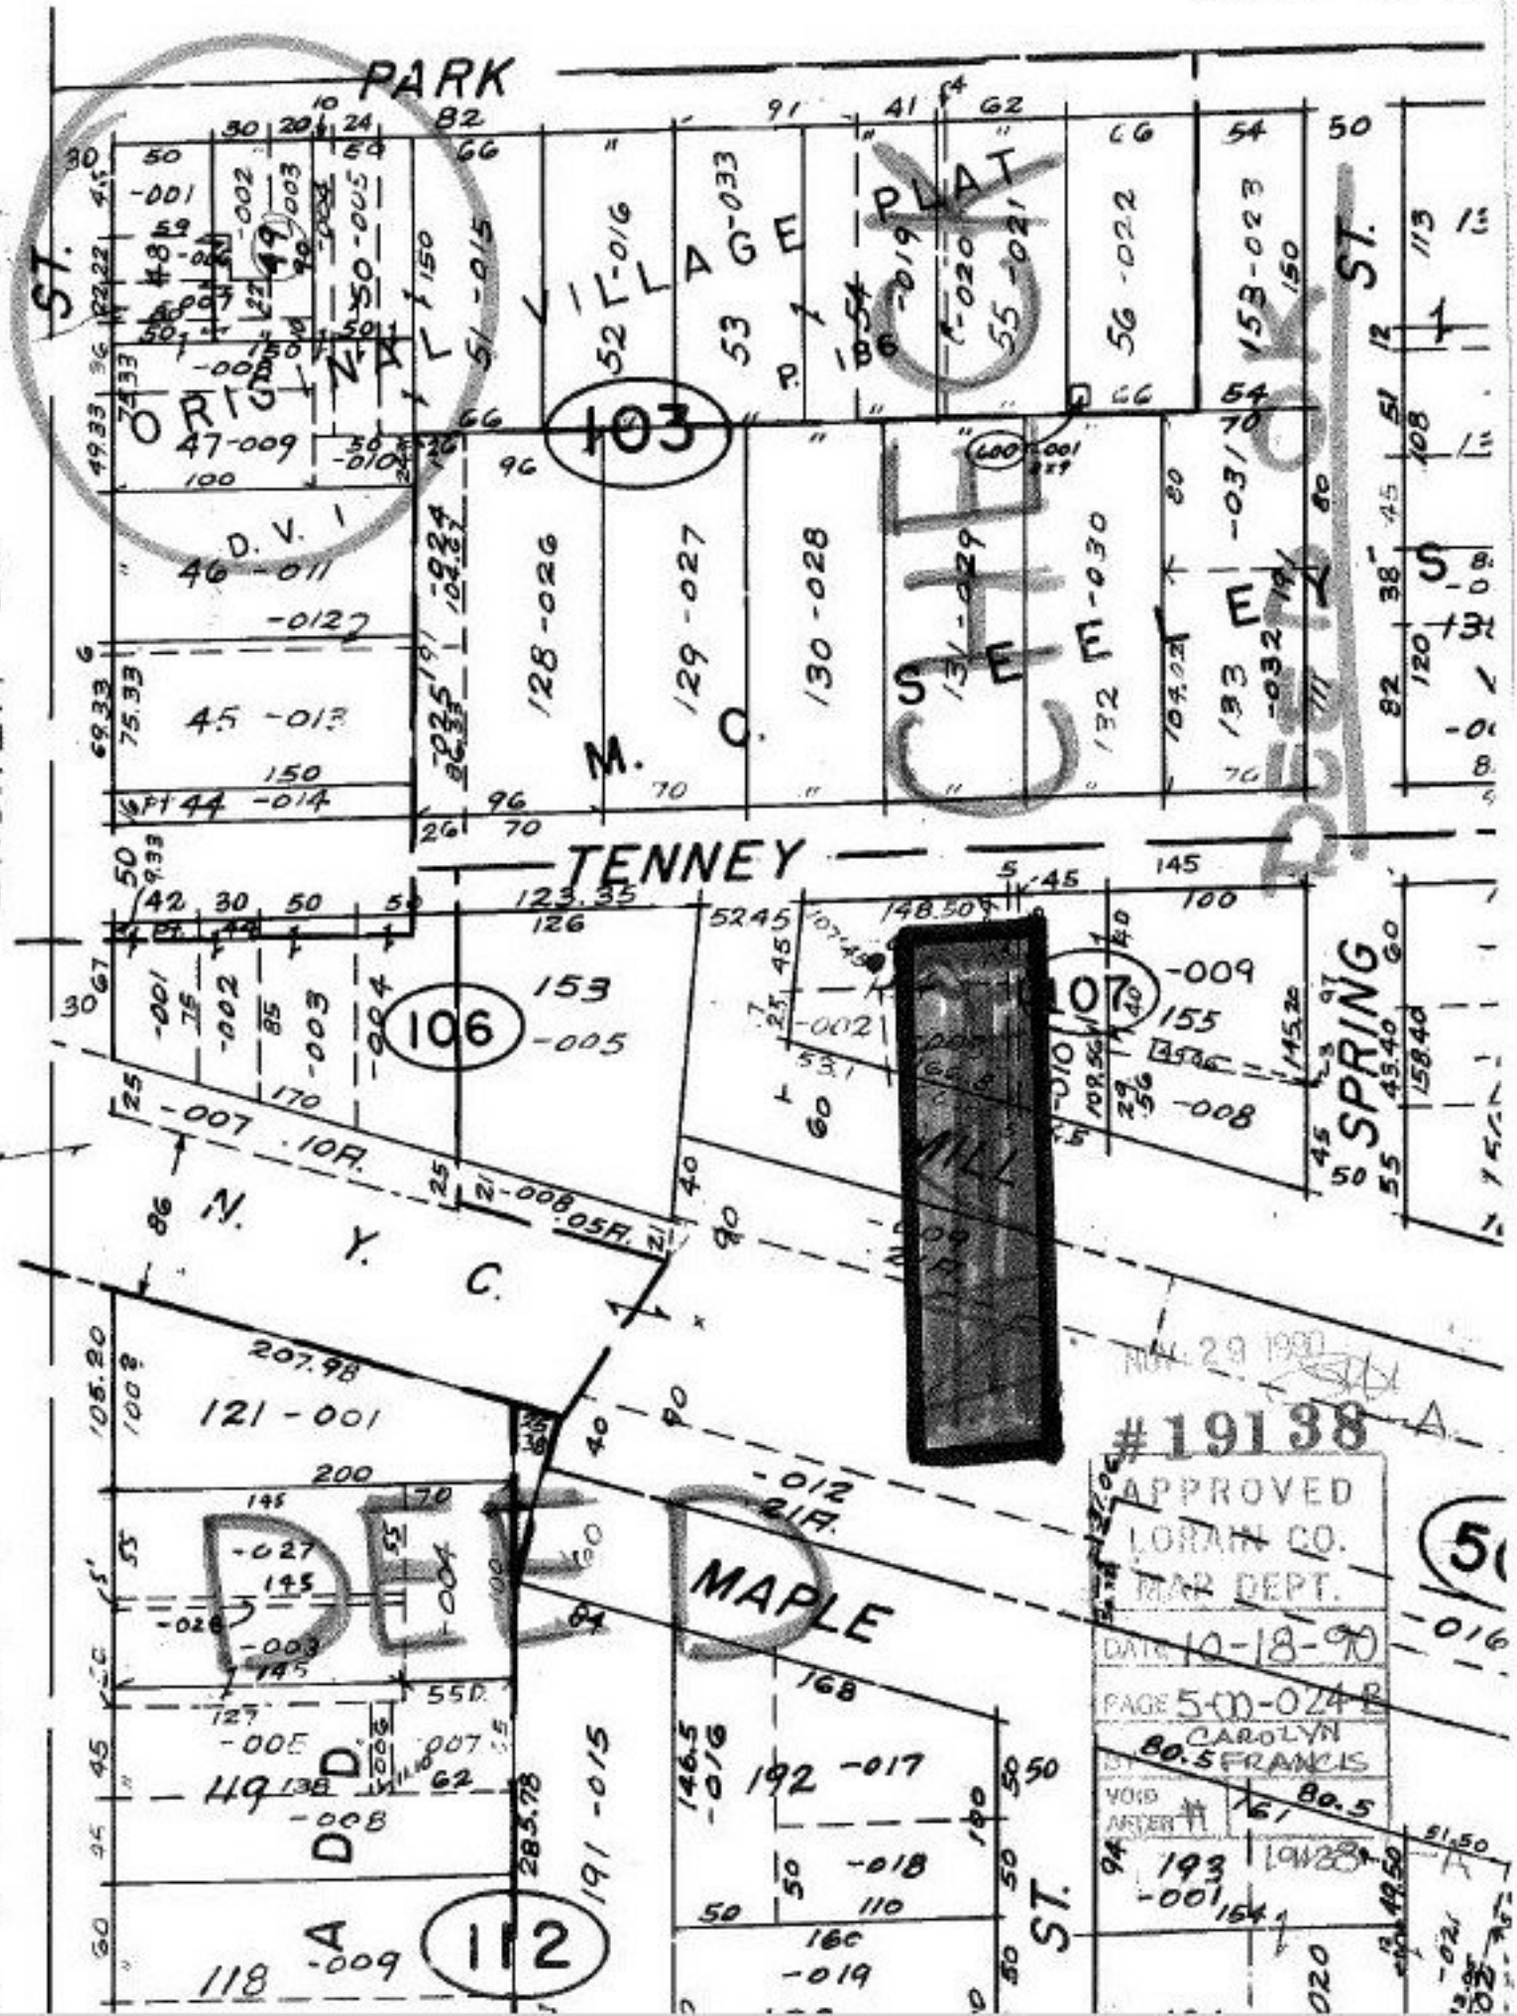
SEE 5-0