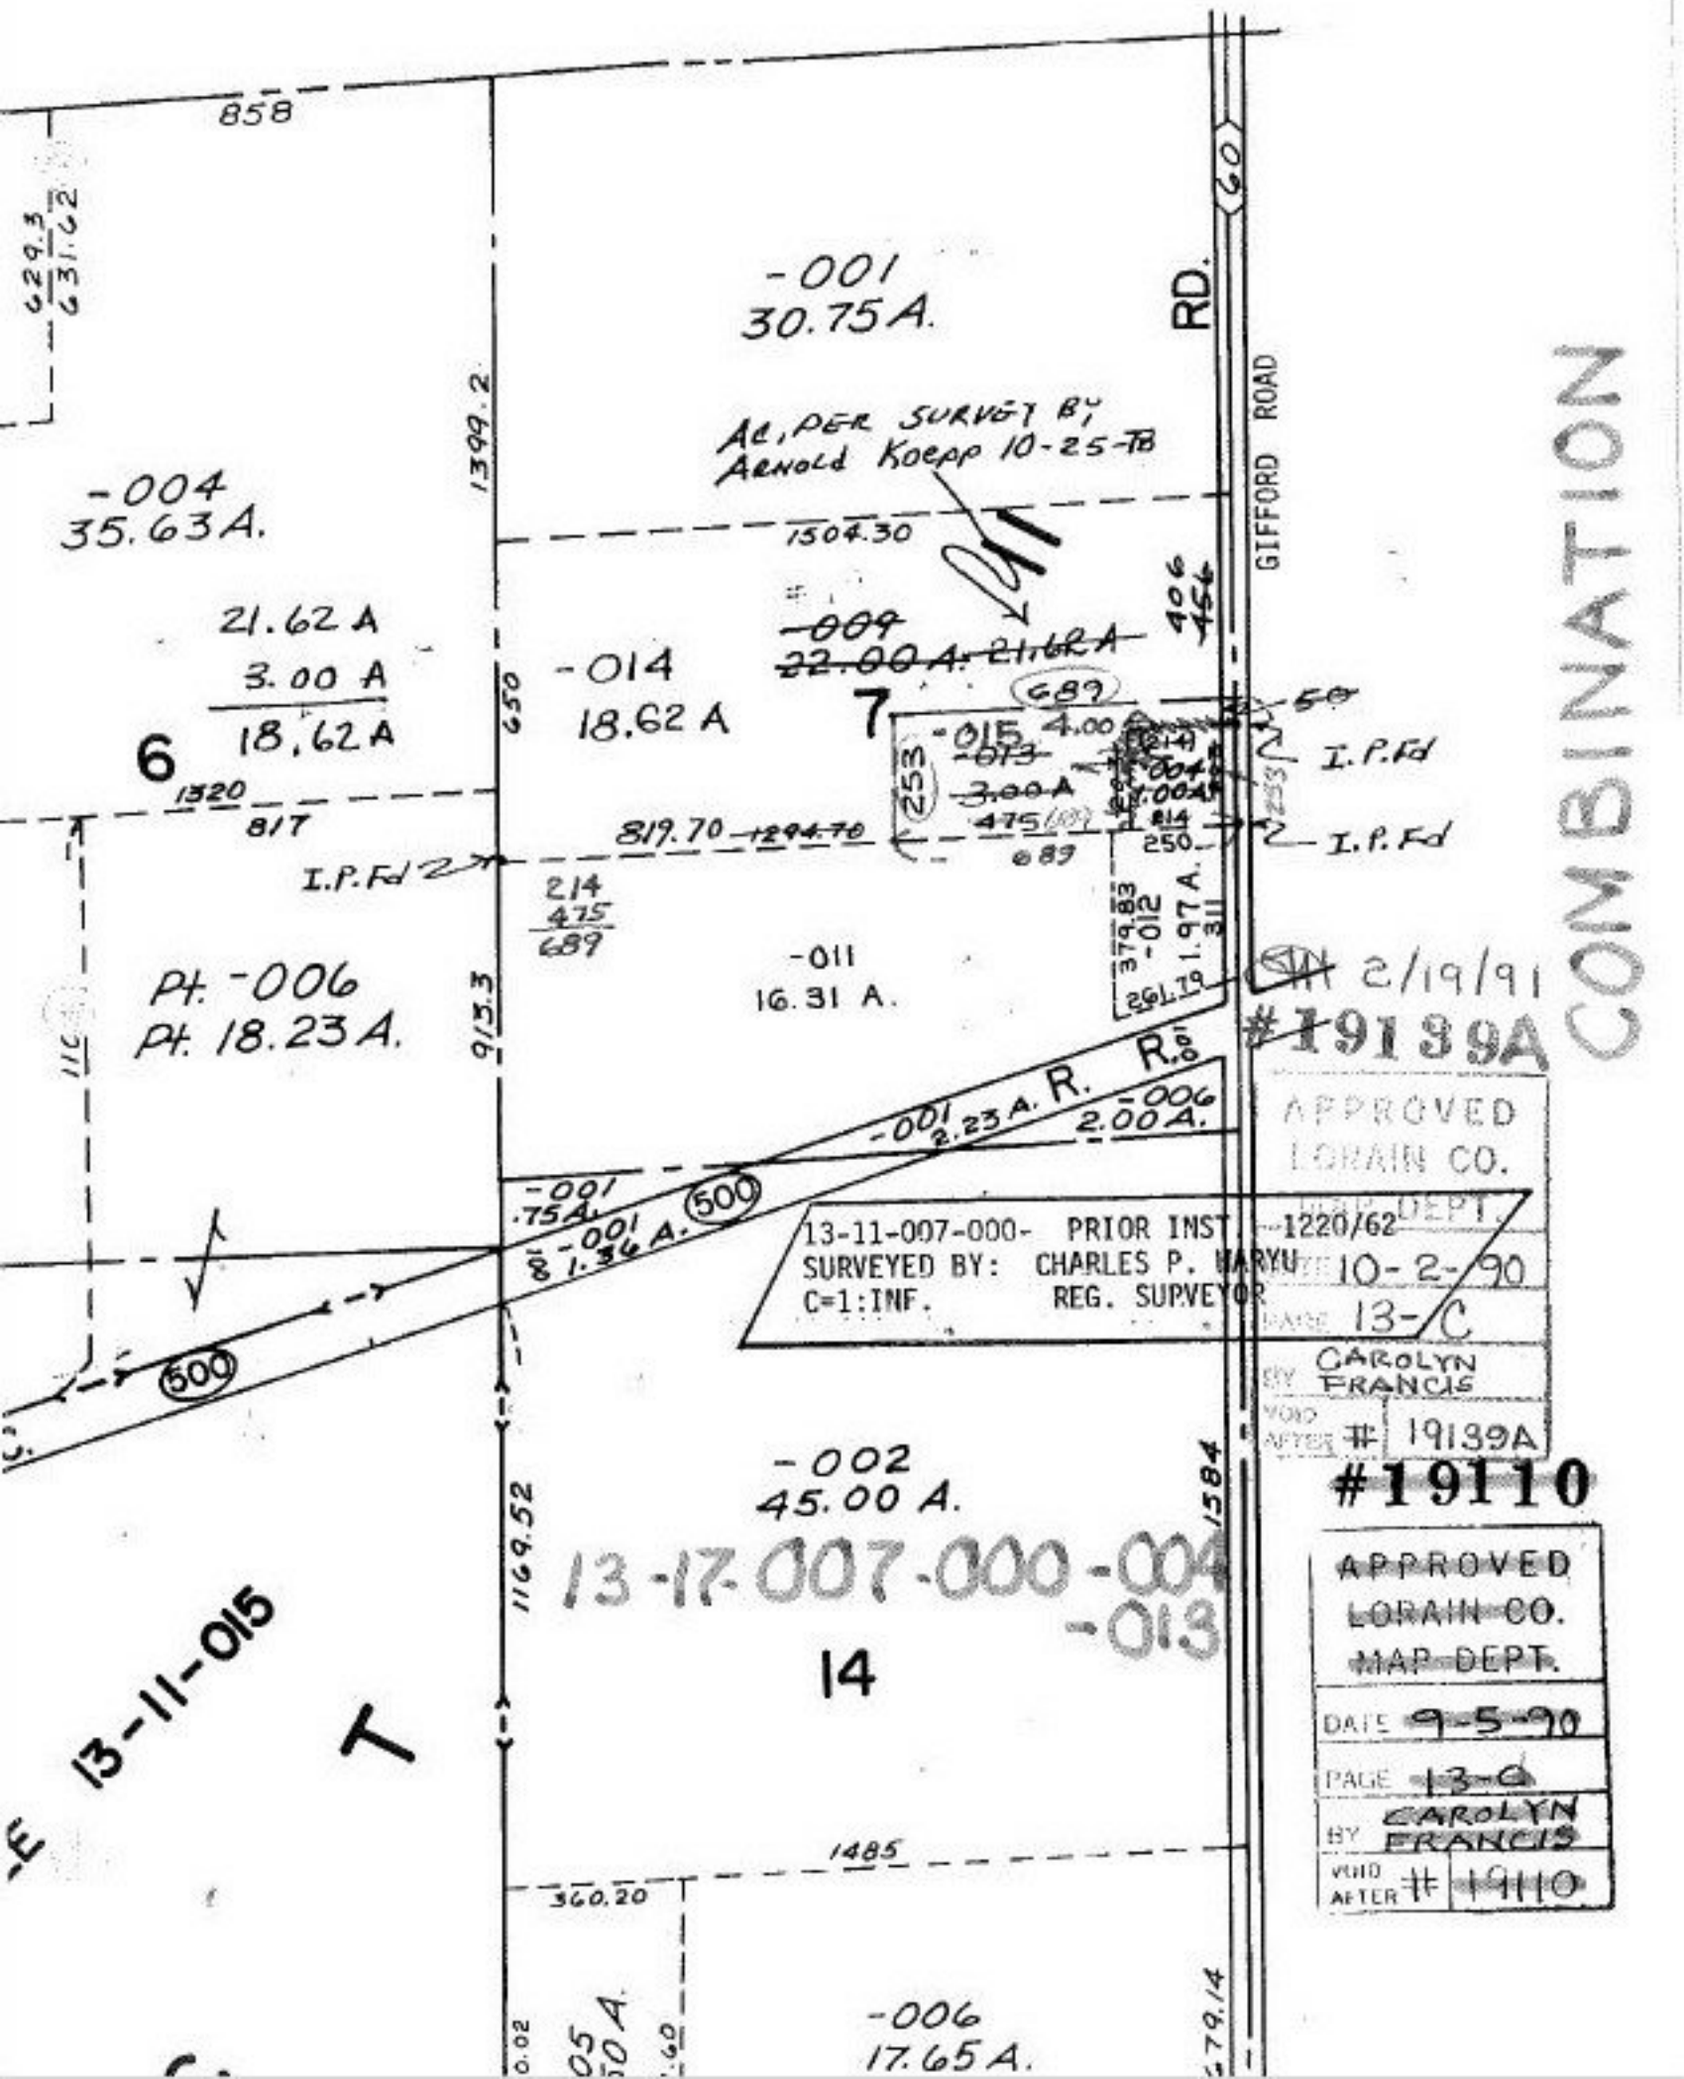

COMBINATION

2/19/91
#19139A

APPROVED
LORAIN CO.
MAP DEPT.

13-11-007-000- PRIOR INST. 1220/62
SURVEYED BY: CHARLES P. HARYU
C=1:INF. REG. SUPVEYOR

DATE 10-2-90
PAGE 13-C
BY CAROLYN FRANCIS
VOID AFTER # 19139A

#19110

APPROVED
LORAIN CO.
MAP DEPT.
DATE 9-5-90
PAGE 13-C
BY CAROLYN FRANCIS
VOID AFTER # 19110

13-17-007-000-004
-013